


I CERTIFY THAT THIS PLAT REPRESENTS
AN ACTUAL GROUND SURVEY AND THAT TO
THE BEST OF MY KNOWLEDGE NO ENCROACHMENTS
EXIST EITHER WAY ACROSS ANY OF THE PROPERTY LINES,
EXCEPT AS SHOWN.

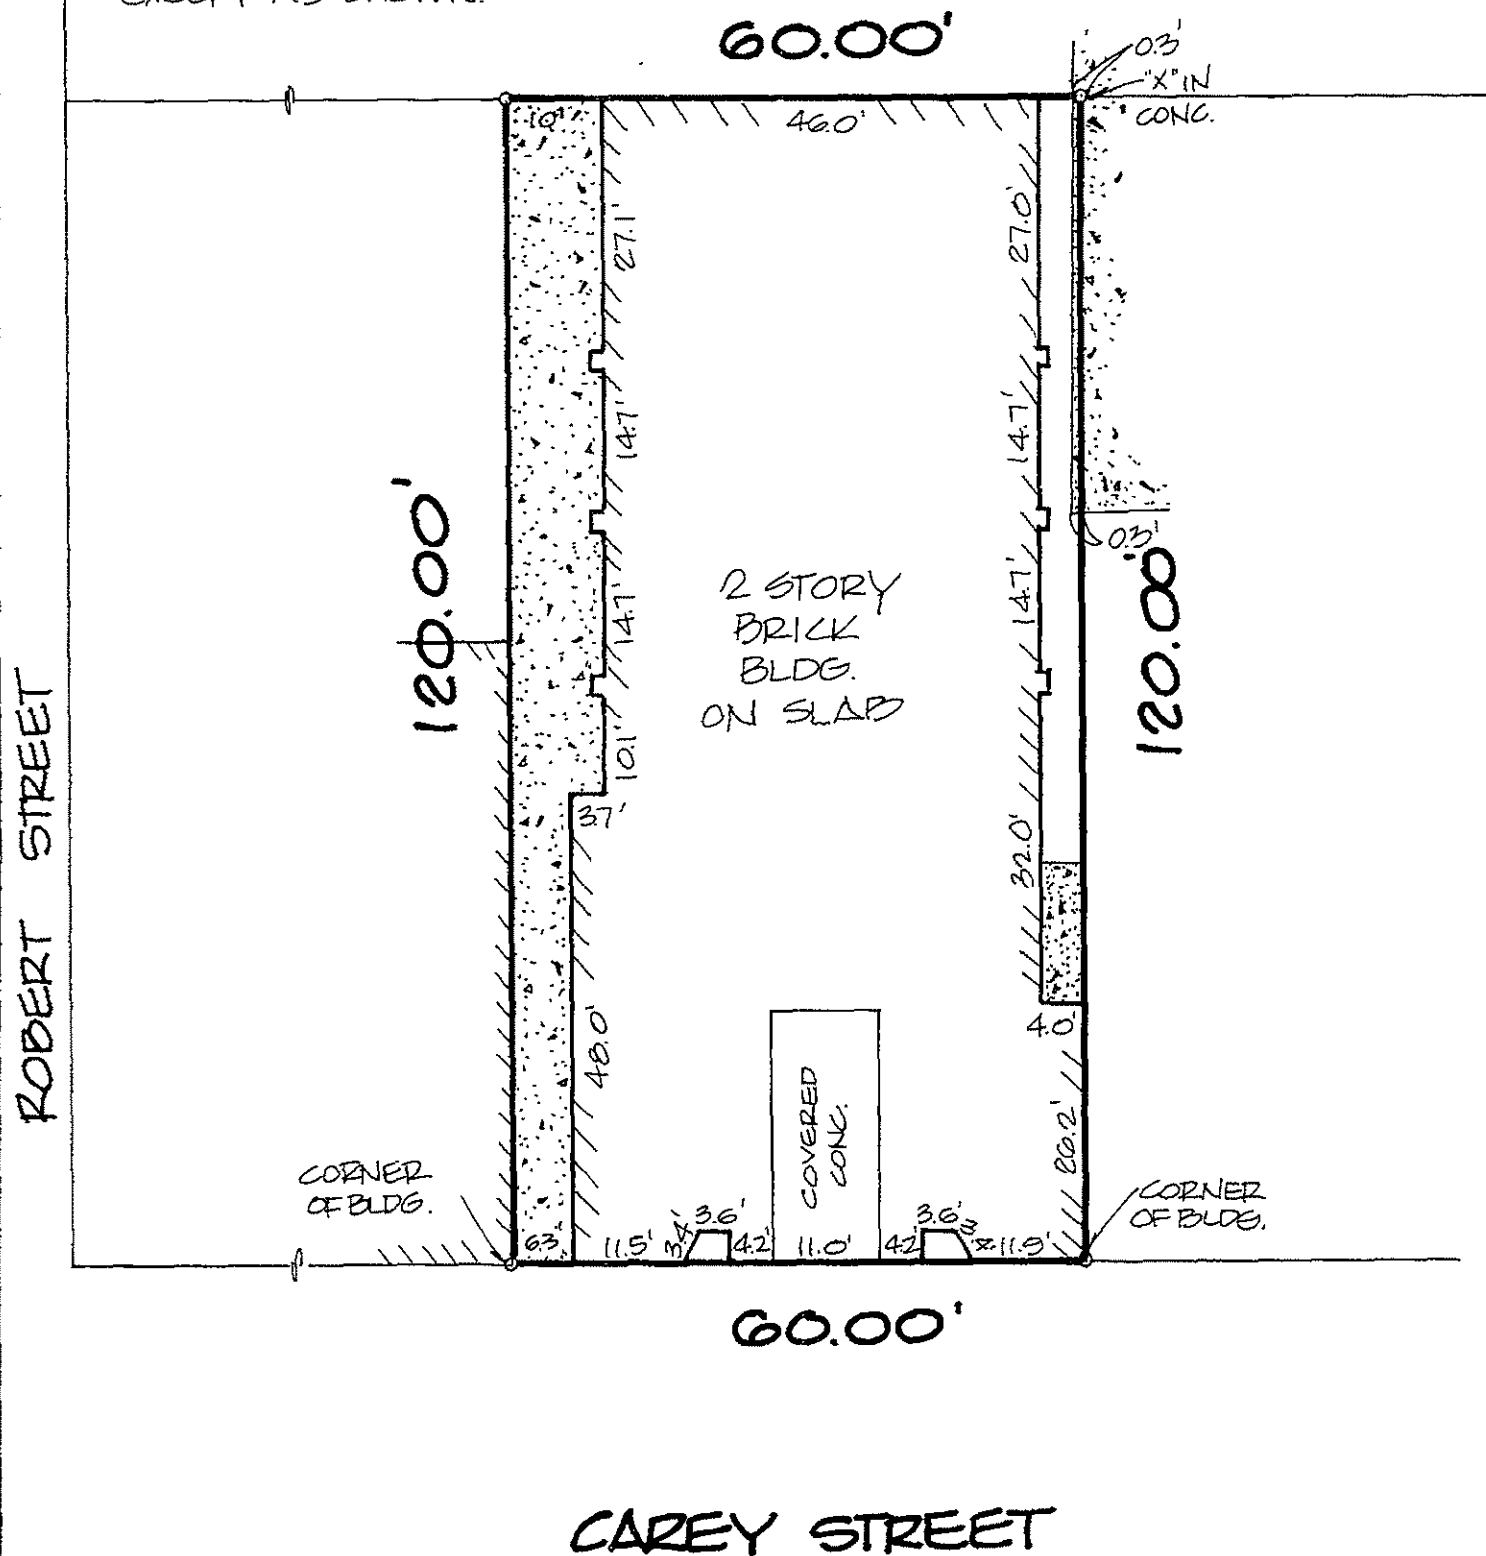

MUNICIPAL ADDRESS: 2247
2249 CAREY STREET
2251

PANEL 220204 0005 B
FLOOD HAZARD ZONE A4

SURVEY N° 940538

J. V. BURKES & ASSOC., INC.

DWN. BY: CAD

DATE: 5-13-1994

P.O. BOX 1568

SLIDELL, LA. 70459

SURVEY MAP OF: LOT 13 · SQ. A

LOCATED IN: TOWN OF SLIDELL

ST. TAMMANY PARISH, LA.

CERTIFIED TO:

VINTAGE SQUARE, INC.

SURVEYED BY:

J. V. BURKES III
LA. REG. N° 840
SLIDELL LA

SCALE: 1" = 20'