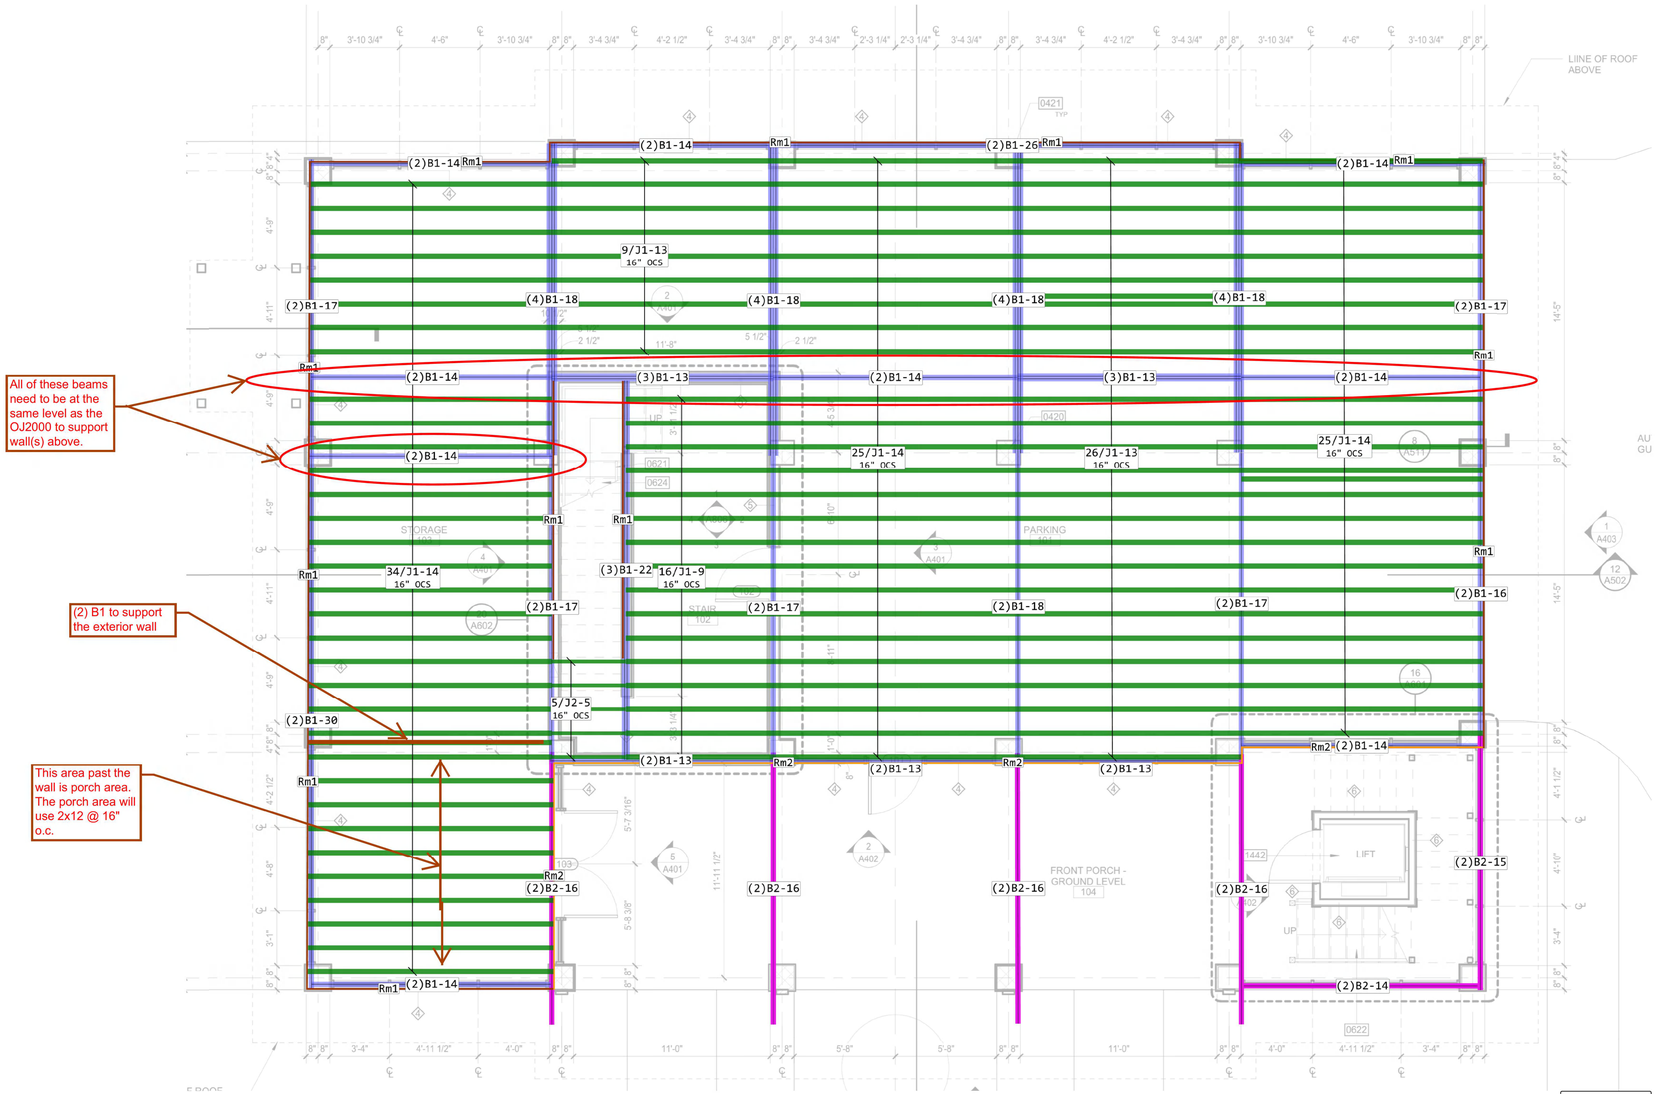

Tag		Len	Qty	Product	Cut Logic
Floor Joist					
	J1	14'	84	3 1/2"x16" OJ2000 4x2 #2	84x(1/14)
	J1	13'	35	3-1/2"x16" OJ2000 4x2 #2	35x(1/13)
	J1	9'	18	3-1/2"x16" OJ2000 4x2 #2	18x(1/9)
	J2	10'	2	2-1/2"x16" PWI 32S	2x(2/5)
	J2	6'	1	2-1/2"x16" PWI 32S	1x(1/5)
Beam					
	B1	30'	2	1-3/4"x16" PWT™ LVL	2x(1/30)
	B1	26'	2	1-3/4"x16" PWT™ LVL	2x(1/26)
	B1	22'	3	1-3/4"x16" PWT™ LVL	3x(1/22)
	B1	18'	28	1-3/4"x16" PWT™ LVL	18x(1/18) 10x(1/17)
	B1	16'	2	1-3/4"x16" PWT™ LVL	2x(1/16)
	B1	14'	30	1-3/4"x16" PWT™ LVL	18x(1/14) 12x(1/13)
	B2	16'	10	1-3/4"x16" PWT™ Treated LVL	8x(1/16) 2x(1/15)
	B2	14'	2	1-3/4"x16" PWT™ Treated LVL	2x(1/14)
Rim					
	Rm1	R/L	212	1-1/8"x16" Tolko OSB Rim Board Plus	
	Rm2	R/L	73	1-1/8"x16" Tolko T-TEC LSL Rim Board	

SHOP DRAWING / SUBMITTAL REVIEW

☐ RECEIVED ☒ RECEIVED AS NOTED

☐ REVISE AND RESUBMIT ☐ REJECTED

Project No.:_____ Submittal No.: _____

Corrections or comments made on the shop drawings during this review do not relieve the contractor from compliance with requirements of the drawings and specifications. This check is only for review of the general conformance with the design concept of the project and general compliance with the information given in the contract documents. This contractor is responsible for: confirming and coreating all quantities and dimensions; selecting fabrication processes and techniques of construction; coordinating his or her work with that and other trades and performing all in a safe and satisfactory maner.

By: David Dammon Date: 5/1/2024

DAMMON ENGINEERING, INC.
Slidell, LA

U.S. LUMBER an SBP brand

202403-55338
Case Residence
34159 Lowry Lane
Slidell, Louisiana 70460

1st Flr

These placement plans for the products specified were based on the information provided to us. This service is solely intended for product application assurance; it is not intended to circumvent the need for a design professional as determined by the building codes. The designer of record and/or builder/framer is responsible to assure these drawings are compatible with the overall project.

Roof Live Load (PSF): **20**
Roof Dead Load (PSF): **10**
Floor Load Deflection Criteria: **L/480**
Floor Live Load (PSF): **40**
Floor Dead Load (PSF): **10**
Estimator: **PBT**
Tracking: **55338**

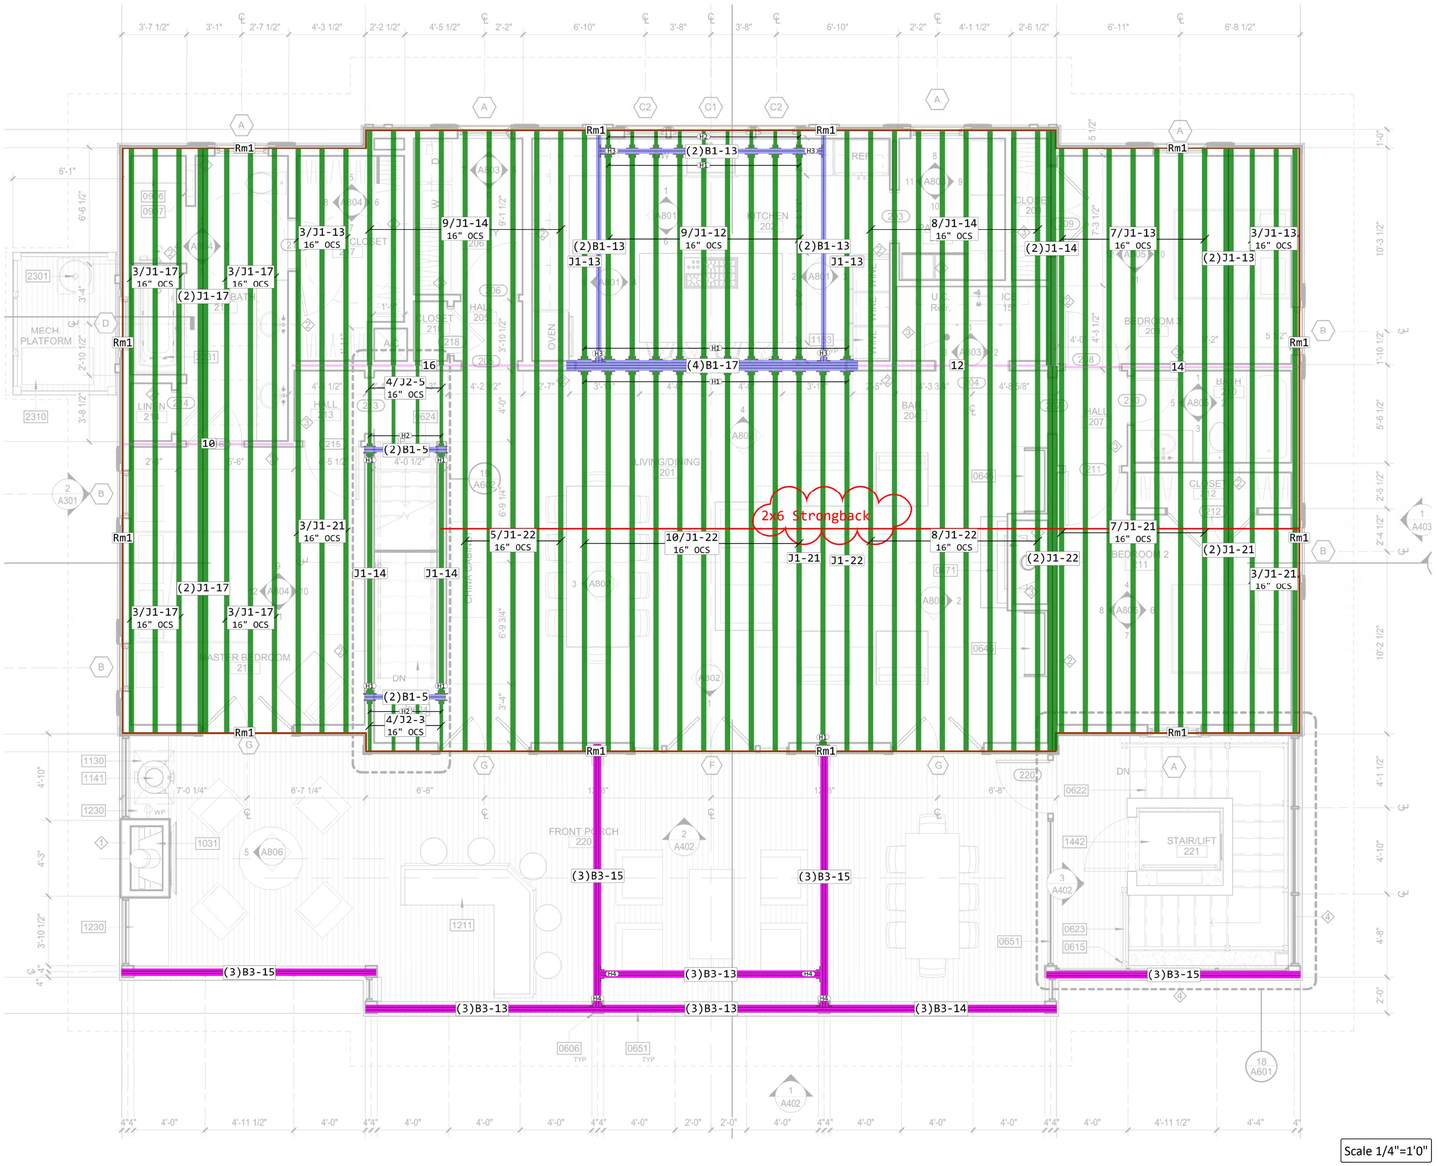

Tag	Len	Qty	Product	Cut Logic
Floor Joist				
J1	22'	26	3-1/2"x16" OJ2000 4x2 #2	26x(1/22)
J1	21'	16	3-1/2"x16" OJ2000 4x2 #2	16x(1/21)
J1	17'	16	3-1/2"x16" OJ2000 4x2 #2	16x(1/17)
J1	14'	21	3-1/2"x16" OJ2000 4x2 #2	21x(1/14)
J1	13'	17	3-1/2"x16" OJ2000 4x2 #2	17x(1/13)
J1	12'	9	3-1/2"x16" OJ2000 4x2 #2	9x(1/12)
J2	10'	1	2-1/2"x16" PWI 32S	1x(2/5)
J2	8'	1	2-1/2"x16" PWI 32S	1x(1/3 1/5)
J2	6'	2	2-1/2"x16" PWI 32S	1x(2/3) 1x(1/5)
J2	4'	1	2-1/2"x16" PWI 32S	1x(1/1 1/3)
J2	2'	4	2-1/2"x16" PWI 32S	4x(2/1)
Beam				
B1	18'	4	1-3/4"x16" PWT™ LVL	4x(1/17)
B1	14'	6	1-3/4"x16" PWT™ LVL	6x(1/13)
B1	10'	2	1-3/4"x16" PWT™ LVL	2x(2/5)
B3	16'	12	1-3/4"x11-7/8" PWT™ Treated LVL	12x(1/15)
B3	14'	12	1-3/4"x11-7/8" PWT™ Treated LVL	3x(1/14) 9x(1/13)
Rim				
Rim1	R/L	222	1-1/8"x16" Tolko OSB Rim Board Plus	
Hanger				
H1		37	IUS3.56/16 Simpson Strong Tie	
H2		17	IUS2.56/16 Simpson Strong Tie	
H3		4	HGUS414 Simpson Strong Tie	
H4		4	HGUS5.50/12 Simpson Strong Tie	

U.S. LUMBER an SBP brand

202403-55338

Case Residence
34159 Lowry Lane
Slidell, Louisiana 70460

2nd Flr

These placement plans for the products specified were based on the information provided to us. This service is solely intended for product application assurance; it is not intended to circument ths need for a design professional as determined by the building codes. The designer of record and/or builder/framer is responsible to assure these drawings are compatible with the overall project.

Roof Live Load (PSF): **20**
Roof Dead Load (PSF): **10**
Floor Load Deflection Criteria: **L/480**
Floor Live Load (PSF): **40**
Floor Dead Load (PSF): **10**
Estimator: **PBT**
Tracking: **55338**