




EXISTING SITE PLAN
SCALE: 1" = 20'-0"

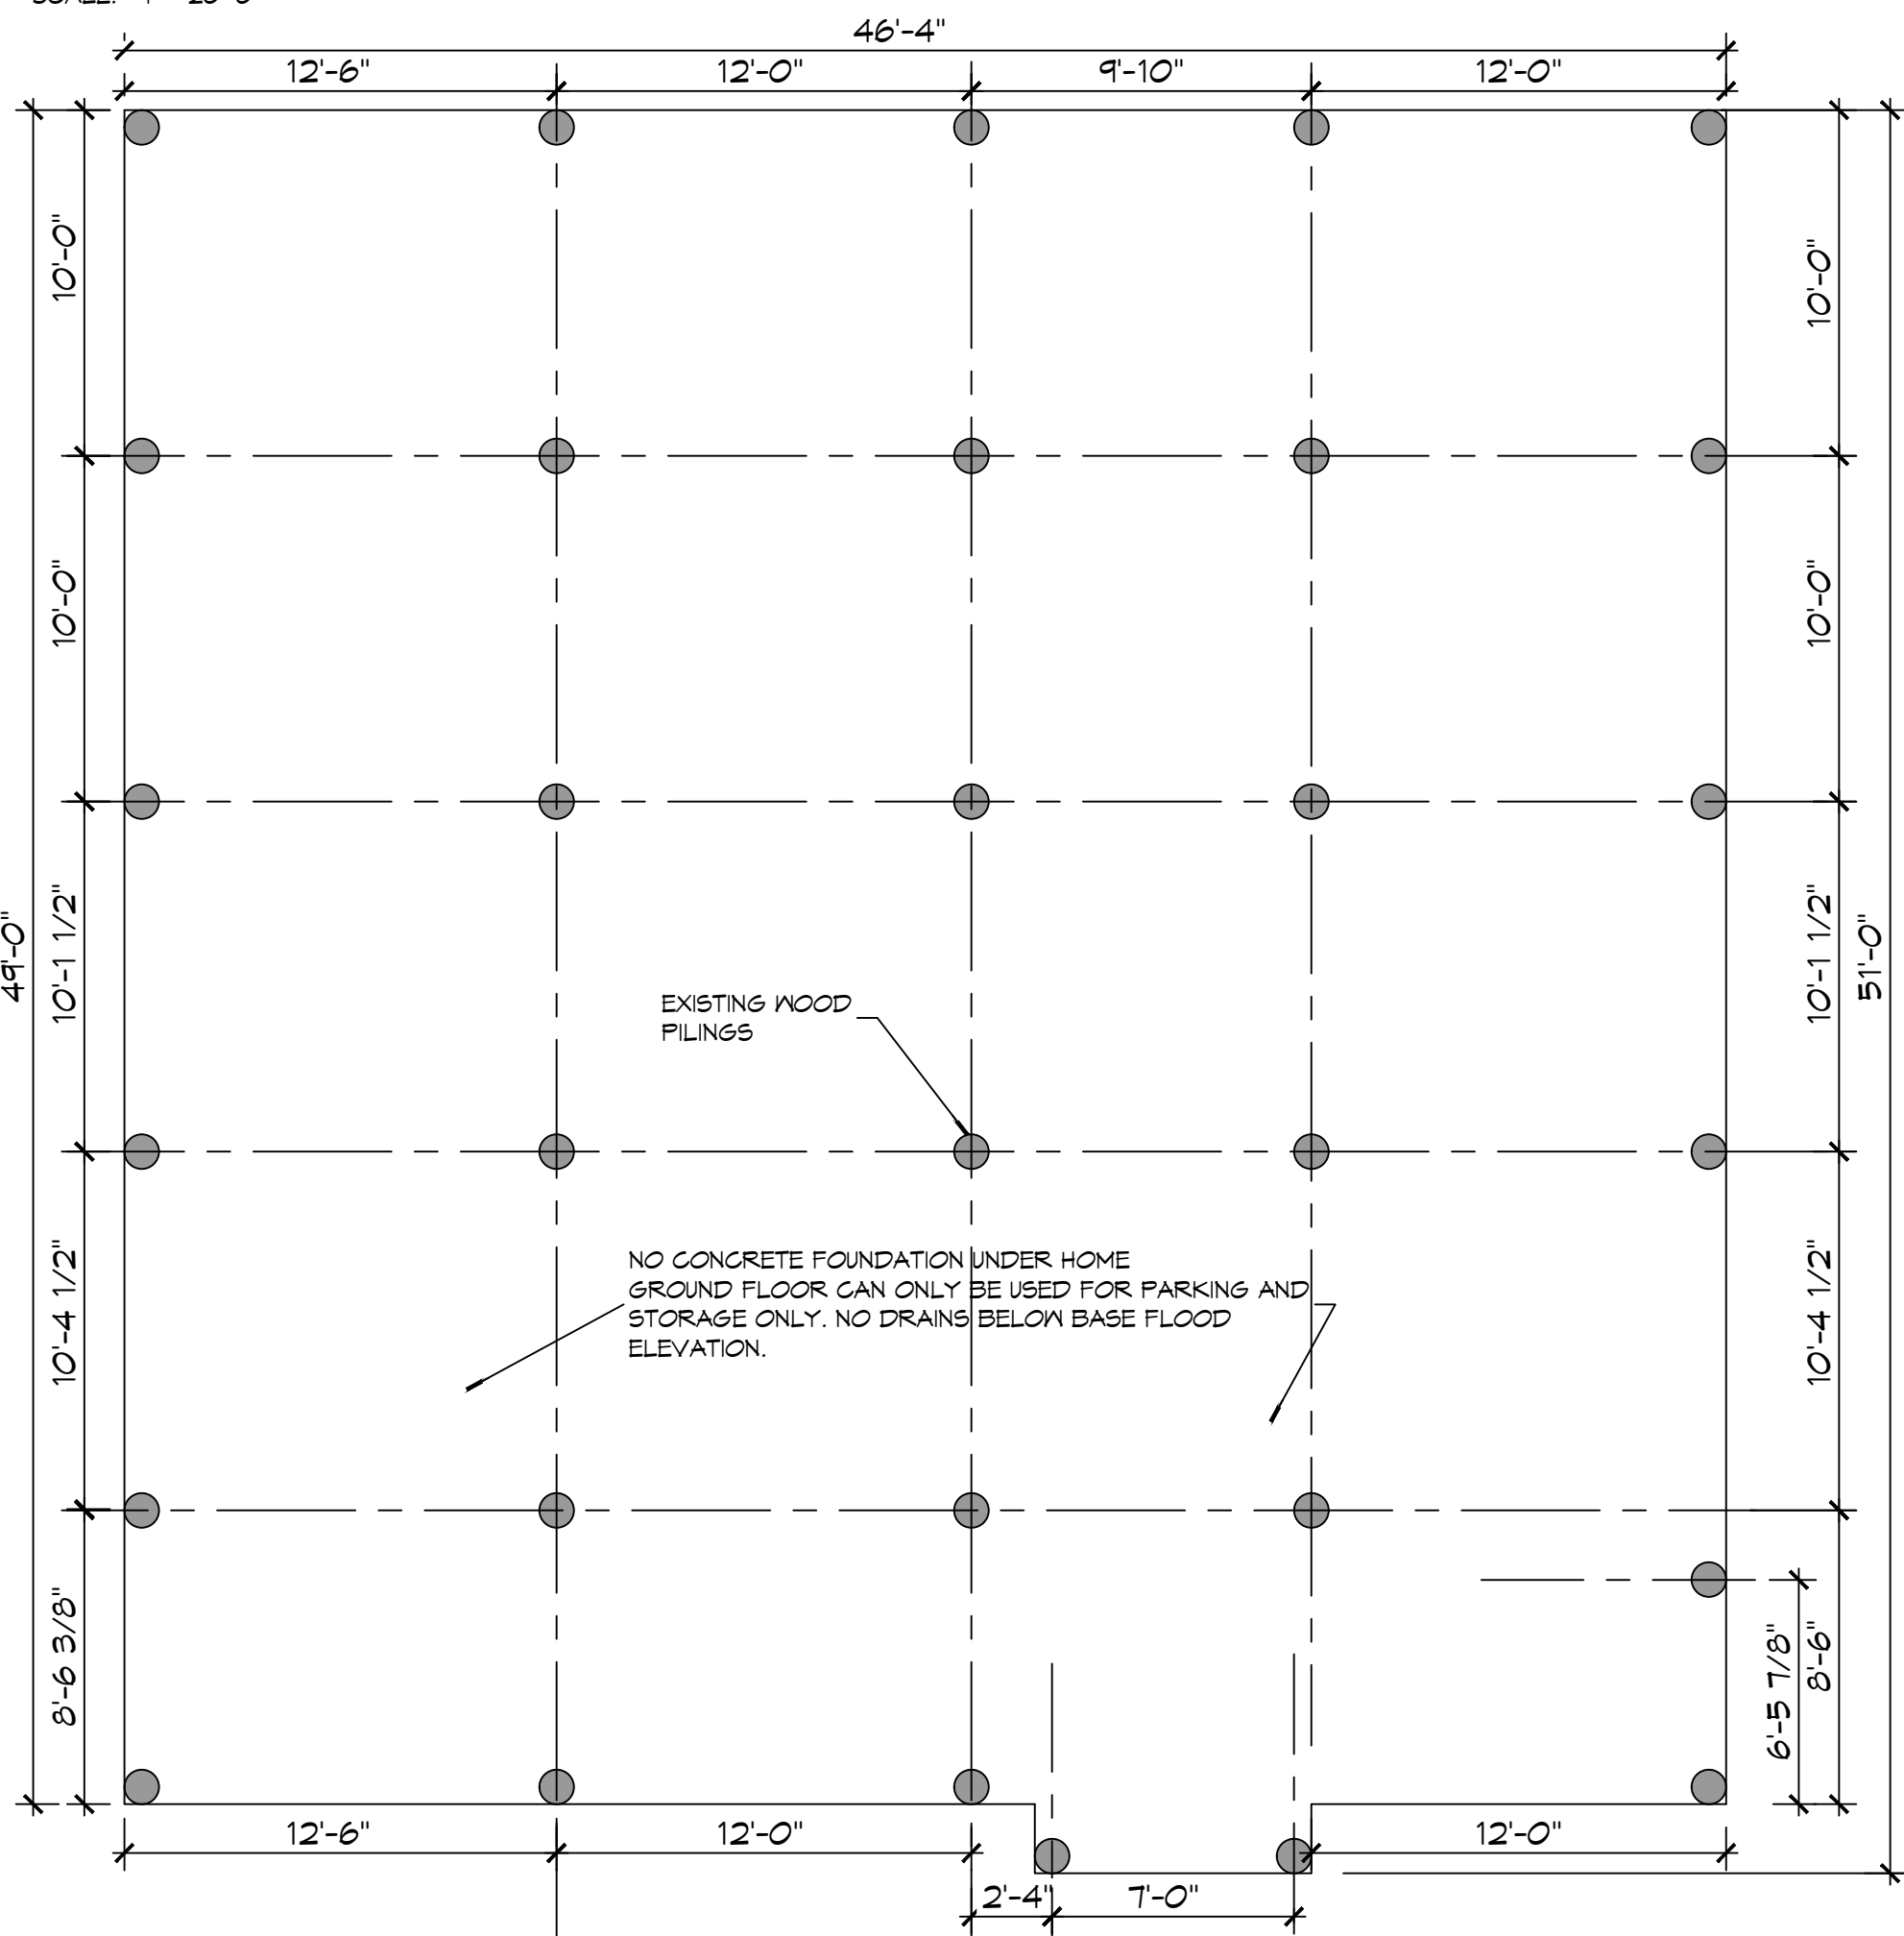

EXISTING PILING PLAN
SCALE: 3/16" = 1'-0"

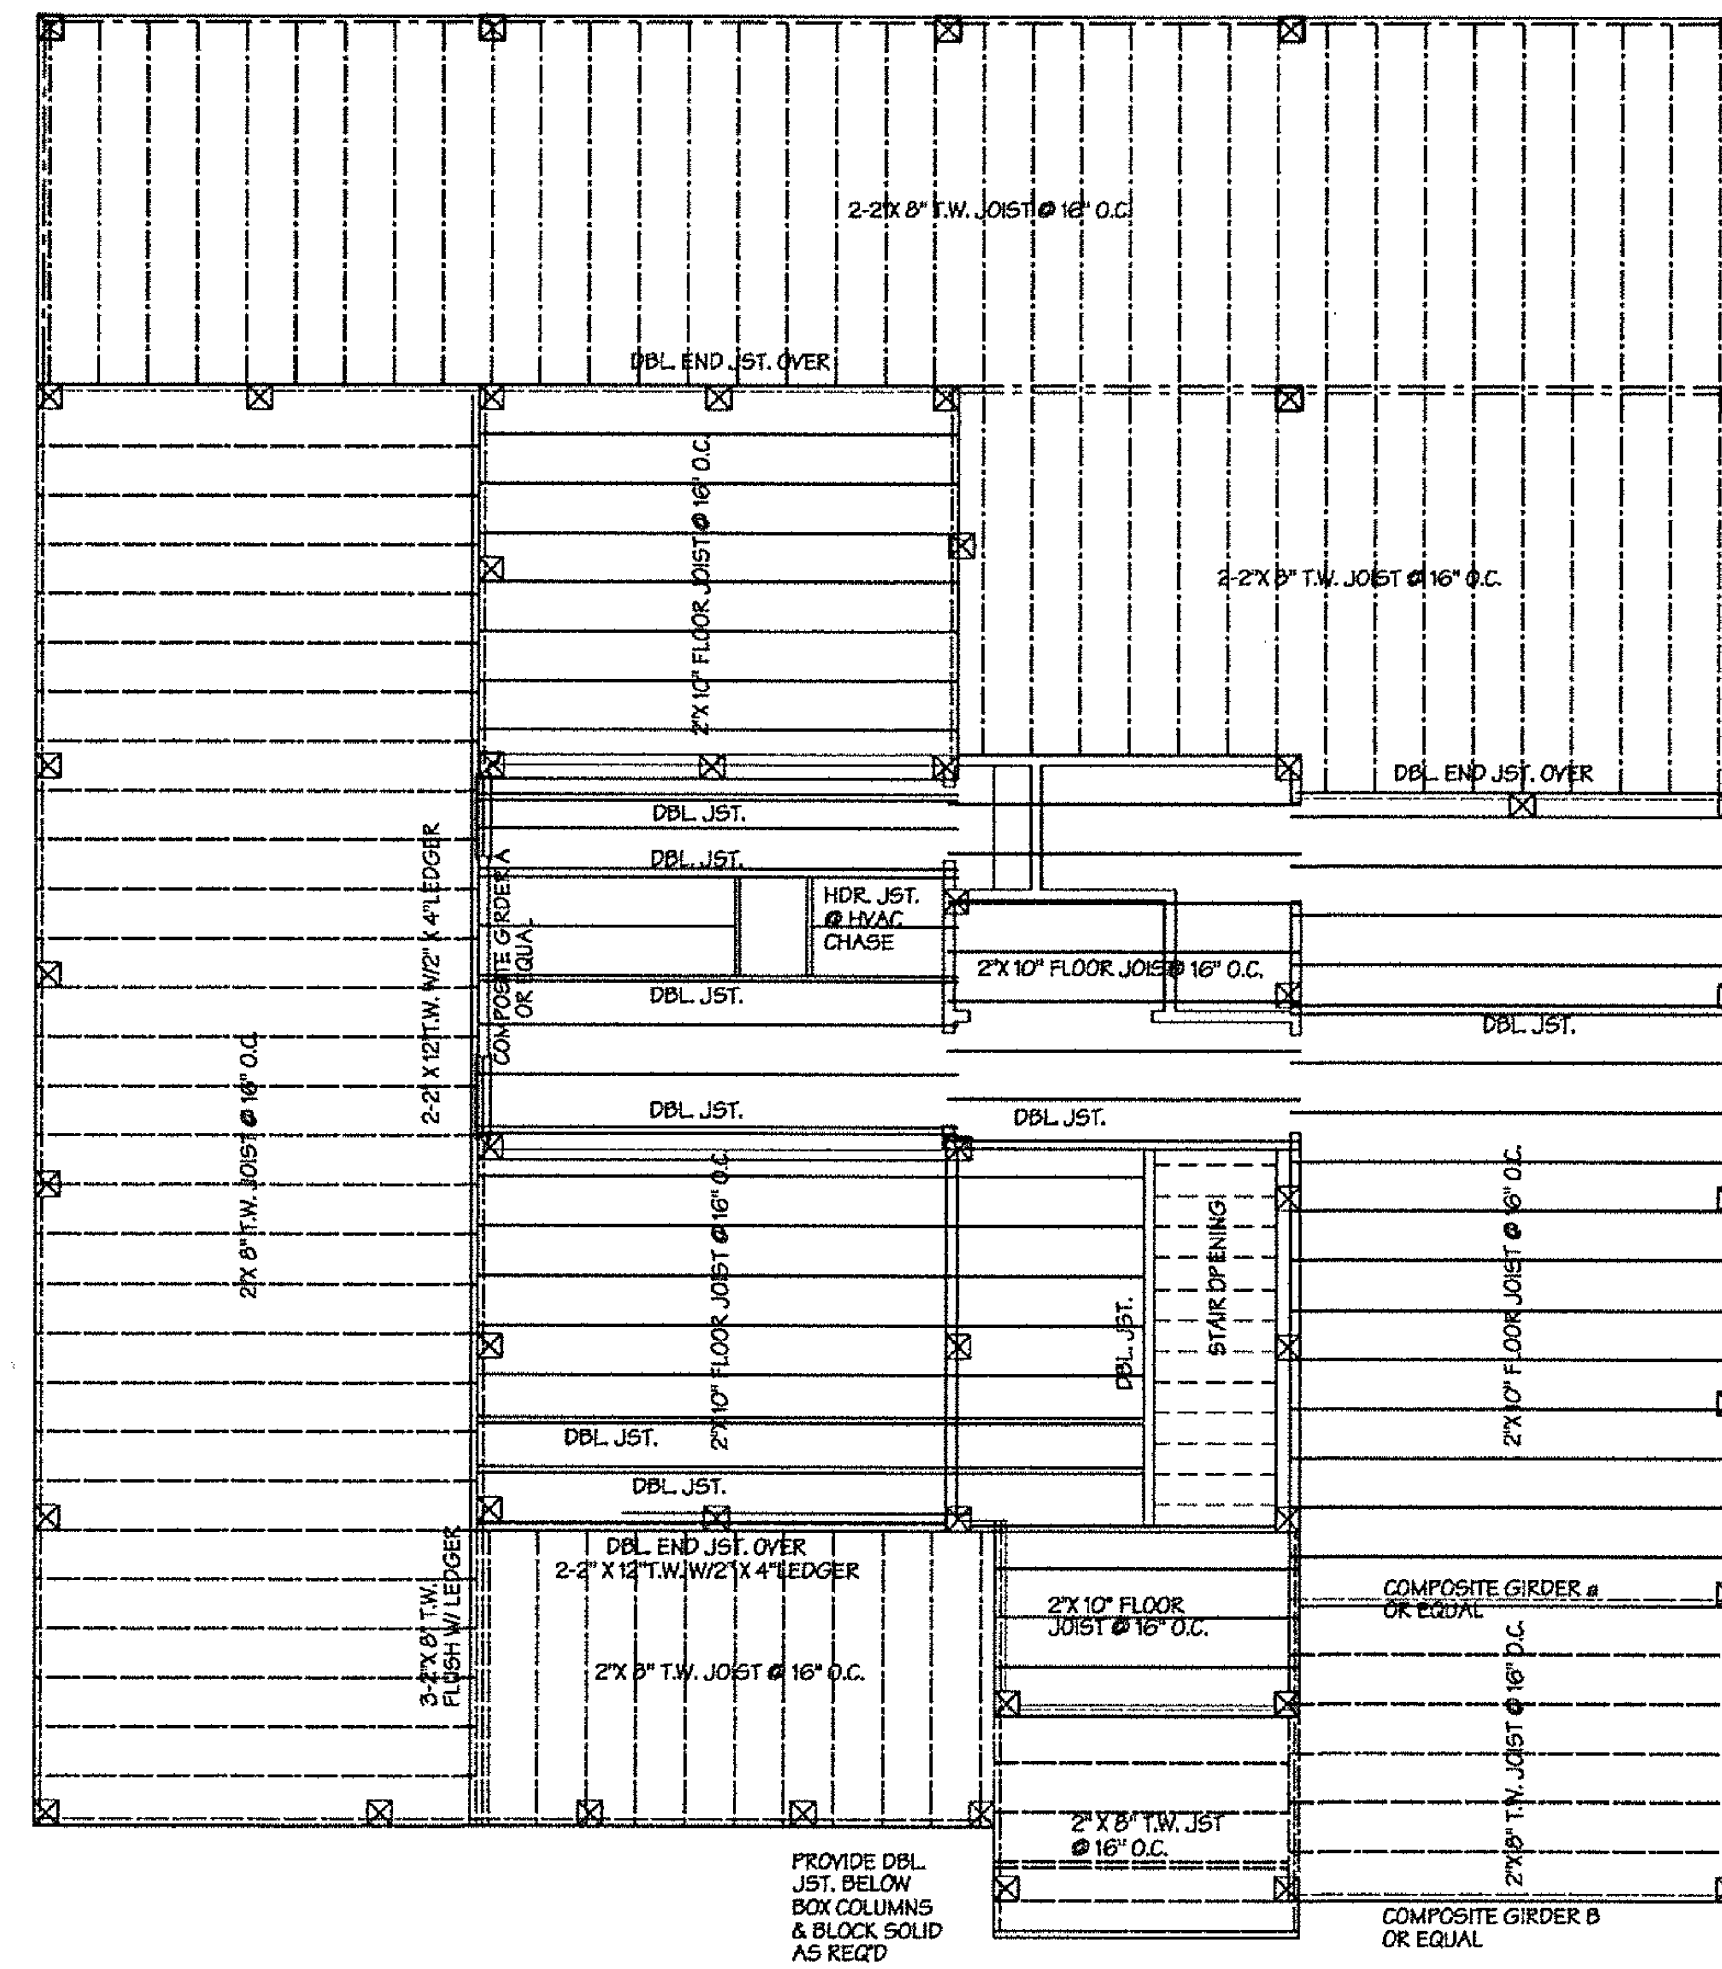

EXISTING 1ST FLOOR FRAMING
SCALE: 3/16" = 1'-0"

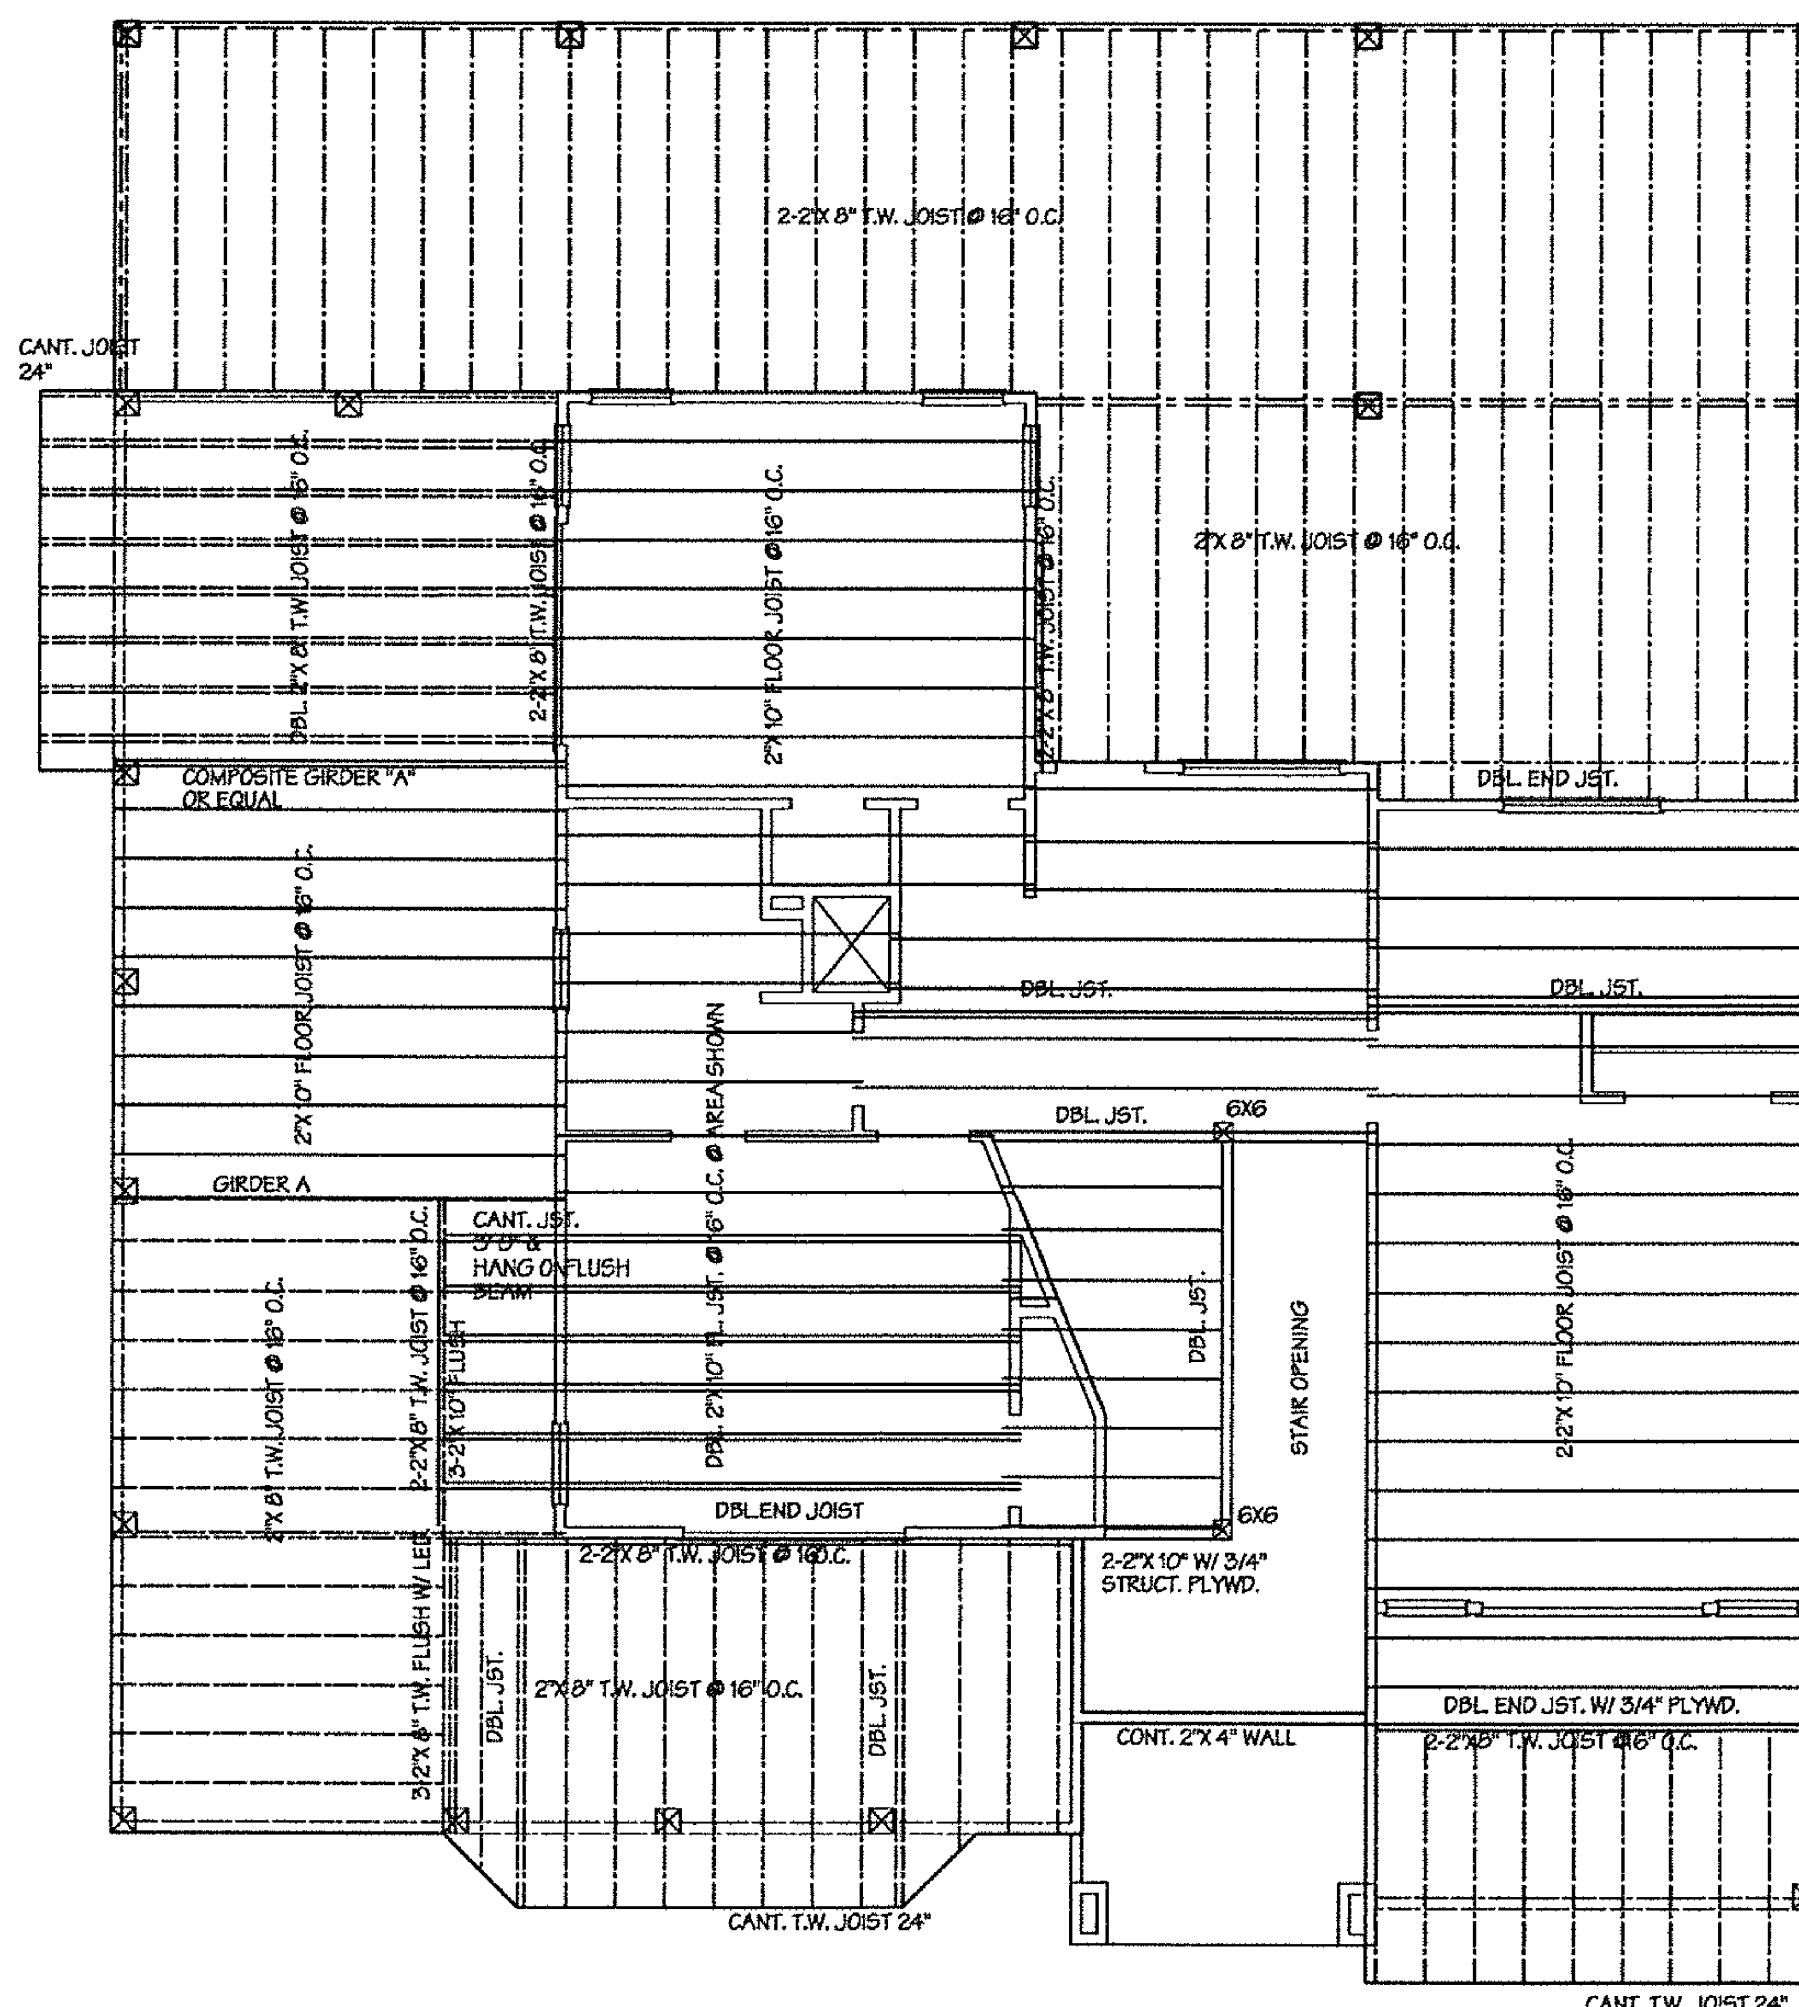

EXISTING 2ND FLOOR FRAMING
SCALE: 3/16" = 1'-0"

| SHEET INDEX | |
|-------------|--|
| SHEET # | SHEET TITLE |
| S100 | EXISTING SITE PLAN, PILING PLAN AND FLOOR FRAMING PLANS. |
| S101 | EXISTING 1ST AND 2ND FLOOR PLAN WITH DORMER PLAN. |
| S102 | FRONT, REAR AND SIDE ELEVATIONS. |
| S103 | 1ST AND 2ND FLOOR LIGHTING PLANS, LIGHTING LEGEND AND RISER DIAGRAM. |
| S104 | TYPICAL CONNECTION DETAILS, SCHEDULES, AND NOTES |
| E101 | POWER & LIGHTING PLAN |
| M101 | MECHANICAL PLAN, 1ST AND 2ND FLOOR. |

| SQUARE FEET | |
|----------------------|-------------|
| LOFT | 78 |
| SECOND FLOOR LIVING | 1085 |
| FIRST FLOOR LIVING | 904 |
| TOTAL SQ. FT. | 2067 |

PROJECT DESCRIPTION

THIS IS AN EXISTING RESIDENTIAL HOME THAT WAS NOT COMPLETED THRU CONSTRUCTION. THESE DRAWINGS ARE DERIVED FROM EXISTING DRAWINGS FOR THE PURPOSE OF OBTAINING A PERMIT TO COMPLETE THE CONSTRUCTION PROCESS.

DESIGN CRITERIA

THE CONSTRUCTION FOR SAID RESIDENCE, WHERE BASIC WIND SPEED IS 140 MILES PER HOUR, WIND EXPOSURE ZONE C, IS DESIGNED IN ACCORDANCE WITH AMERICAN FOREST AND PAPER ASSOCIATION (AF&PA) WOOD FRAME CONSTRUCTION MANUAL FOR ONE AND TWO FAMILY DWELLINGS (WFCM) 2001 EDITION AS WELL AS THE INTERNATIONAL RESIDENTIAL CODE (IRC) 2021 EDITION AND 2020 NATIONAL ELECTRICAL CODE.

- REPAIR NOTES**
1. REMOVE ALL DAMAGED WOOD AND REPLACE WITH NEW MATERIALS.
 2. STRAP ALL NEW MATERIALS WITH SIMPSON STRONG TIE AND INSTALL PER CODE.
 3. REMOVE AND REPLACE ALL SHEATHING ON THE SOUTH SIDE OF STRUCTURE; 1ST AND 2ND STORY.
 4. REMOVE AND REPLACE ALL SHEATHING ON THE EAST SIDE OF STRUCTURE FOYER ENTRY 1ST STORY.
 5. REMOVE AND REPLACE ALL SHEATHING ON THE WEST SIDE OF STRUCTURE FOYER ENTRY 1ST STORY.
 6. REMOVE AND REPLACE ALL SHEATHING ON THE NORTH SIDE OF THE STRUCTURE KITCHEN WALL.
 7. REMOVE AND REPLACE ALL SHEATHING ON THE EAST SIDE OF STRUCTURE KITCHEN WALL.
 8. REMOVE AND REPLACE ALL SHEATHING ON THE NORTH SIDE OF STRUCTURE UTILITY ROOM WALL.
 9. REPAIR TOP PLAT RUNNING LENGTH OF STRUCTURE UTILITY ROOM.
 10. REPAIR / REPLACE SOUTH SIDE DOOR OPENING STRUCTURE UTILITY ROOM.
 11. REPAIR / REPLACE SOUTH SIDE DOOR OPENING STRUCTURE FOYER; HEADER, KING STUDS, JACK STUDS.
 12. REPAIR/REPLACE DAMAGED FLOOR DECKING SOUTH EAST MEDIA/DEN ROOM DOOR OPENING STRUCTURE 1ST FLOOR.
 13. REPAIR/REPLACE DAMAGED FLOOR JOIST FOYER 1ST FLOOR.
 14. REPAIR/REPLACE DAMAGED FLOOR DECKING FOYER 1ST FLOOR.
 15. REPAIR/REPLACE DAMAGED FLOOR DECKING SOUTH WEST BR DOOR OPENING STRUCTURE.
 16. REPAIR/REPLACE DAMAGED FLOOR DECKING FOYER NORTH DOOR OPENING 1ST FLOOR.
 17. REPAIR/REPLACE DAMAGED FLOOR DECKING SOUTH EAST BR DOOR OPENING 2ND FLOOR.
 18. REPAIR/REPLACE DAMAGED FLOOR DECKING NORTH DOOR OPENING DEN 2ND FLOOR.
 19. REPAIR/REPLACE DAMAGED FLOOR DECKING WEST DOOR OPENING DEN 2ND FLOOR.

| DATE | REVISIONS | DESCRIPTION |
|------|-----------|-------------|
| | | |
| | | |



UPDATED HOUSE PLAN

TOM CATHEY

280 LAKEVIEW DRIVE
SLIDELL, LA 70568
JOB NO: 2024
DATE: 07-24-2024
DRAWN BY: CKD
CHECKED BY: BAY

SHEET TITLE:
EXISTING SITE PLAN, PILING PLAN AND FLOOR FRAMING PLANS.

DRAWING NUMBER:
S100

SHEET No: 1 of 7