Troy Livette
13924 Deneen Rd.
Vancleave Ms. 39565

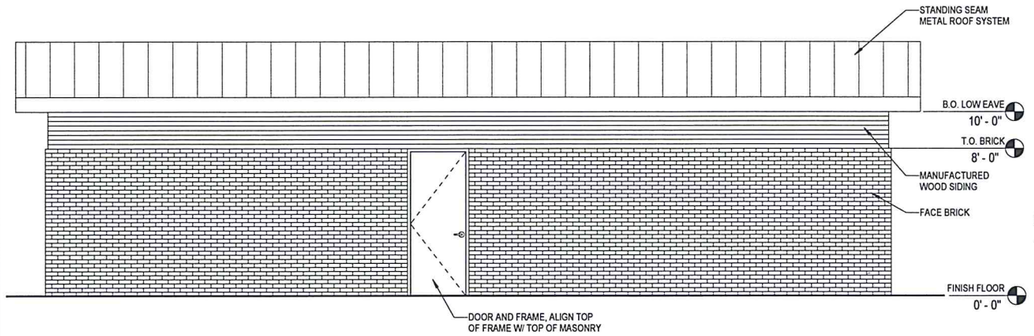

1 A100 A100 NORTH ELEVATION
1/4" = 1'-0"

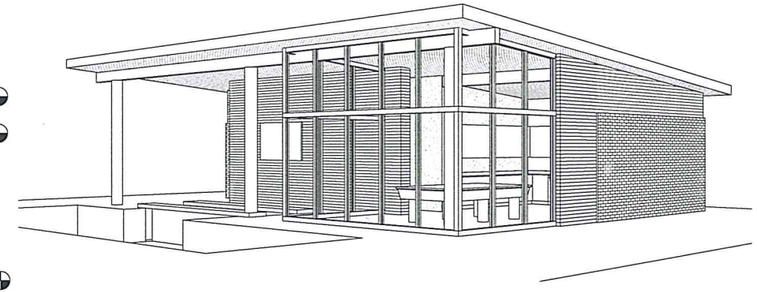

5 A100 PERSPECTIVE 1

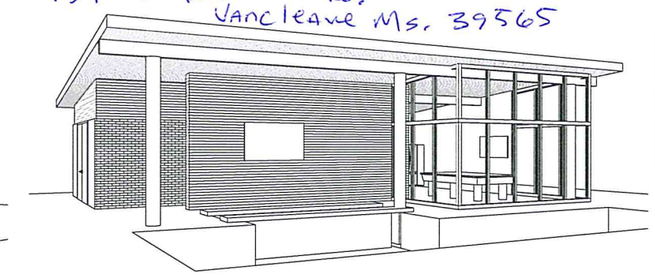

6 A100 PERSPECTIVE 2

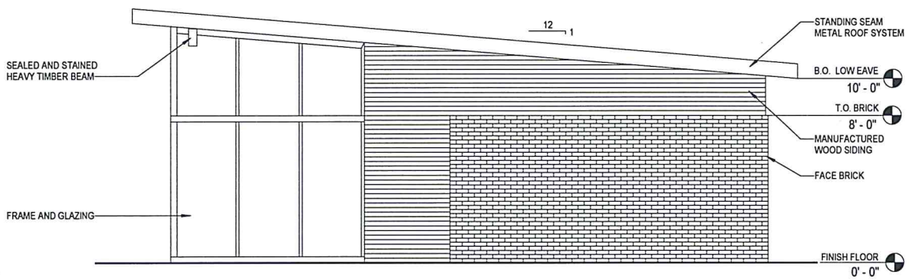

2 A100 A100 EAST ELEVATION
1/4" = 1'-0"

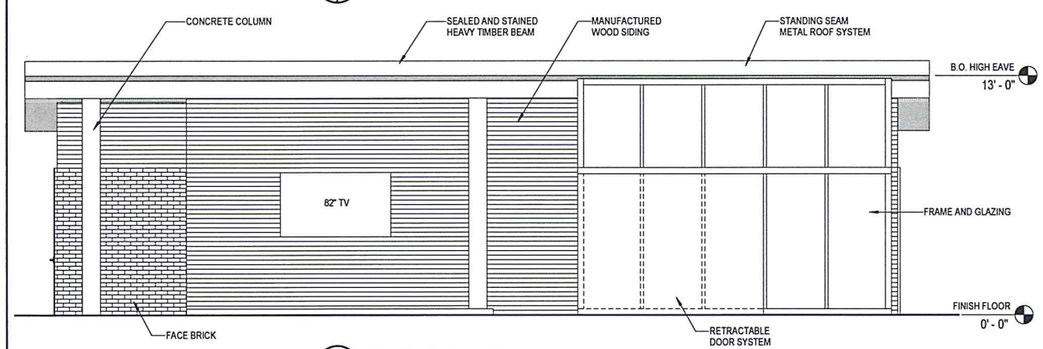

3 A100 A100 SOUTH ELEVATION
1/4" = 1'-0"

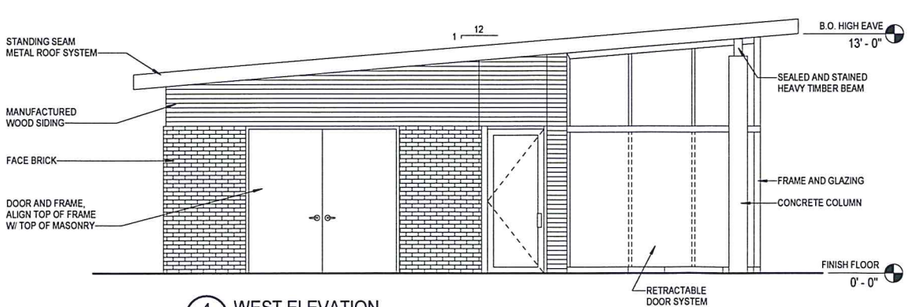

4 A100 A100 WEST ELEVATION
1/4" = 1'-0"

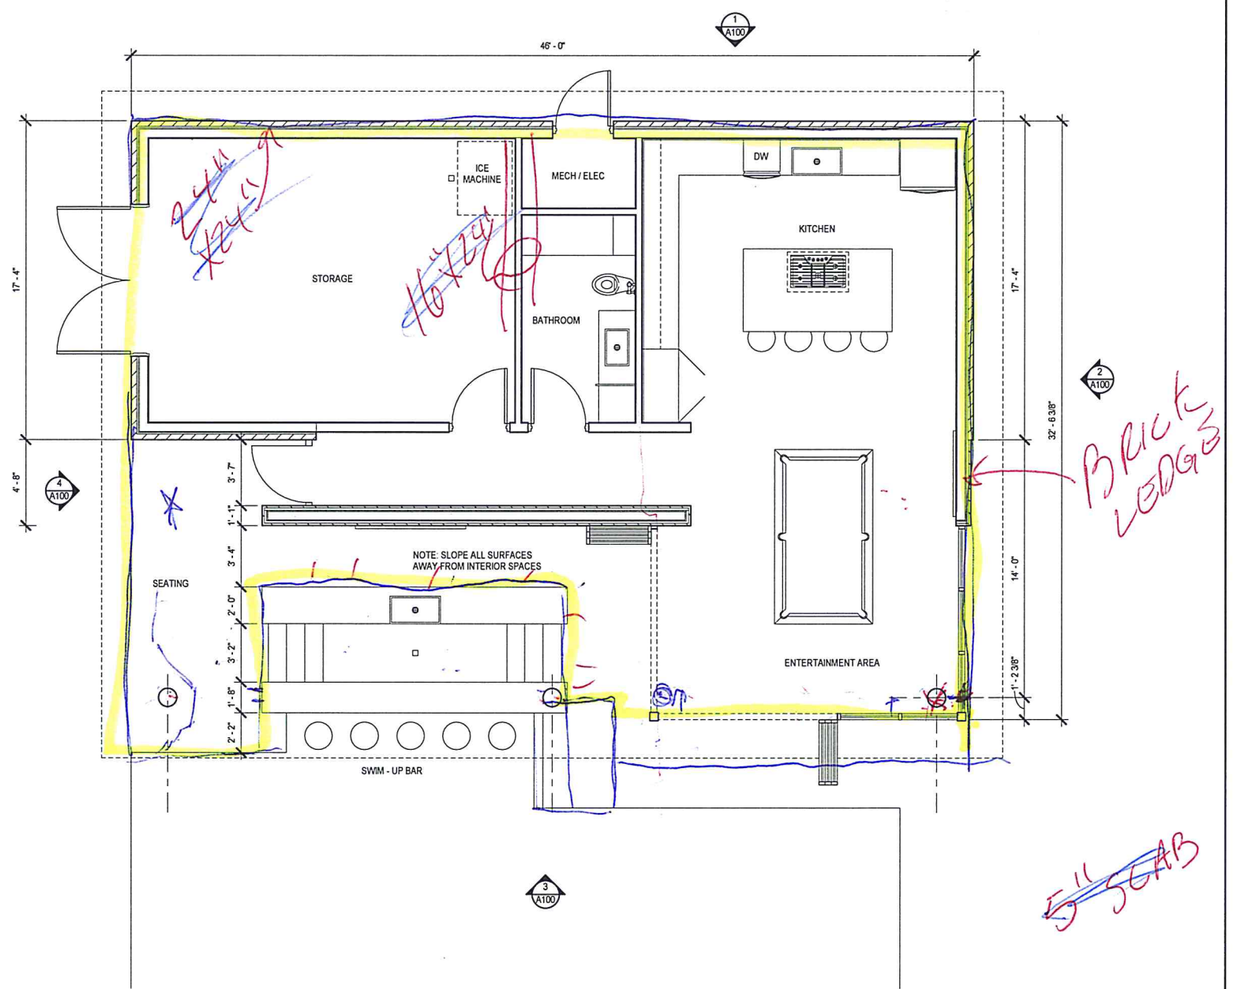

7 A100 1ST FLOOR
1/4" = 1'-0"

NORTH

4' 0' 4' 8'
SCALE: 1/4"=1'-0"

A100
FLOOR PLAN