


NOTE A:  
ALL UNDERGROUND RISERS FOR THIS CONTACT PHASE  
SHALL TERMINATE 12" ABOVE THE FINISH FLOOR.

**FIRST FLOOR PLAN - UNDERGROUND PLUMBING**  
SCALE 1/8" = 1'-0"  
P-02

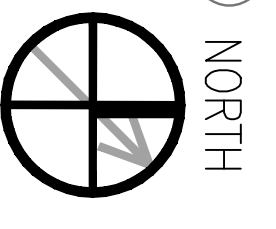


NOTES:  
1. ALL INVERT ELEVATIONS ARE TAKEN FROM  
TOP OF FINISH SLAB = 0'-0"

PROVIDE A FRENCH DRAIN  
FOR COMPRESSOR'S DRAIN LINE.  
SEE DETAIL ON P-06

**HUSEMAN & Associates**  
MECHANICAL • ELECTRICAL • PLUMBING • FIRE PROTECTION  
3925 N-HO SERVICE RD. (504) 456-3119  
SUITE 201B, METairie, LA 70002 FAX (504) 456-3122  
Job No. 090201  
Drawn By: RM  
Designed By: RM  
Checked By: GB

**WALDEMAR S. NELSON AND COMPANY**  
ENGINEERS AND ARCHITECTS  
1200 ST. CHARLES AVE. NEW ORLEANS, LA

RECORD DRAWING DATE: 08/25/09  
CODE LD. NO.: D  
DRAWING SIZE: D  
SPEC. NO. 08--  
CONSTR. CONTR. NO.:  
NAVFAC DRAWING NO.: 15020948  
SHEET 2 OF 11  
P-02

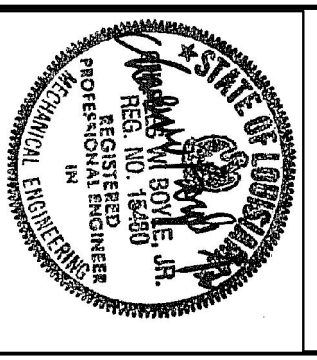

**NAVFAC**  
Naval Facilities Engineering Command  
Southeast Division, Jacksonville, FL

NAS JRB New Orleans Belle Chasse, Louisiana  
**NAVAIRSEFAC CALIBRATION BLDG.  
UNDERGROUND PLUMBING FLOOR PLAN**  
APPROVED DATE: AUGUST 22, 2008 EPD FOR COMMANDER, NAVFAC

DRAWING REVISIONS				
REV.	DESCRIPTION	PREP BY	DATE	APPROV.
0	FINAL DESIGN	RM	08/25/09	CB
1	REV. WASTE & VENT FOR BREAKROOM	RM	10/29/09	CB

**BROADMOOR**  
BUILDING by DESIGN  
BROADMOOR, L.L.C.  
2740 North Armand Road  
Metairie, Louisiana 70002  
www.broadmoorllc.com