


- SPECIFIC NOTES:**
- 1 PROVIDE 2 1/2" MAIN SHUT-OFF VALVE BEFORE WATER METER.
 - 2 PROVIDE A TURBO W/ DIGITAL REMOTE READER WATER METER.
 - 3 REDUCE PRESSURE BACKFLOW PREVENTER WITH GATE VALVES AND STRAINER.
 - 4 1 1/4" MAKE-UP WATER WITH REDUCED PRESSURE BACKFLOW PREVENTER. SEE HVAC FOR CONTINUATION.
 - 5 E/F/W - EMERGENCY DE WASH SHALL BE FED WITH 70 DEGREE THERM FROM BOILER USE ELECT WATER HEATER AND EMERGENCY WINKING VALVE AS SHOWN ON THIS PLANS.
 - 6 GAS METER LOAD 1,000,000 BTU REGULATED @ 12" W.C. 1 1/2" PIPE SIZE TO BOILER. SEE GAS DETAIL SHEET P-06.1
 - 7 OWNER FURNISHED AIR COMPRESSOR/RECEIVER. SEE SCHEDULE FOR DRYER. SEE DETAILS AND SPECIFICATIONS.
 - 8 EXPANSION TANK. SEE SCHEDULE FOR SPECIFICATIONS.

AIR DROPS LOCATIONS WERE DIRECTED BY DRP REPRESENTATIVE

EXISTING AIR COMPRESSOR TO BE RELOCATED TO THIS LOCATION. PROVIDE A FRENCH DRAIN FOR COMPRESSOR'S DRAIN LINE.

FIRST FLOOR PLAN - PLUMBING WATER DISTRIBUTION


SCALE: 1/8" = 1'-0"

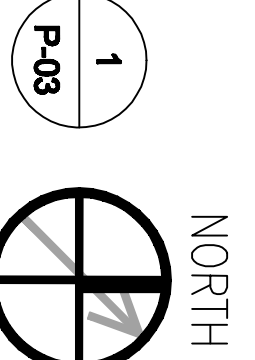

HUSEMAN & Associates
 MECHANICAL ELECTRICAL PLUMBING FIRE PROTECTION
 3927 N 110 SERVICE RD
 SUITE 2019 METAIRIE, LA 70002
 Phone: (504) 456-3119
 Fax: (504) 456-3122
 Drawn By: RW
 Designed By: RL
 Checked By: GB

WALDEMAR S. NELSON AND COMPANY
 ENGINEERS AND ARCHITECTS
 1200 ST. CHARLES AVE
 NEW ORLEANS, LA

RECORD DRAWING DATE	10/29/08
CODE ID NO.	1003000
DRAWING SIZE	D
SPEC. NO. OR CONTR. NO.	
NAVFAC DRAWING NO.	1503000
SHEET	4 OF 11
P-03	

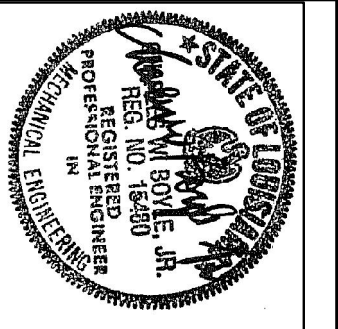

NAVFAC
 Naval Facilities Engineering Command
 Southeast Division, Jacksonville, FL

NAS JRB New Orleans Belle Chase, Louisiana
NAVAIRSEFAC CALIBRATION BLDG.
 PLUMBING FLOOR PLAN SHEET 2 OF 2
 APPROVED DATE: AUGUST 22, 2008 EPD FOR COMMANDER, NAVFAC

DRAWING REVISIONS				
REV.	DESCRIPTION	PREP BY	DATE	APPROV.
0	FINAL DESIGN	RM	10/29/08	CB

BROADMOOR
 BUILDING by DESIGN
 BROADMOOR, L.L.C.
 2740 North Amick Road
 Metairie, Louisiana 70002
 www.broadmoorllc.com