


DROP SEWER MANHOLE, TYP

N.T.S.


1  
C-4

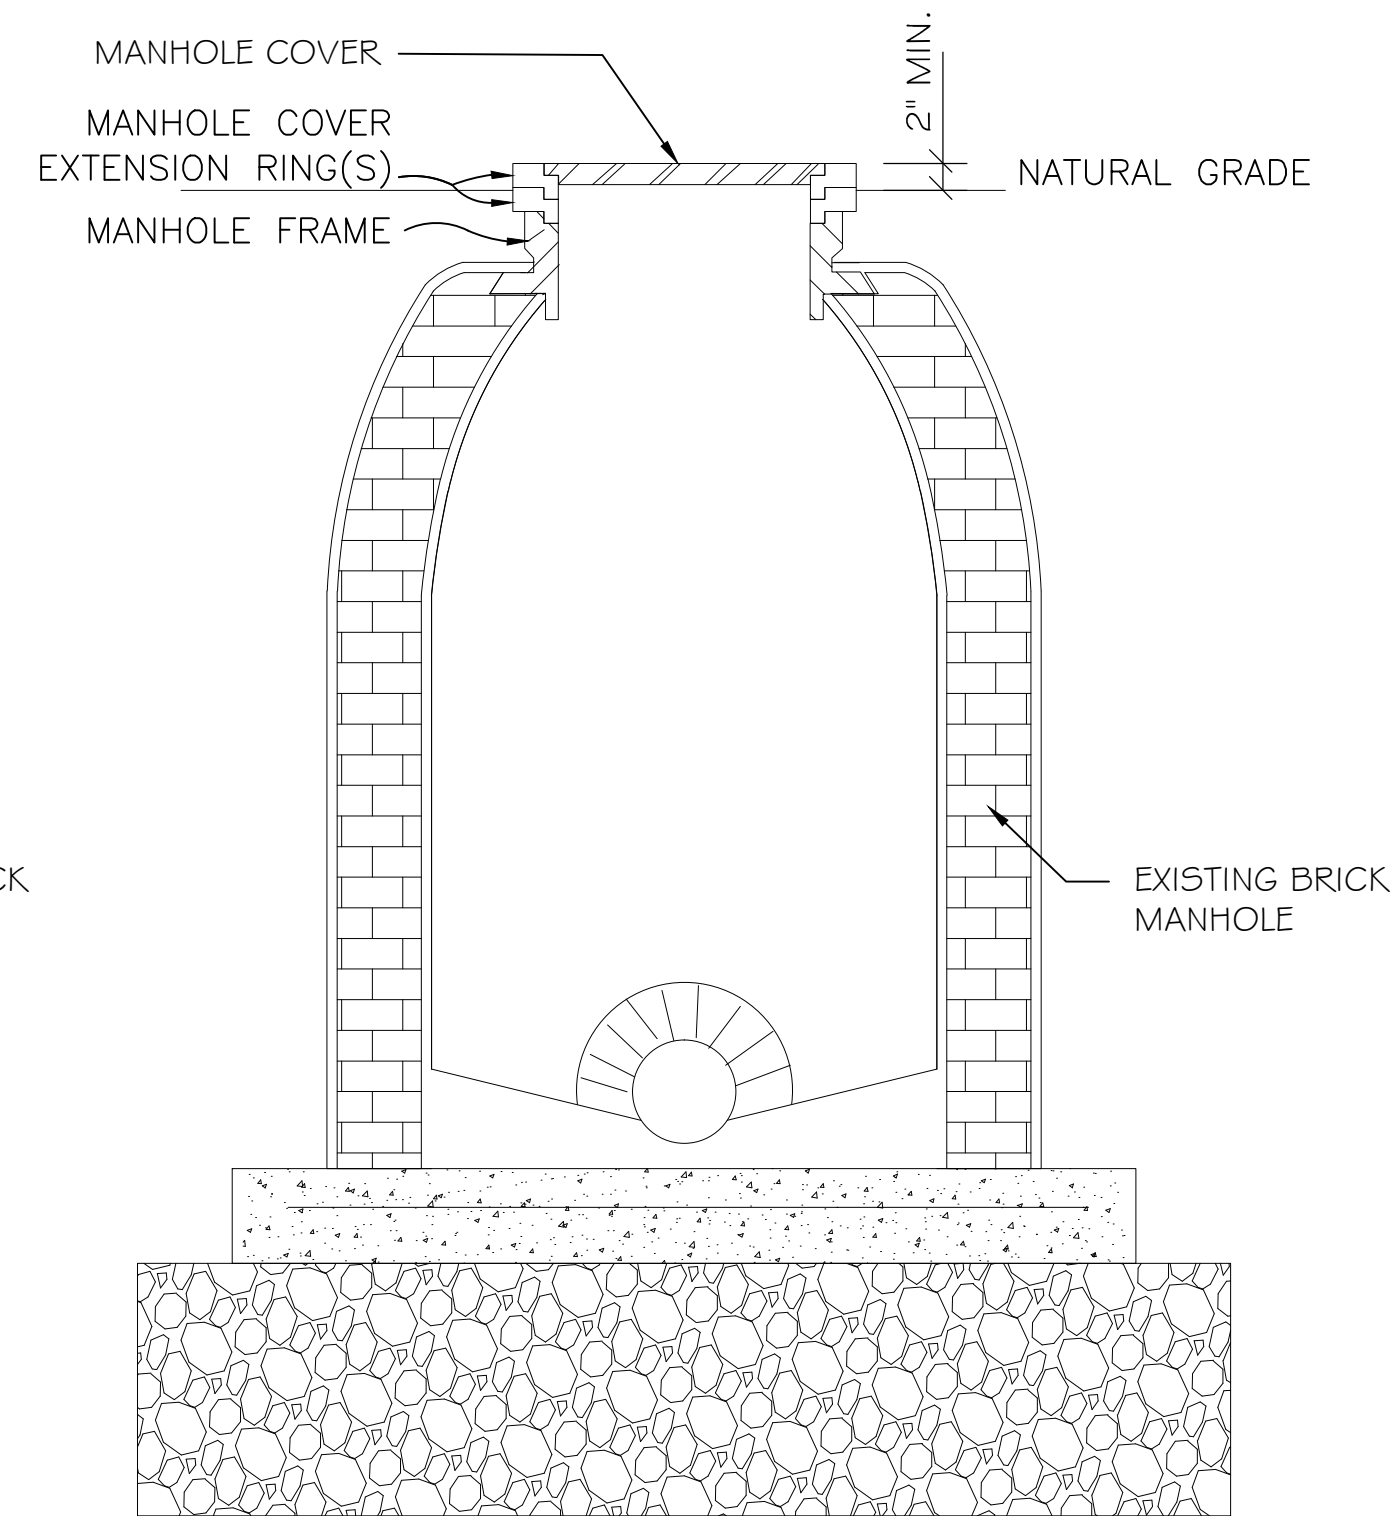

COVER EXTENSION RING(S)

N.T.S.


2  
C-4

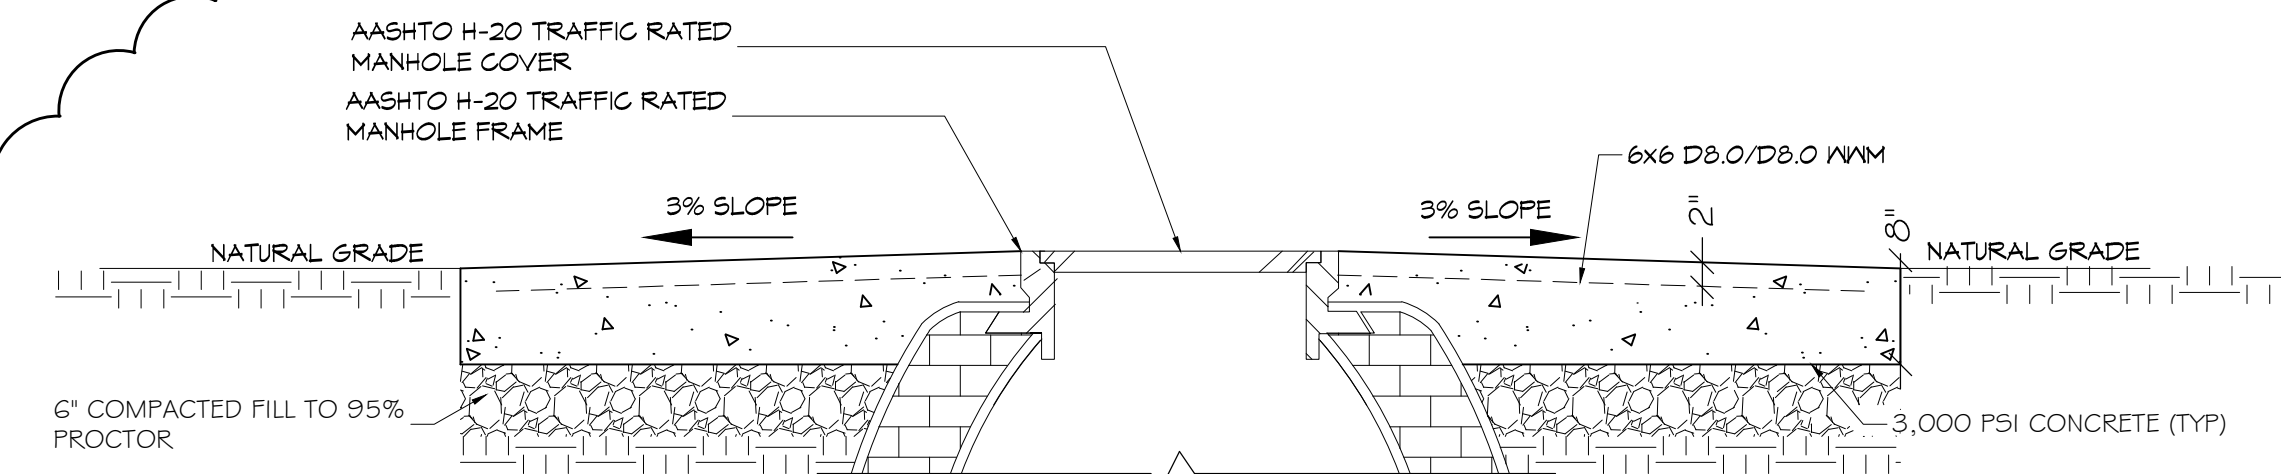

MH PAD DETAIL

N.T.S.

3A  
C-4

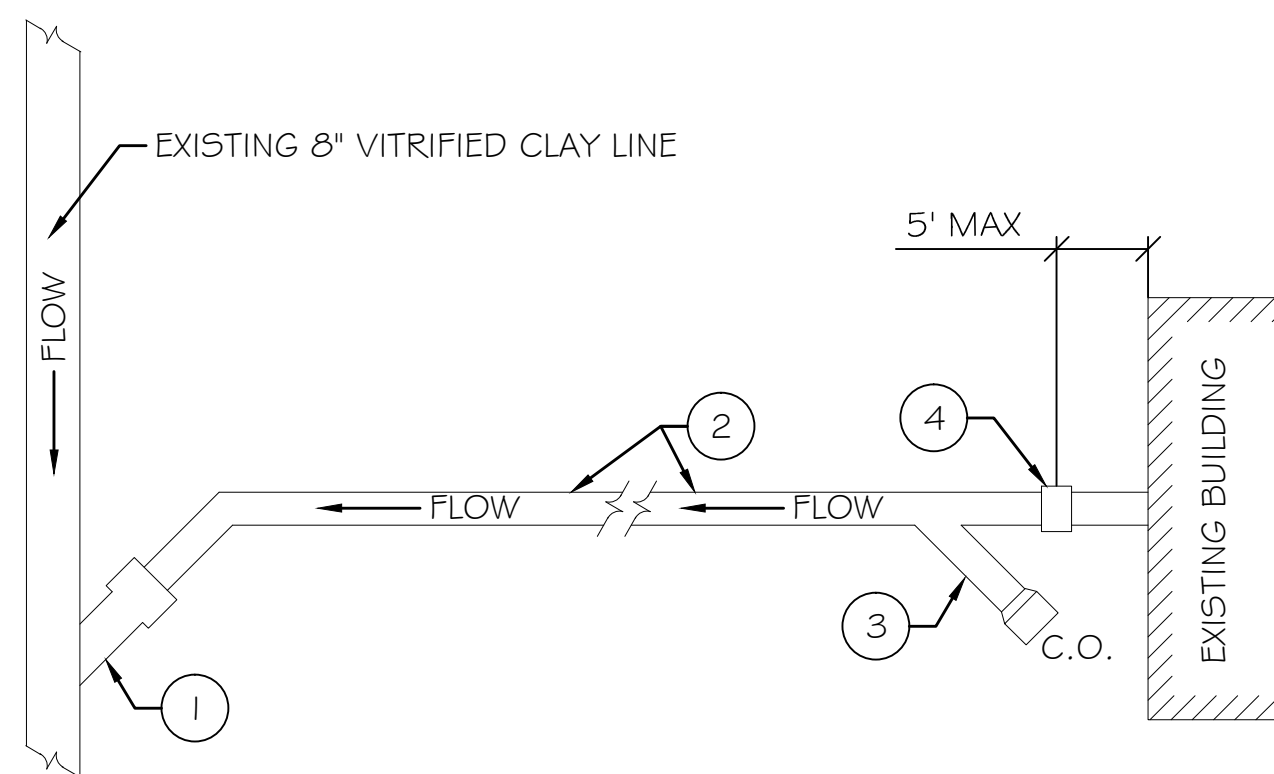


SERVICE LATERAL NOTES

- EVALUATE EXISTING CONNECTION / WYE. REPAIR, REPLACE (VITRIFIED CLAY, CAST IRON) OR PROVIDE NEW TAP SADDLE, FERNCO OR EQUAL.
- PROVIDE NEW 4" OR 6" SDR26 PVC PIPE SERVICE LATERAL AS SHOWN ON PLAN. ALL LATERALS TYING INTO OTHER LATERALS SHALL BE CONNECTED WITH 45° WYE WHERE POSSIBLE.
- EVALUATE EXISTING CLEANOUT. REPAIR OR PROVIDE NEW. PROVIDE CAST IRON CLEAN OUT BOX AT GRADE IF REQUIRED. SEE SPECS. IF NO CLEAN OUT EXISTS, PROVIDE NEW, SEE DETAIL AND SPECS.
- EVALUATE CONNECTION / STUB-OUT TO EXISTING BUILDING. PROVIDE PROPER CONNECTION, FERNCO OR EQUAL.

TYP. SERVICE LATERAL SCHEMATIC

N.T.S.

4  
C-4

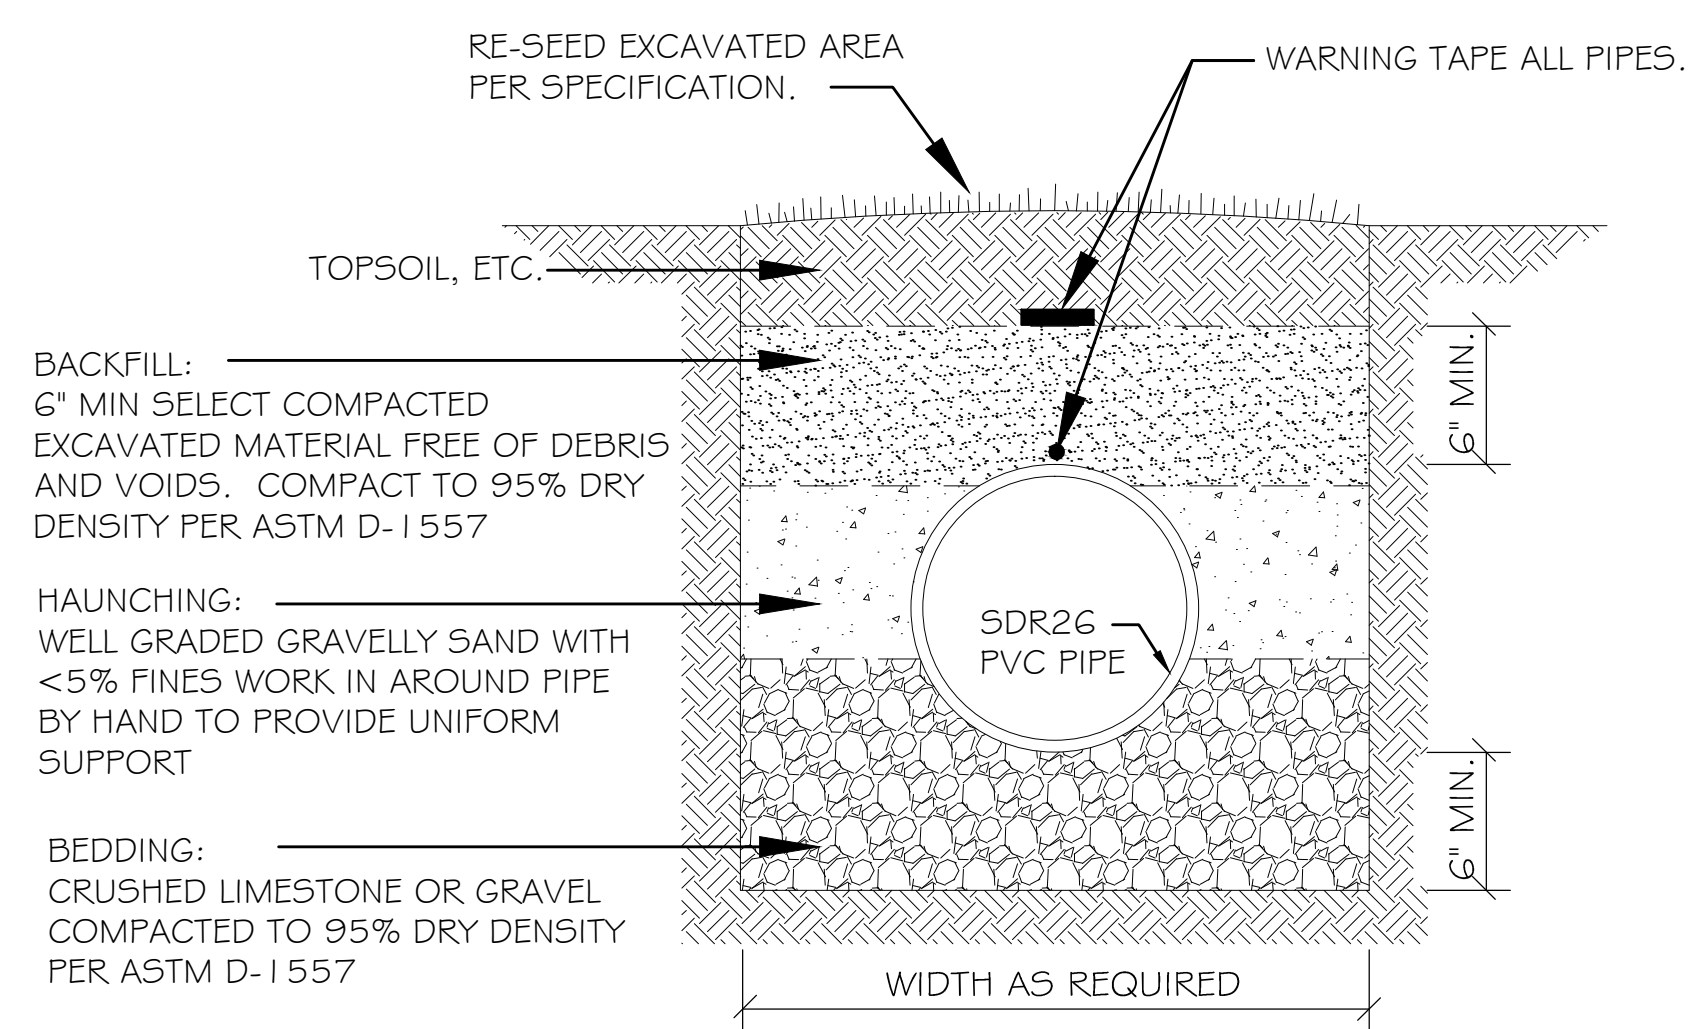


NOTE:  
CONTRACTOR SHALL PROVIDE SHEETING AND BRACING TO CONTROL THE WIDTH OF EXCAVATED TRENCH AND TO SAFEGUARD THE INTEGRITY OF THE SEWER TRENCH. CONTRACTOR SHALL PROVIDE SUFFICIENT SHEETING AND BRACING TO PROVIDE SAFE WORKING CONDITIONS FOR HIS WORKMEN.

SERVICE LATERAL SECTION

N.T.S.

5  
C-4

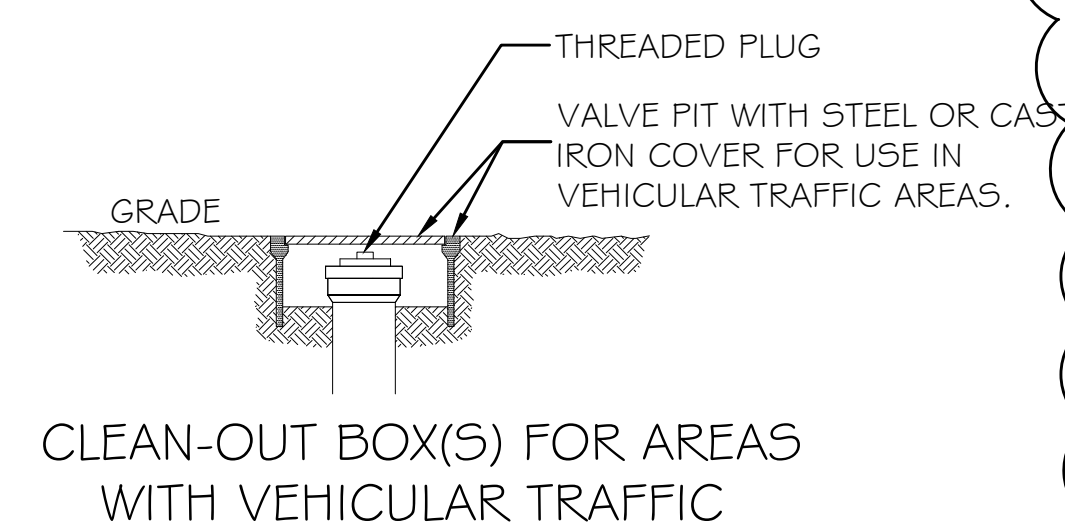


CLEAN-OUT BOX(S) FOR AREAS WITH VEHICULAR TRAFFIC



SEWER CLEANOUT DETAIL

N.T.S.


6  
C-4

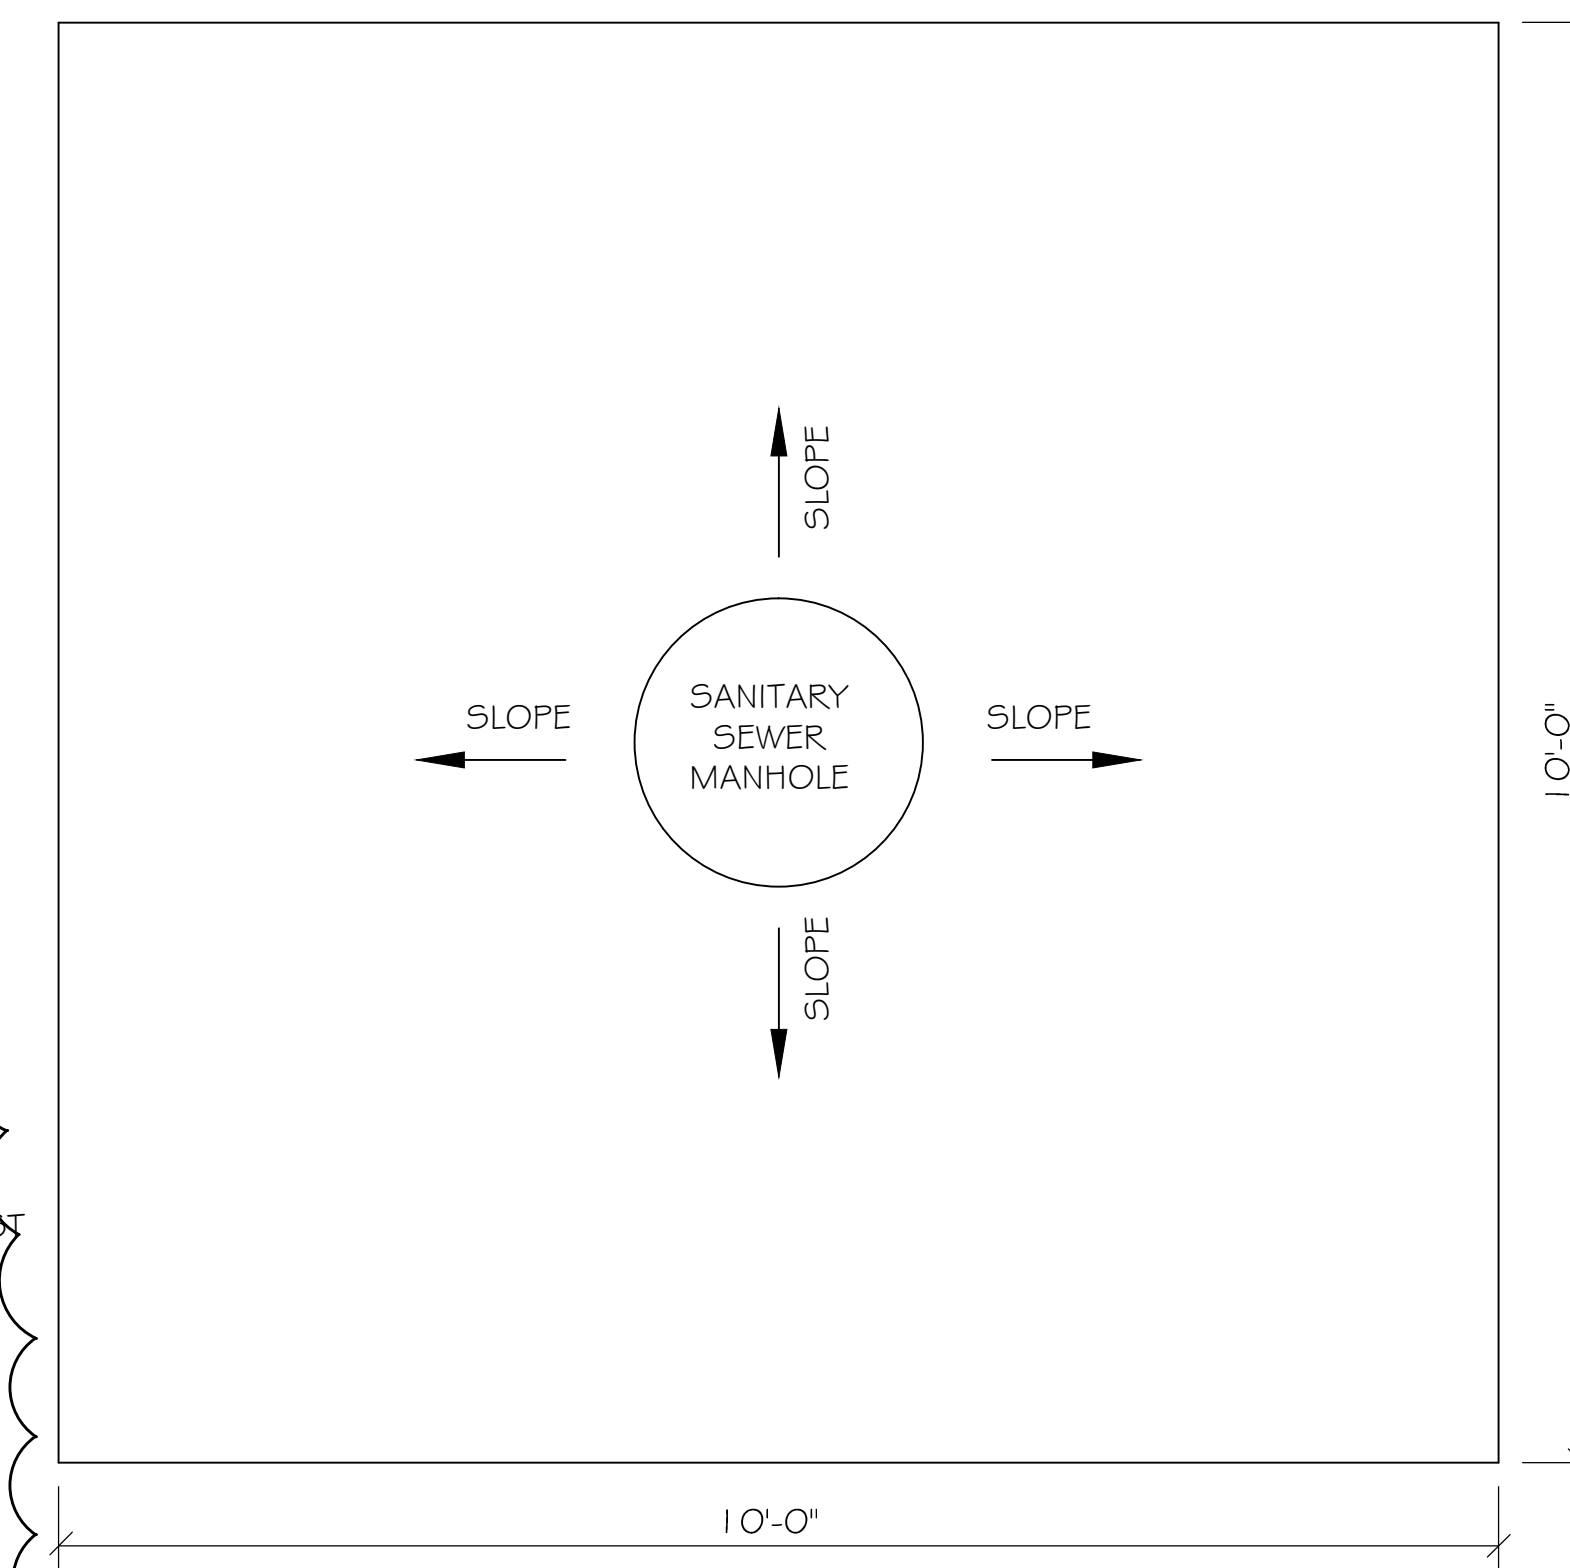

MANHOLE PAD PLAN VIEW

N.T.S.

3B  
C-4

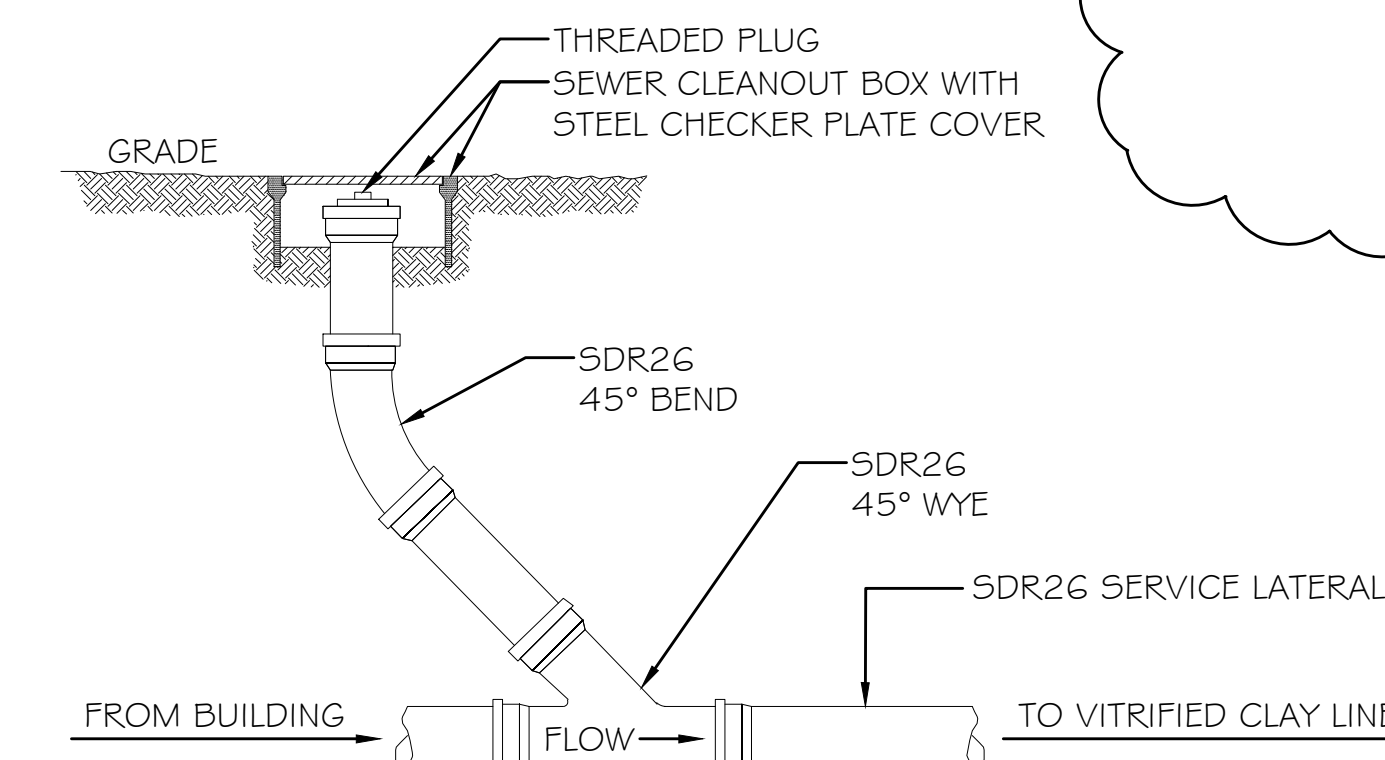

SERVICE LATERAL DETAIL

6" SDR26 PVC PIPE, TYP.

BEDDING, SEE SERVICE LATERAL SECTION THIS PAGE

EXCAVATE AT BELLS FOR UNIFORM SUPPORT ALONG PIPE LENGTH

SERVICE LATERAL DETAIL

N.T.S.

7  
C-4

#	DESCRIPTION	DATE
1	CHANGE ORDER PROPOSAL REQUEST #1	1/23/2017

REVISIONS

SEWER SYSTEM RENOVATION:  
PROJECT NUMBERS: 08-408-11-01 PART 1 & 08-408-04B-01, PART 20 & 01-107-06B-11, Part U7  
BRIDGE CITY CENTER FOR YOUTH  
3225 RIVER ROAD  
BRIDGE CITY, LA 70044  
JOB NO.: 2156 DATE: 10/1/2016  
DRAWN BY: DPC CHECKED BY: BAN

SHEET TITLE:  
DETAILS

DRAWING NUMBER:

**C-4**