

**GENERAL HVAC
DETAIL NOTES**

1. ALL MECHANICAL WORK SHALL BE COORDINATED WITH THE WORK OF OTHER TRADES.
2. VERIFY ROUTING OF ALL WORK ON SITE.
3. HVAC CONTRACTOR REPLACE ALL EQUIPMENT FILTERS AT THE TIME OF POSSESSION OF THE PROJECT BY THE OWNER, USING ONLY NEW FILTERS OF THE PROPER SIZE AND TYPE.
4. CONTRACTOR SHALL LEAVE THE HVAC SYSTEM IN PROPER WORKING ORDER AND SHALL GUARANTEE SAME FOR A PERIOD OF TWELVE (12) MONTHS FROM THE DATE OF SUBSTANTIAL COMPLETION.
5. WHERE MOUNTING HEIGHTS ARE NOT INDICATED OR DIMENSIONED, INSTALL MECHANICAL SERVICES AND OVERHEAD EQUIPMENT TO PROVIDE THE MAXIMUM HEADROOM POSSIBLE.

DAMMON
ENGINEERING, INC.
LOUISIANA & MISSISSIPPI

Chief Engineer: Brian Wittich, PE
354 Old Spanish Trail
www.dammonengineering.com
info@dammonengineering.com

#	DESCRIPTION	DATE

SEAL:


HVAC REPLACEMENT
STATE POLICE TROOP L
HEADQUARTERS

PROJECT ADDRESS: 2812 DATE: 5/23/2018
JOB No: 18-0001


SHEET TITLE:
MECHANICAL DEMO PLAN

DRAWING NUMBER:
MD101

SHEET No: 00 of 8

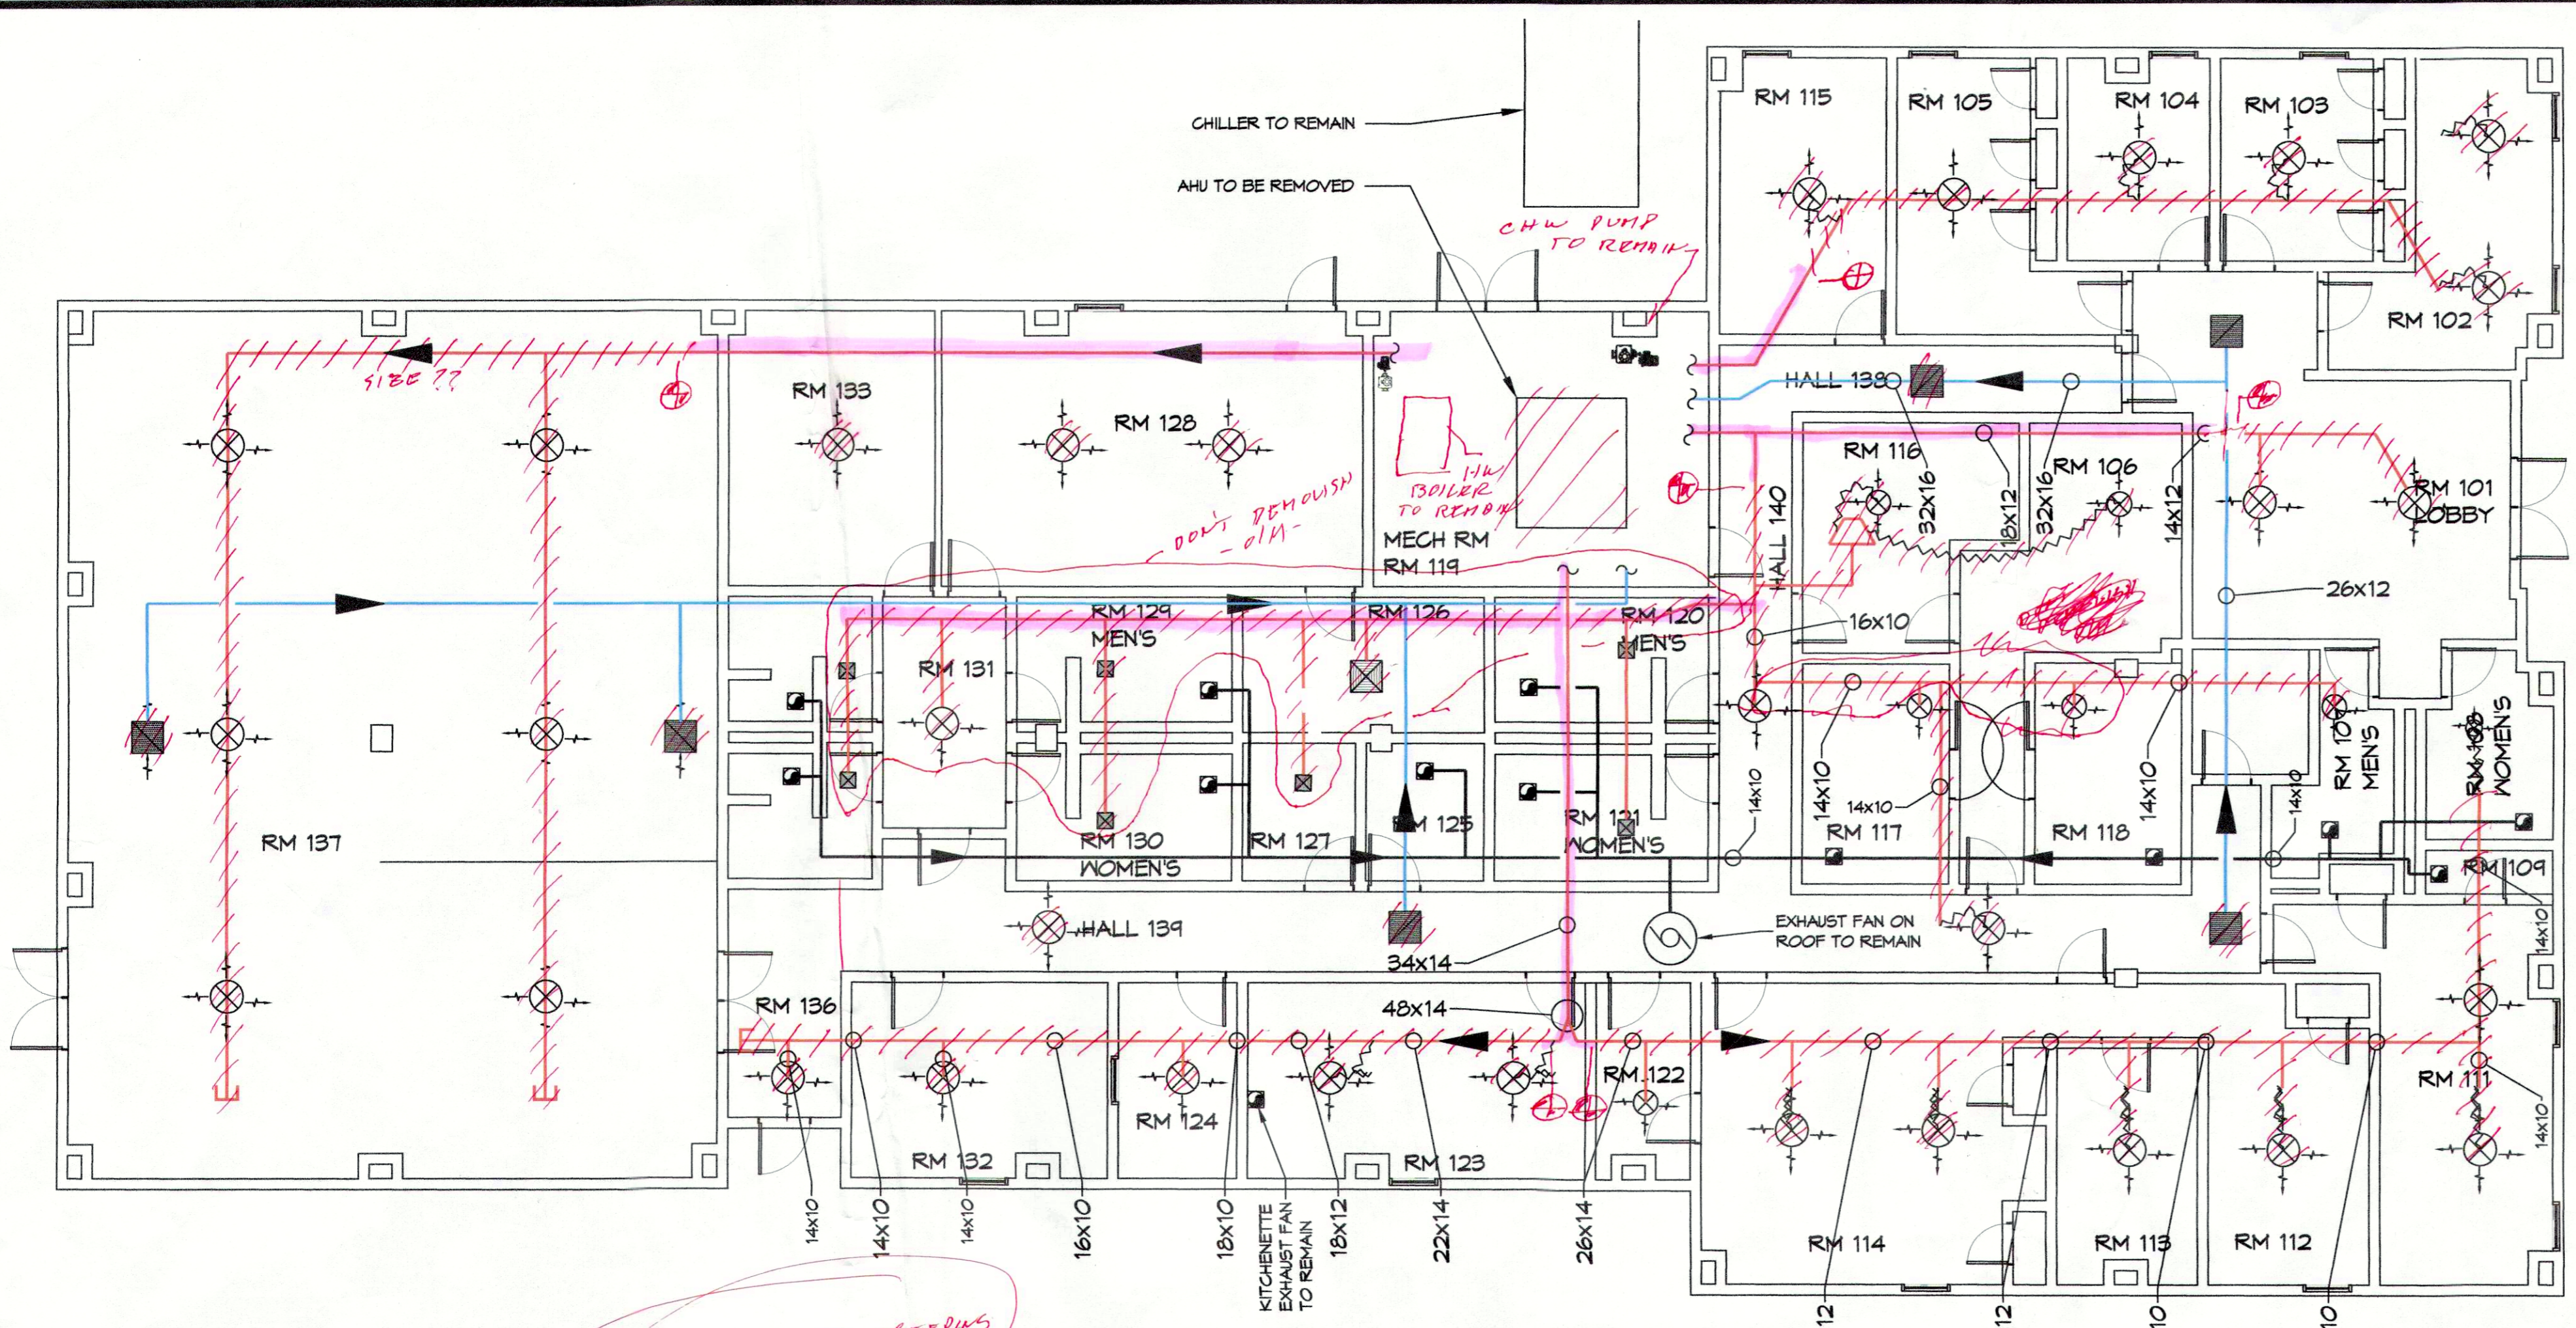

DEMOLITION PLAN

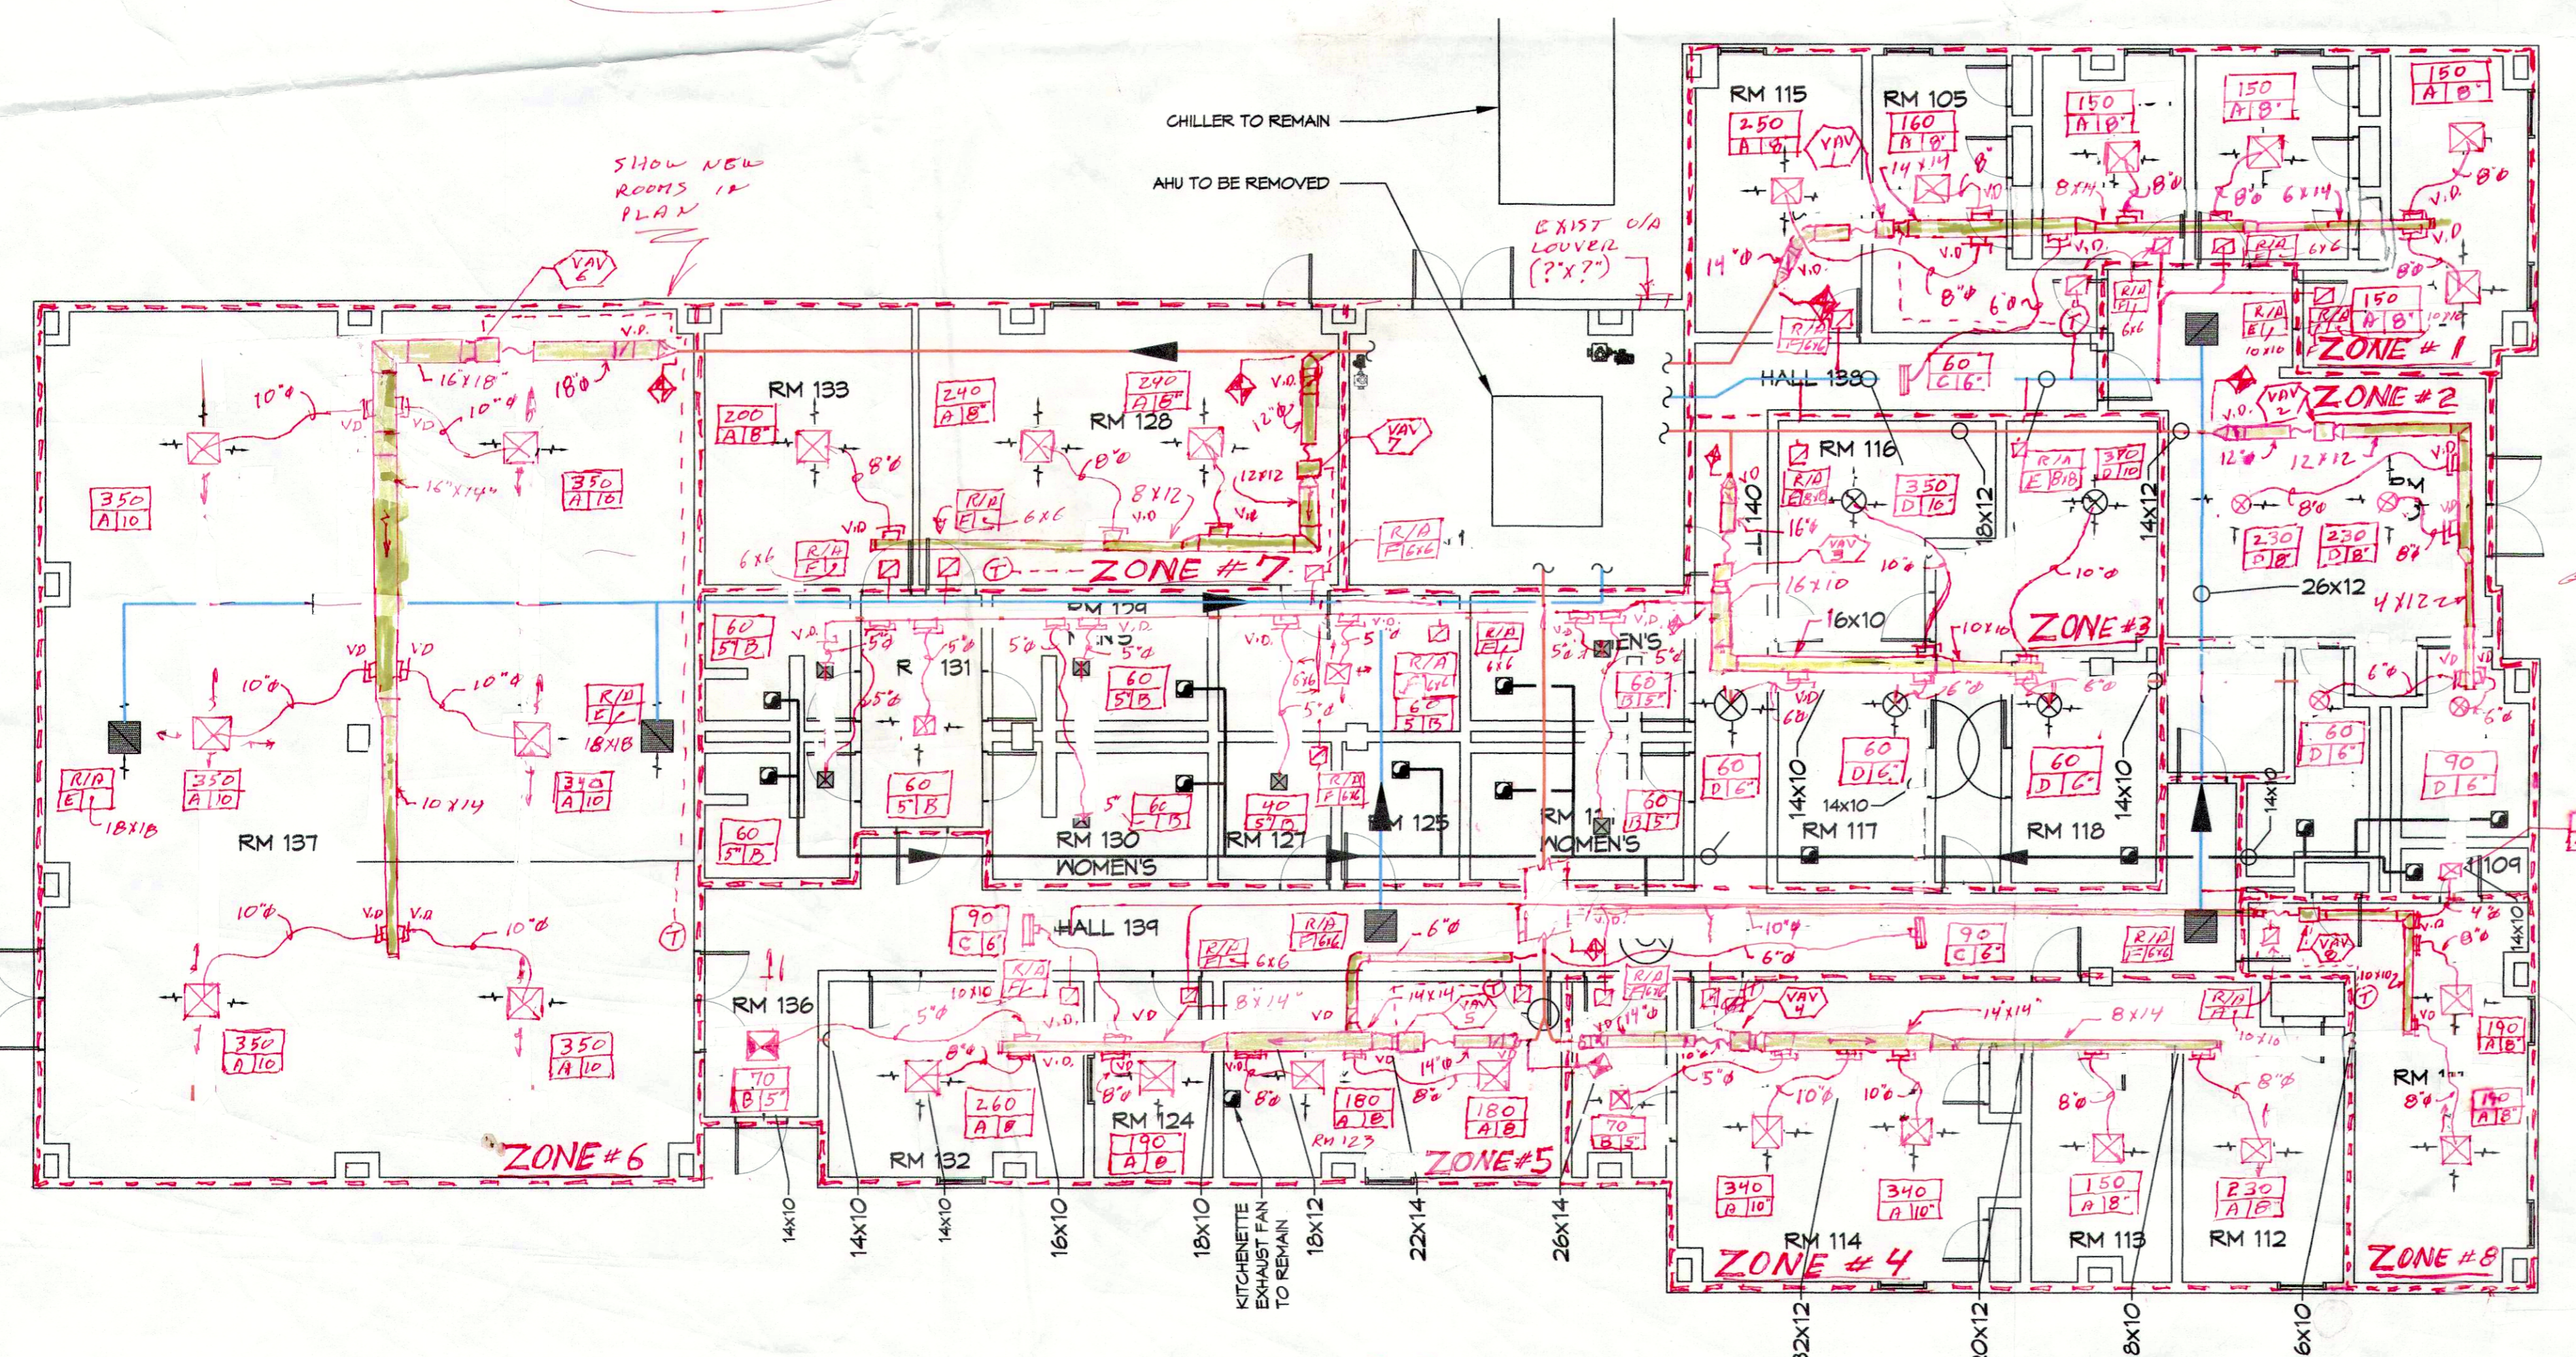

NEW PLAN

1 MECHANICAL DEMO PLAN
SCALE: 1/8" = 1'-0"

NEED LARGER VIEW (1/4")?