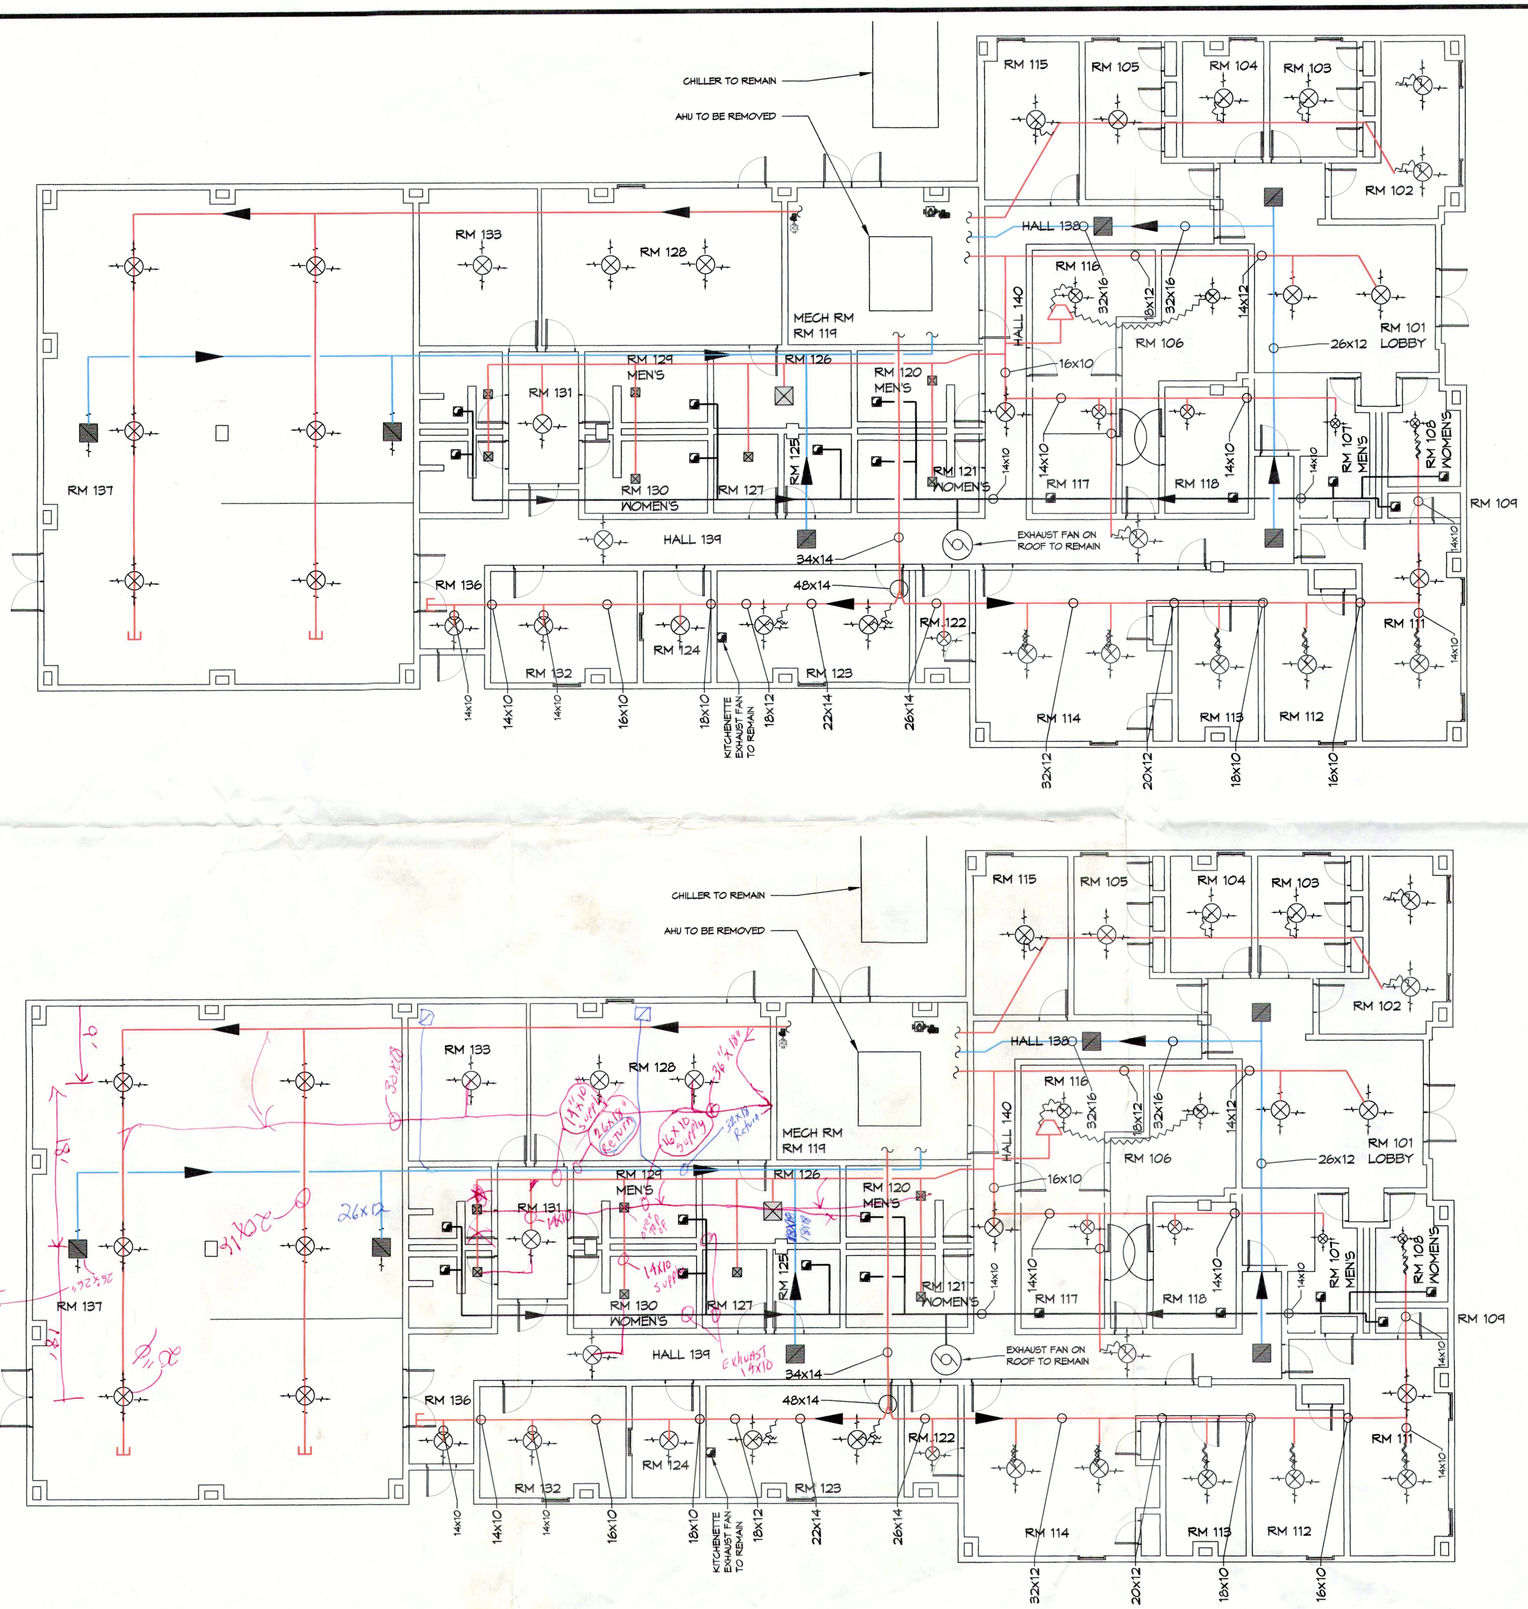

1 MECHANICAL DEMO PLAN
SCALE: 1/8" = 1'-0"

ZONES

GENERAL HVAC DETAIL NOTES

1. ALL MECHANICAL WORK SHALL BE COORDINATED WITH THE WORK OF OTHER TRADES.
2. VERIFY ROUTING OF ALL WORK ON SITE.
3. HVAC CONTRACTOR REPLACE ALL EQUIPMENT FILTERS AT THE TIME OF POSSESSION OF THE PROJECT BY THE OWNER, USING ONLY NEW FILTERS OF THE PROPER SIZE AND TYPE.
4. CONTRACTOR SHALL LEAVE THE HVAC SYSTEM IN PROPER WORKING ORDER AND SHALL GUARANTEE SAME FOR A PERIOD OF TWELVE (12) MONTHS FROM THE DATE OF SUBSTANTIAL COMPLETION.
5. WHERE MOUNTING HEIGHTS ARE NOT INDICATED OR DIMENSIONED, INSTALL MECHANICAL SERVICES AND OVERHEAD EQUIPMENT TO PROVIDE THE MAXIMUM HEADROOM POSSIBLE.

DAMMON ENGINEERING, INC.
LOUISIANA & MISSISSIPPI
www.dammonengineering.com
info@dammonengineering.com
Chief Engineer: Brian Mitsch, PE
550 Old Spanish Trail

REVISIONS

#	DESCRIPTION	DATE

SEAL:

HVAC REPLACEMENT
STATE POLICE TROOP L
HEADQUARTERS

[PROJECT ADDRESS]

JOB No: 2372 DATE: 5/3/2019

The ideas, designs and arrangements of plans, specifications and drawings prepared by the engineer are and shall remain the property of the engineer whether the project for which they are made has been executed or not. They are not to be used by the owner or others on extensions of this project or on any other project except by agreement in writing and with appropriate compensation to the engineer.

SHEET TITLE:
MECHANICAL DEMO PLAN

DRAWING NUMBER:

MD101

SHEET No: 00 of #

FILE NAME: x:\2019\2372 — Troop L Baton Rouge\HVAC Renovation\Drawings\Current Drawings\MD101 — Mechanical Demo.dwg, 5/3/2019 7:33:54 AM, Wednesday, June 5, 2019, PLOT STYLE: None