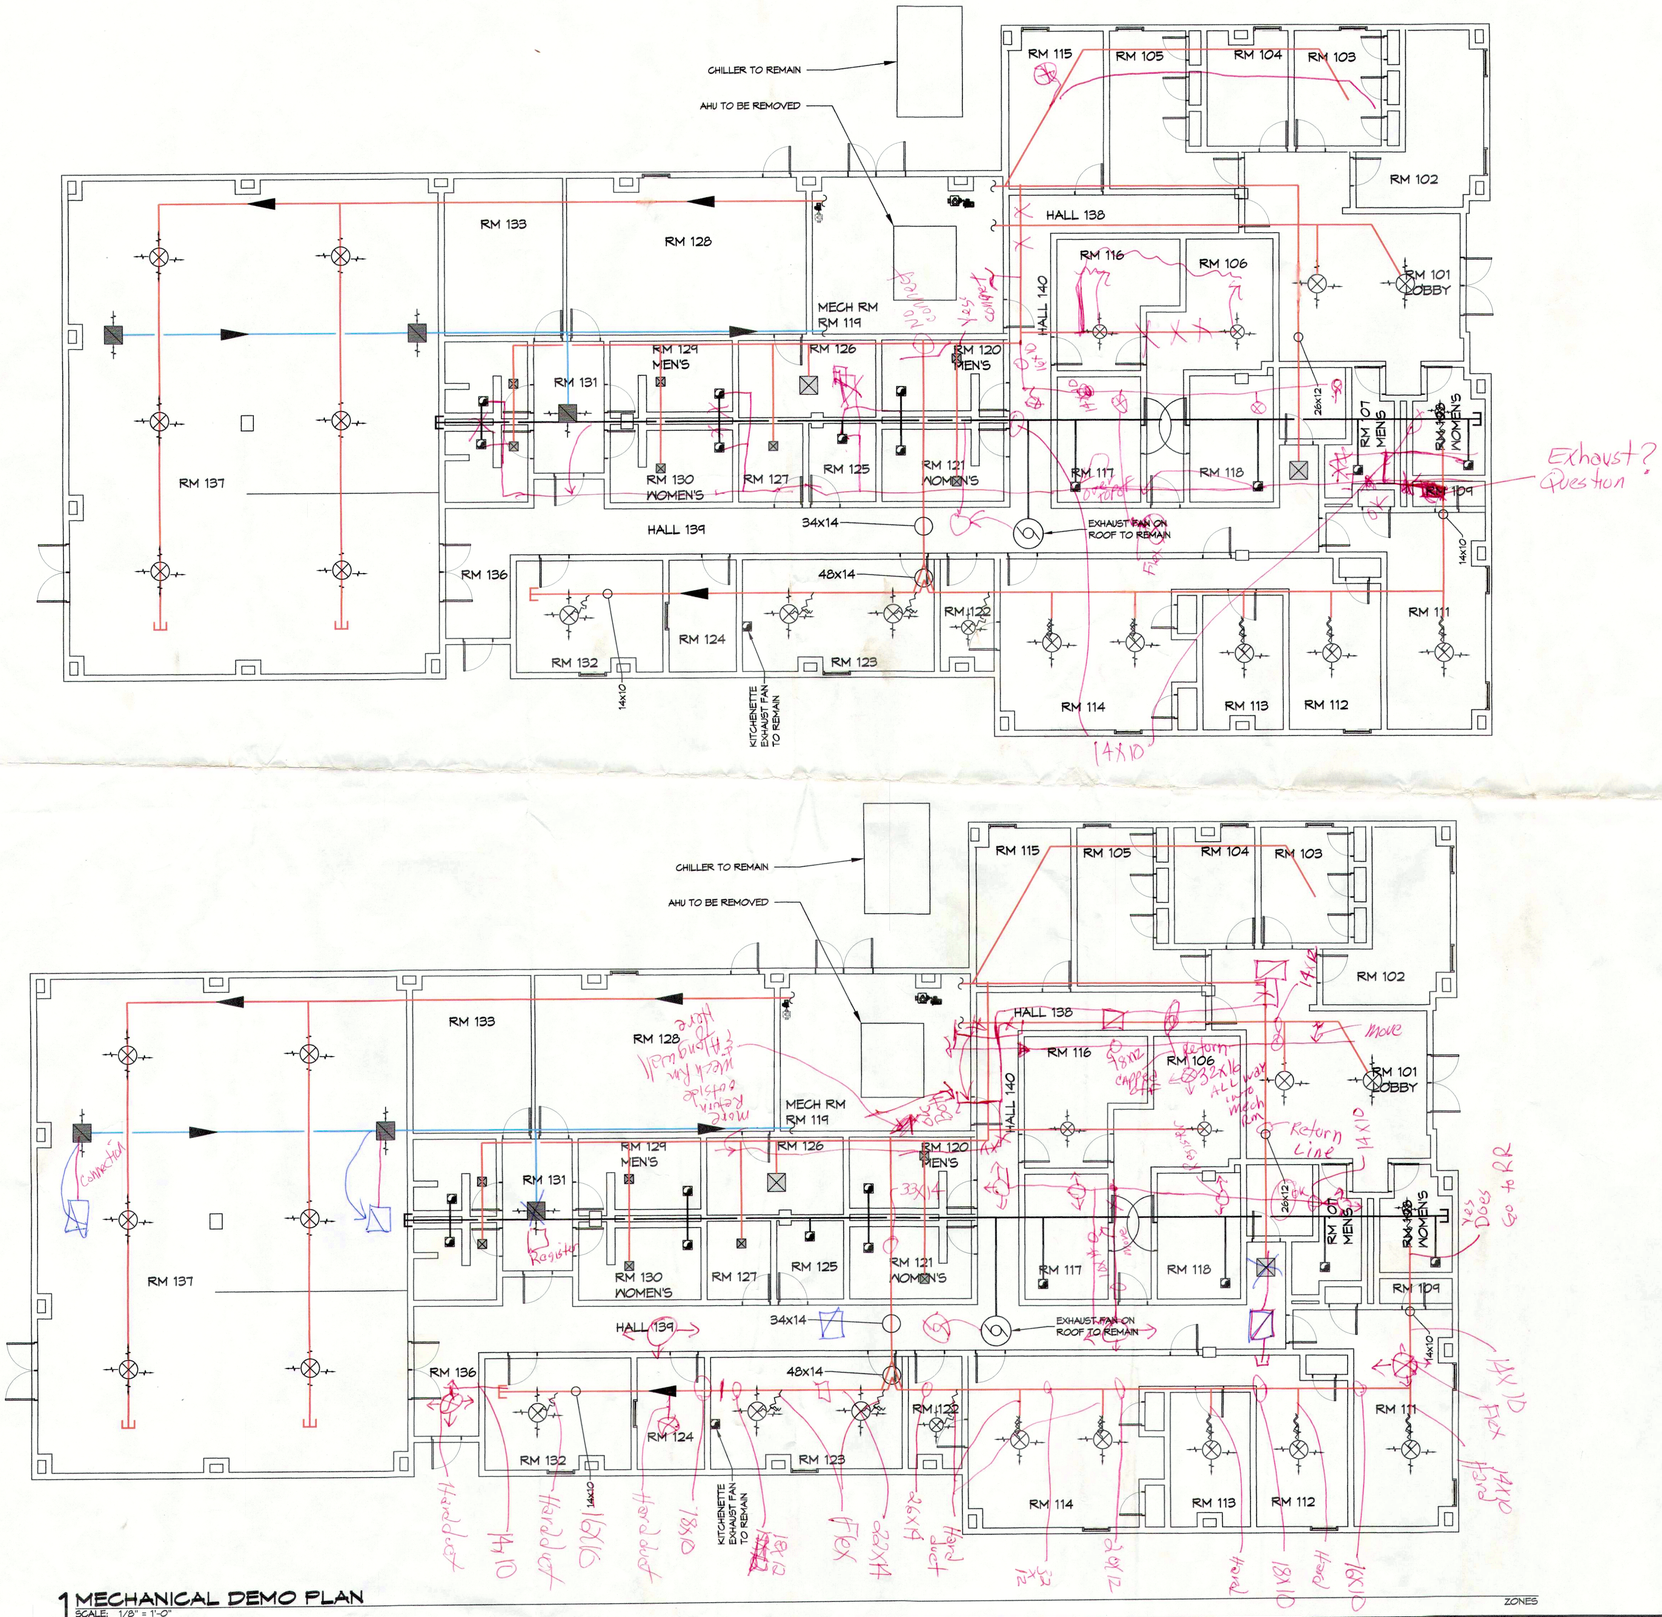

1 MECHANICAL DEMO PLAN
SCALE: 1/8" = 1'-0"

ZONES

GENERAL HVAC DETAIL NOTES

1. ALL MECHANICAL WORK SHALL BE COORDINATED WITH THE WORK OF OTHER TRADES.
2. VERIFY ROUTING OF ALL WORK ON SITE.
3. HVAC CONTRACTOR REPLACE ALL EQUIPMENT FILTERS AT THE TIME OF POSSESSION OF THE PROJECT BY THE OWNER, USING ONLY NEW FILTERS OF THE PROPER SIZE AND TYPE.
4. CONTRACTOR SHALL LEAVE THE HVAC SYSTEM IN PROPER WORKING ORDER AND SHALL GUARANTEE SAME FOR A PERIOD OF TWELVE (12) MONTHS FROM THE DATE OF SUBSTANTIAL COMPLETION.
5. WHERE MOUNTING HEIGHTS ARE NOT INDICATED OR DIMENSIONED, INSTALL MECHANICAL SERVICES AND OVERHEAD EQUIPMENT TO PROVIDE THE MAXIMUM HEADROOM POSSIBLE.

DAMMON ENGINEERING, INC.
LOUISIANA & MISSISSIPPI
www.dammonengineering.com
info@dammonengineering.com
Chief Engineer: Brian Mistich, PE
504 Old Spanish Trail

#	DESCRIPTION	DATE

REVISIONS

SEAL:

HVAC REPLACEMENT
STATE POLICE TROOP L
HEADQUARTERS

[PROJECT ADDRESS]

JOB No: 2372 DATE: 5/3/2019

The above drawings, plans and specifications, regardless of their form and character, are and remain the property of Dammon Engineering, Inc. and may not be used for any purpose other than that specifically agreed to by Dammon Engineering, Inc. in writing. Any other use, reproduction or distribution of the drawings, plans and specifications without written consent of Dammon Engineering, Inc. is prohibited.

SHEET TITLE:
MECHANICAL DEMO PLAN

DRAWING NUMBER:

MD101 (

SHEET No: 00 of #

FILE NAME: J:\In Dammon\2372 - Troop L State Police HVAC Renovation\Drawings\Current Drawings\MD101 - Mechanical Demo.dwg PLOT DATE & TIME: Thursday, May 30, 2019 8:10:36 AM