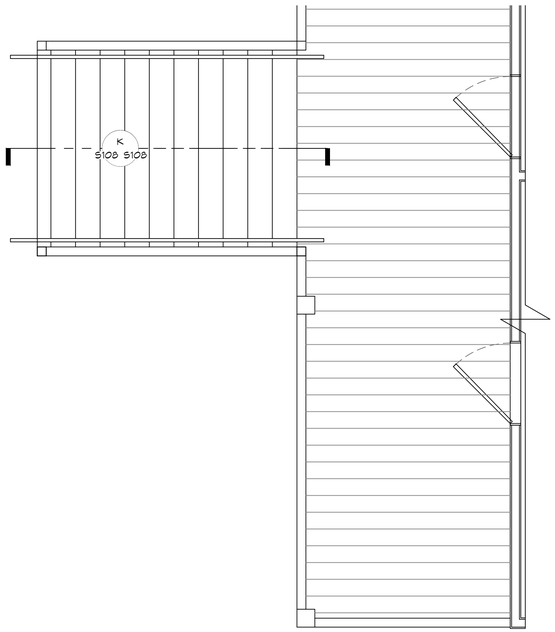

25 BACK PORCH PLAN VIEW
SCALE: 3/8"=1'-0"

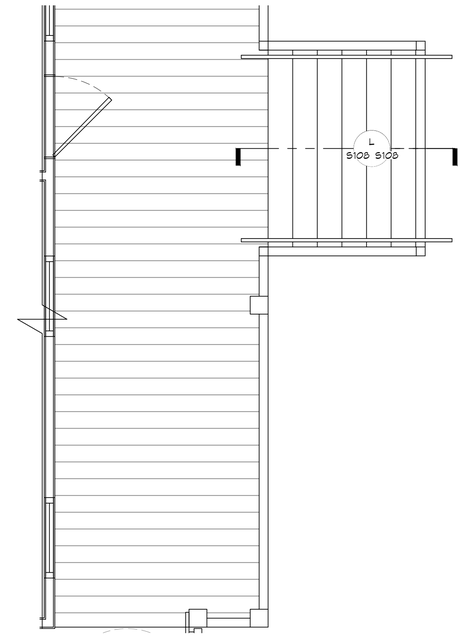

26 FRONT PORCH PLAN VIEW
SCALE: 3/8"=1'-0"

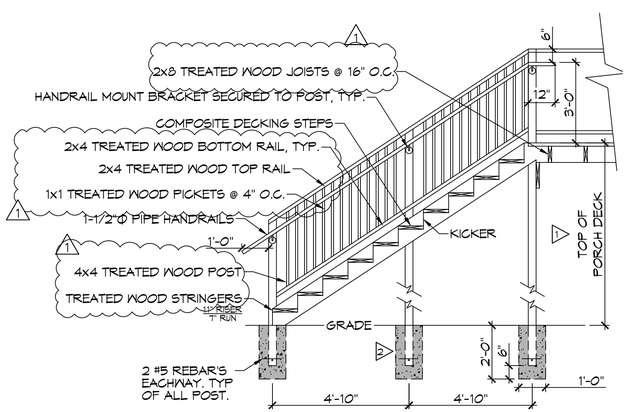

K REAR STAIR SECTION
S108 | S108 SCALE: 3/8" = 1'-0"

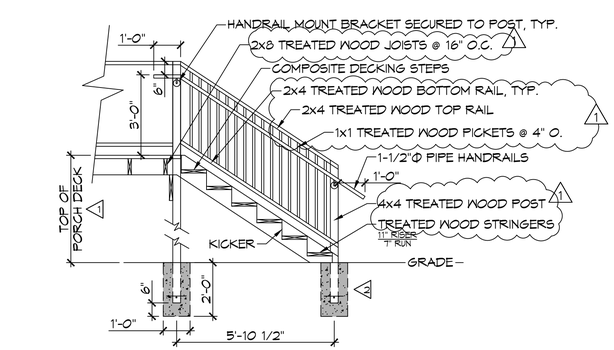

L FRONT STAIR SECTION
S108 | S108 SCALE: 3/8" = 1'-0"

GENERAL NOTES

1. FIELD VERIFY HEIGHT TO MATCH BUILDING
2. 4000 PSI CAST IN PLACE CONCRETE FOOTING

DAMMON ENGINEERING, INC.
LOUISIANA & MISSISSIPPI
www.dammonengineering.com
info@dammonengineering.com
PH: 985.649.5832

Chief Engineer: Brian Mistich, PE
5404 Sawyer Trail
Slidell, LA 70458

REVISIONS

#	DESCRIPTION	DATE
1	S107 - Revised Treated Lumber for Framing Stairs	09/30/2022

STATE OF LOUISIANA
BRIAN A. MISTICH
License No. 30161
PROFESSIONAL ENGINEER

ST. TAMMANY FIRE PROTECTION DISTRICT NO. 1

FIRE STATION 19

5'0341 ALLEN ROAD
SLIDELL, LOUISIANA 70461

JOB No:	2456	DATE:	05-16-2022
DRAWN BY:	CAD	CHECKED BY:	BAM

THE ABOVE DESIGN, DRAWINGS AND SPECIFICATIONS ARE THE PROPERTY OF DAMMON ENGINEERING, INC. AND SHALL NOT BE REPRODUCED, PUBLISHED OR USED IN WHOLE OR IN PART FOR ANY PURPOSE WHATSOEVER WITHOUT THE WRITTEN CONSENT OF DAMMON ENGINEERING, INC. ANY PROJECT IN WHICH THE WORK SHOWN IN THIS DOCUMENT IS EMPLOYED OR ATTEMPTED WITHOUT WRITTEN CONSENT OF DAMMON ENGINEERING, INC. SHALL BE ILLEGAL AND A VIOLATION OF THE RIGHTS OF DAMMON ENGINEERING, INC.

SHEET TITLE:
ADA STAIR PLAN

DRAWING NUMBER:
S108

SHEET No: 13 of 30

AS-BUILT
1-31-24