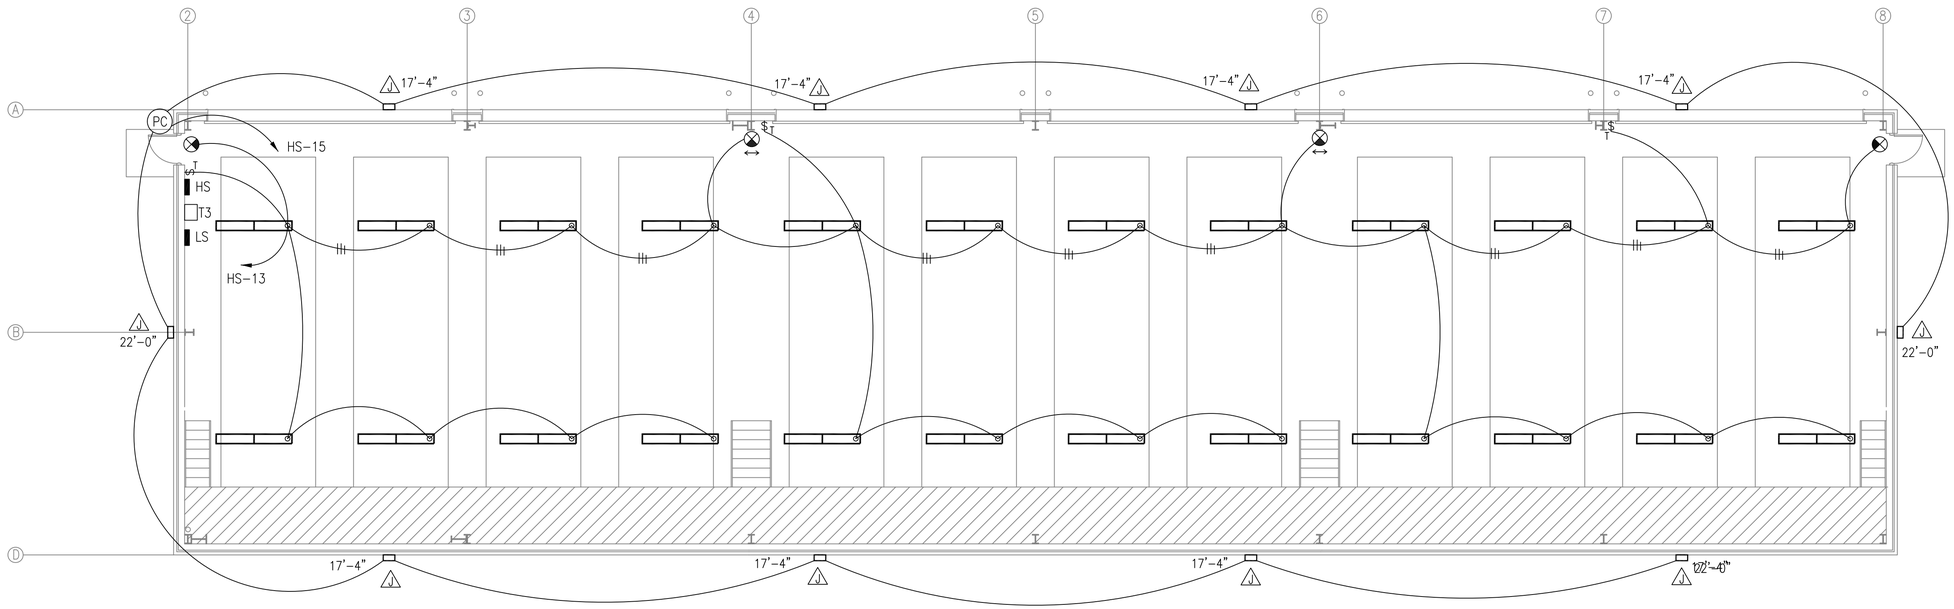

BOAT STORAGE BLDG. 2442
FLOOR PLAN - LIGHTING
SCALE: 1/8"=1'-0"

0 4' 8' 16'

PLAN NORTH

GENERAL NOTES THIS SHEET:

1. ALL FIXTURES TYPE N UNLESS NOTED OTHERWISE.
2. ALL WIRING SHALL BE 3/4"C: 2-#12 AWG AND 1-#12 GRD UNLESS NOTED OTHERWISE.
3. ALL CONDUIT SHALL CONTAIN MINIMUM #12 AWG GROUND WIRE UNLESS NOTED OTHERWISE.
4. ALL MOUNTING HEIGHTS SHOWN ARE TO BOTTOM OF FIXTURE AS MEASURED FROM FINISHED FLOOR ELEVATION.
5. ALL TYPE N FIXTURES SHALL BE MOUNTED 21'-8" AFF.
6. ALL LIGHT SWITCHES SHALL HAVE INTEGRAL TIMERS, MAXIMUM SETTING 4 HOURS. INTERMATIC FF4H.

RECORD DRAWING
LETTER DATED
5-27-10

AS-BUILT REVISIONS	DESCRIPTION	DATE	APPR
		5-27-10	

NAVFAC

SCHLAFLY ENGINEERING LLC
121 SOUTH GENOIS STREET
NEW ORLEANS LA 70119
PHONE 504-415-3347
FAX 504-482-7943

M. KIMBALL SCHLAFLY, P.E.
LA REG 27699

SEPTEMBER 4, 2009

STATE OF LOUISIANA
M. KIMBALL SCHLAFLY
REG. No. 27699
REGISTERED PROFESSIONAL ENGINEER
IN
ELECTRICAL ENGINEERING
SEAL

DES: K. SCHLAFLY | DRW: K. SCHLAFLY
REVIEWED BY: R. WILTSE
PM/DM: T. ARTRIP
CHIEF ENG/ARCH: P. DAMMON

DEPARTMENT OF THE NAVY
NAVAL FACILITIES ENGINEERING COMMAND SOUTHEAST
IPT SOUTH ATLANTIC

NAVAL FACILITIES ENGINEERING COMMAND SOUTHEAST
NAVAL AIR STATION JACKSONVILLE

JOHN C. STENNIS SPACE CENTER MISSISSIPPI

SOF RIVERINE AND COMBATANT CRAFT OPERATIONS FACILITY

BLDG 2442 FLOOR PLAN - LIGHTING

CODE ID. NO. N4412	SIZE D
SCALE:	1/8" =1'-0"
MAXIMO NO,	######
STA. PROJ. NO.	P-210
WORK ORDER NO.	510247
CONSTR. CONTR. NO.	N62467-05-D-0096
NAVFAC DRAWING NO.	15026759
SHEET	112 OF 132

E3.3

DRAWFORM REVISION: 01 JAN 2009

REVDATE: FILE NAME: C:\Schlafly ENGR 08010 SOF Riverine \Drawings Elec 5-As-builts E3.1.dwg LAYOUT NAME: E3.3 PLOTTED: Friday, May 28, 2010 - 3:10pm