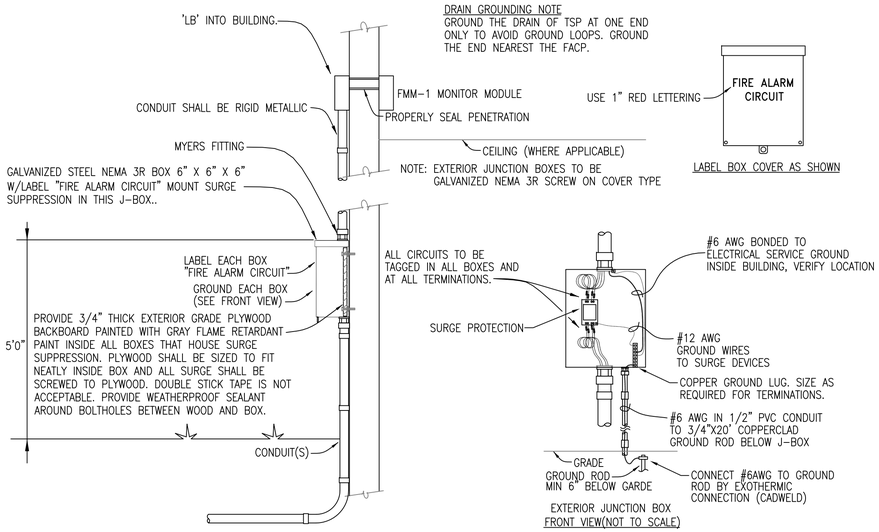

1 FA1.5 FA1.5 EXTERIOR COPPER FIRE ALARM CIRCUIT DETAIL

SCALE: NONE

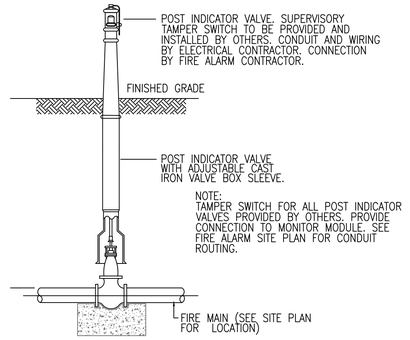

2 FA1.5 FA1.5 POST INDICATOR VALVE CONNECTION DETAIL

SCALE: NONE

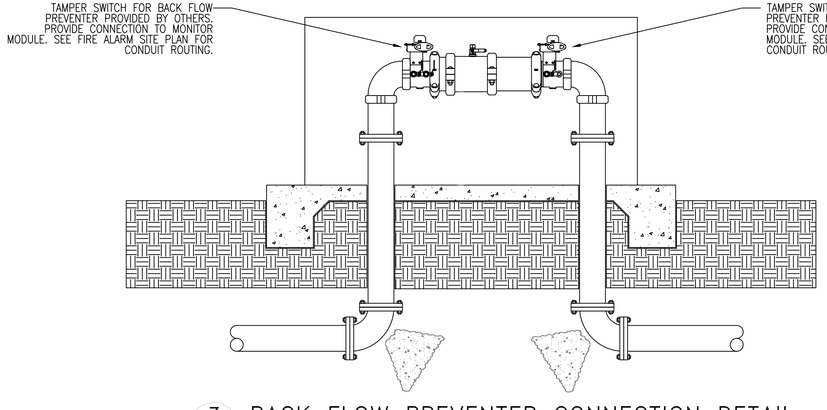

3 FA1.5 FA1.5 BACK FLOW PREVENTER CONNECTION DETAIL

SCALE: NONE

NICET CERTIFICATION
LARRY K. COOK
LEVEL IV / CERTIFICATION #75228
FIRE ALARM PROTECTION / FIRE ALARM SYS
EXPIRATION DATE: MARCH 01,2011

AS-BUILT
6-4-2010

APPR	DATE	DESCRIPTION	SYM
	2/26/2010	REVISED PER URS AND NAVFAC COMMENTS	

SEAL

DES:	DRW:
REVIEWED BY: R. WILTSE	
PM/DM: T. ARTRIP	
CHIEF ENG/ARCH: P. DAMMON	

DEPARTMENT OF THE NAVY
NAVAL FACILITIES ENGINEERING COMMAND SOUTHEAST
IPT SOUTH ATLANTIC
NAVAL FACILITIES ENGINEERING COMMAND
NAVAL AIR STATION JACKSONVILLE
JOHN C. STENNIS SPACE CENTER
MISSISSIPPI

SOF RIVERINE AND COMBATANT CRAFT OPERATIONS FACILITY

FIRE ALARM CONNECTION DETAILS

CODE ID. NO. N4412	SIZE D
SCALE:	1/8"=1'-0"
MAXIMO NO.	######
STA. PROJ. NO.	P-210
WORK ORDER NO.	510247
CONSTR. CONTR. NO.	N62467-05-D-0096
NAVFAC DRAWING NO.	######-##-#-####
SHEET	XXX OF XXX

FA1.5

DRAWFORM REVISION: 01 JAN 2009

REVDATE: FILE NAME: C:\Schlafly ENGR\08010 SOF Riverine\Drawings\Elec\5-As-builts\ACC\10-06-04\FA1.4-1.5 as-builts.dwg LAYOUT NAME: FA1.5 PLOTTED: Wednesday, June 09, 2010 - 1:07pm