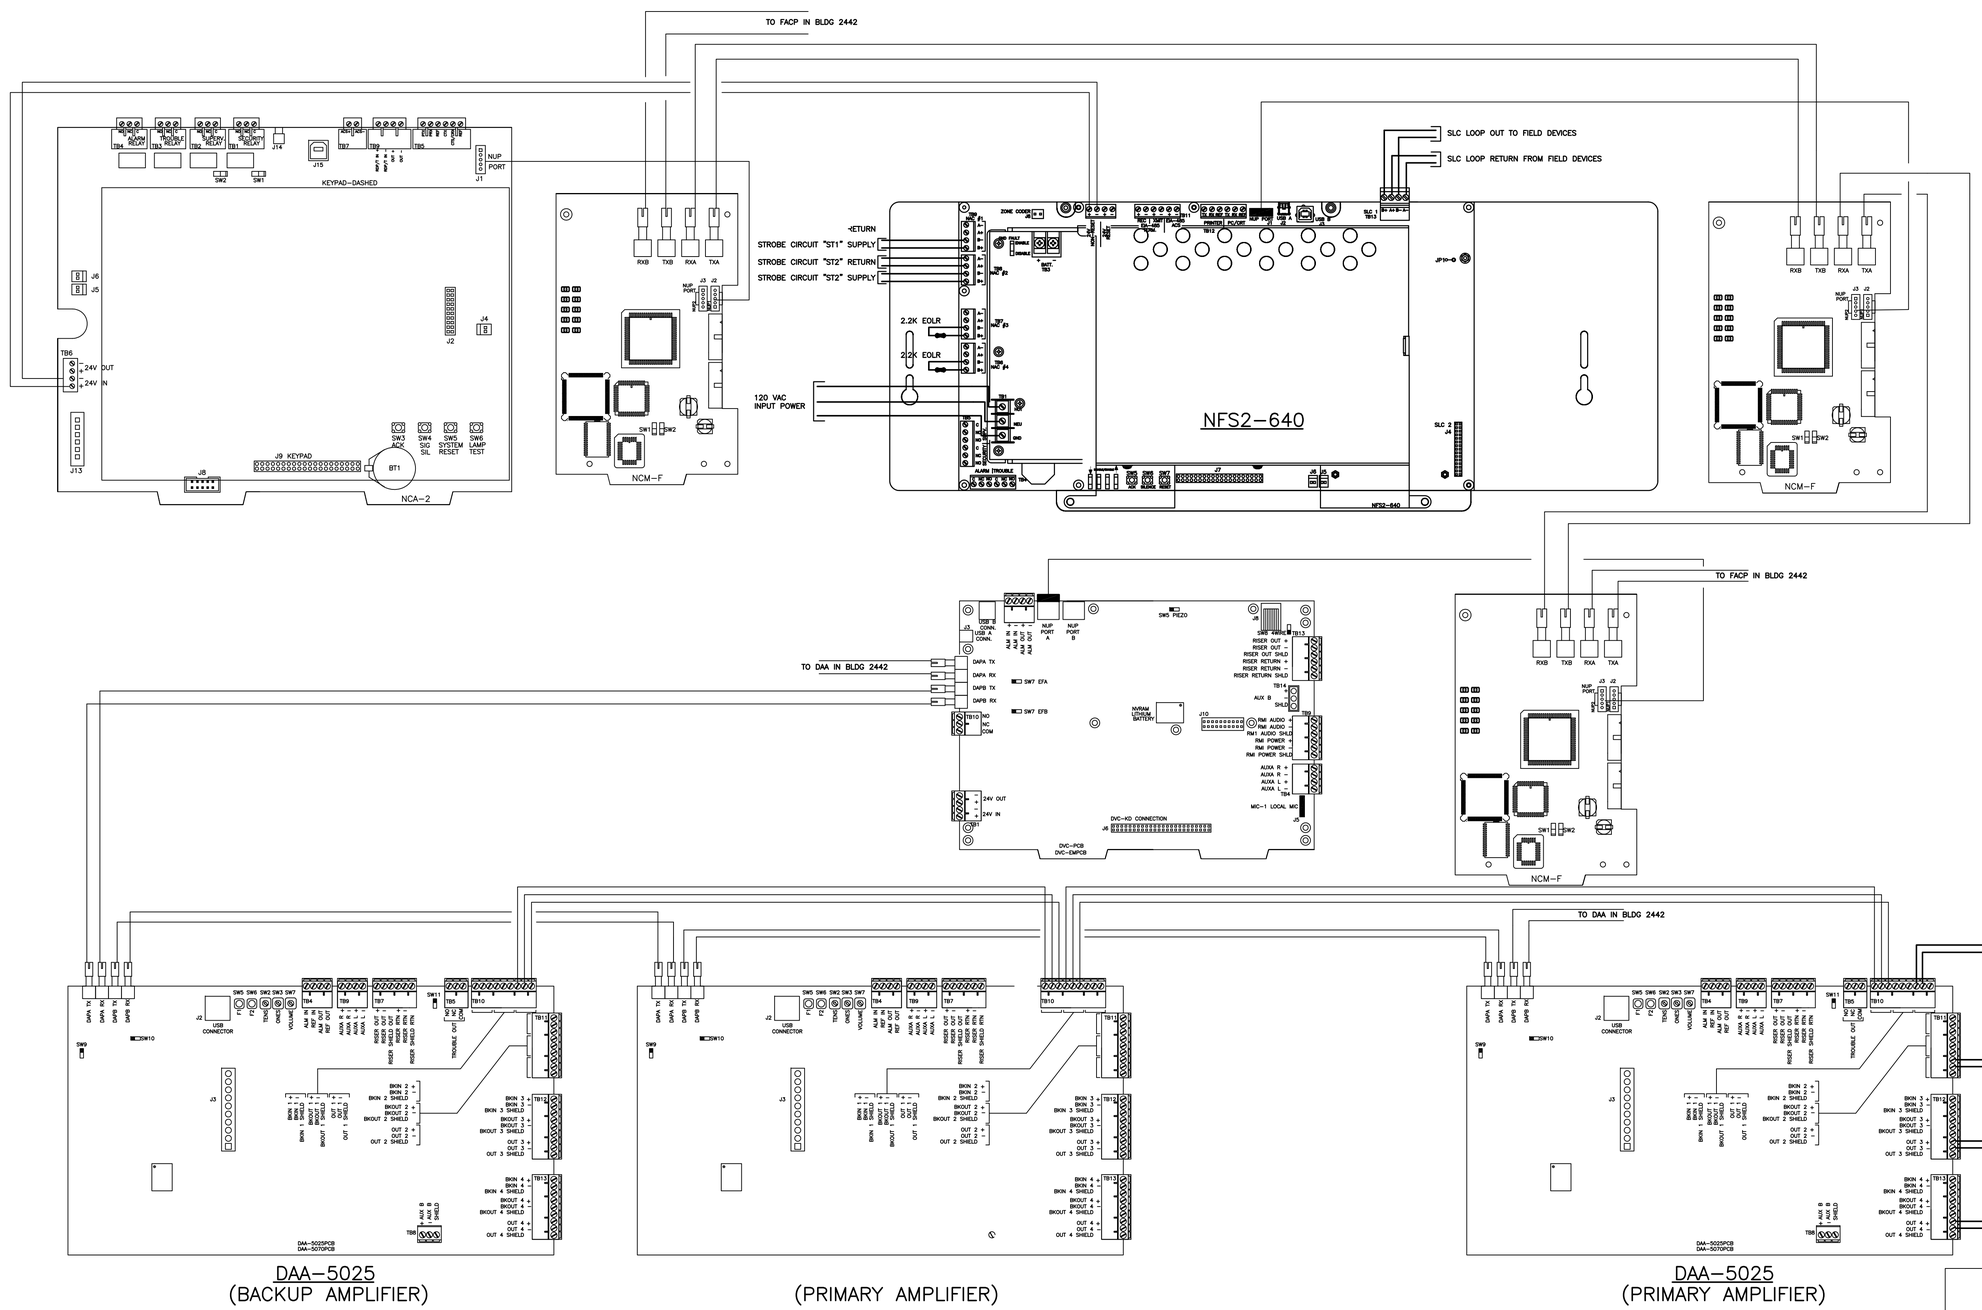

1 FA1.7 BLDG 2440 FACP WIRING DIAGRAM
SCALE: NOT TO SCALE

NICET CERTIFICATION
LARRY K. COOK
LEVEL IV / CERTIFICATION #75228
FIRE ALARM PROTECTION / FIRE ALARM SYS
EXPIRATION DATE: MARCH 01,2011

AS-BUILT
6-4-2010

SYM	DESCRIPTION	DATE	APPR
	REVISED PER URS AND NAVFAC COMMENTS	2/26/2010	

NAVFAC

SEAL

DES: DRW:
REVIEWED BY: R. WILTSE
PM/DM: T. ARTRIP
CHIEF ENG/ARCH: P. DAMMON

NAVAL FACILITIES ENGINEERING COMMAND
DEPARTMENT OF THE NAVY
NAVAL FACILITIES ENGINEERING COMMAND SOUTHEAST
PT SOUTH ATLANTIC
NAVAL AIR STATION JACKSONVILLE
JOHN C. STENNIS SPACE CENTER
MISSISSIPPI

SOF RIVERINE AND COMBATANT CRAFT OPERATIONS FACILITY

FIRE ALARM DEVICE CONNECTION DETAILS

CODE ID. NO. N4412	SIZE D
SCALE:	1/8"=1'-0"
MAXIMO NO.	######
STA. PROJ. NO.	P-210
WORK ORDER NO.	510247
CONSTR. CONTR. NO.	N62467-05-D-0096
NAVFAC DRAWING NO.	######-##-#-####
SHEET	XXX OF XXX

FA1.7

DRAWFORM REVISION: 01 JAN 2009

REVDATE: FILE NAME: C:\Schlafly ENGR\08010 SOF Riverine\Drawings\Elec\5-As-builts\ACC\10-06-04\FA5 Drawings as-builts.dwg LAYOUT NAME: FA1.7 PLOTTED: Wednesday, June 09, 2010 - 1:02pm