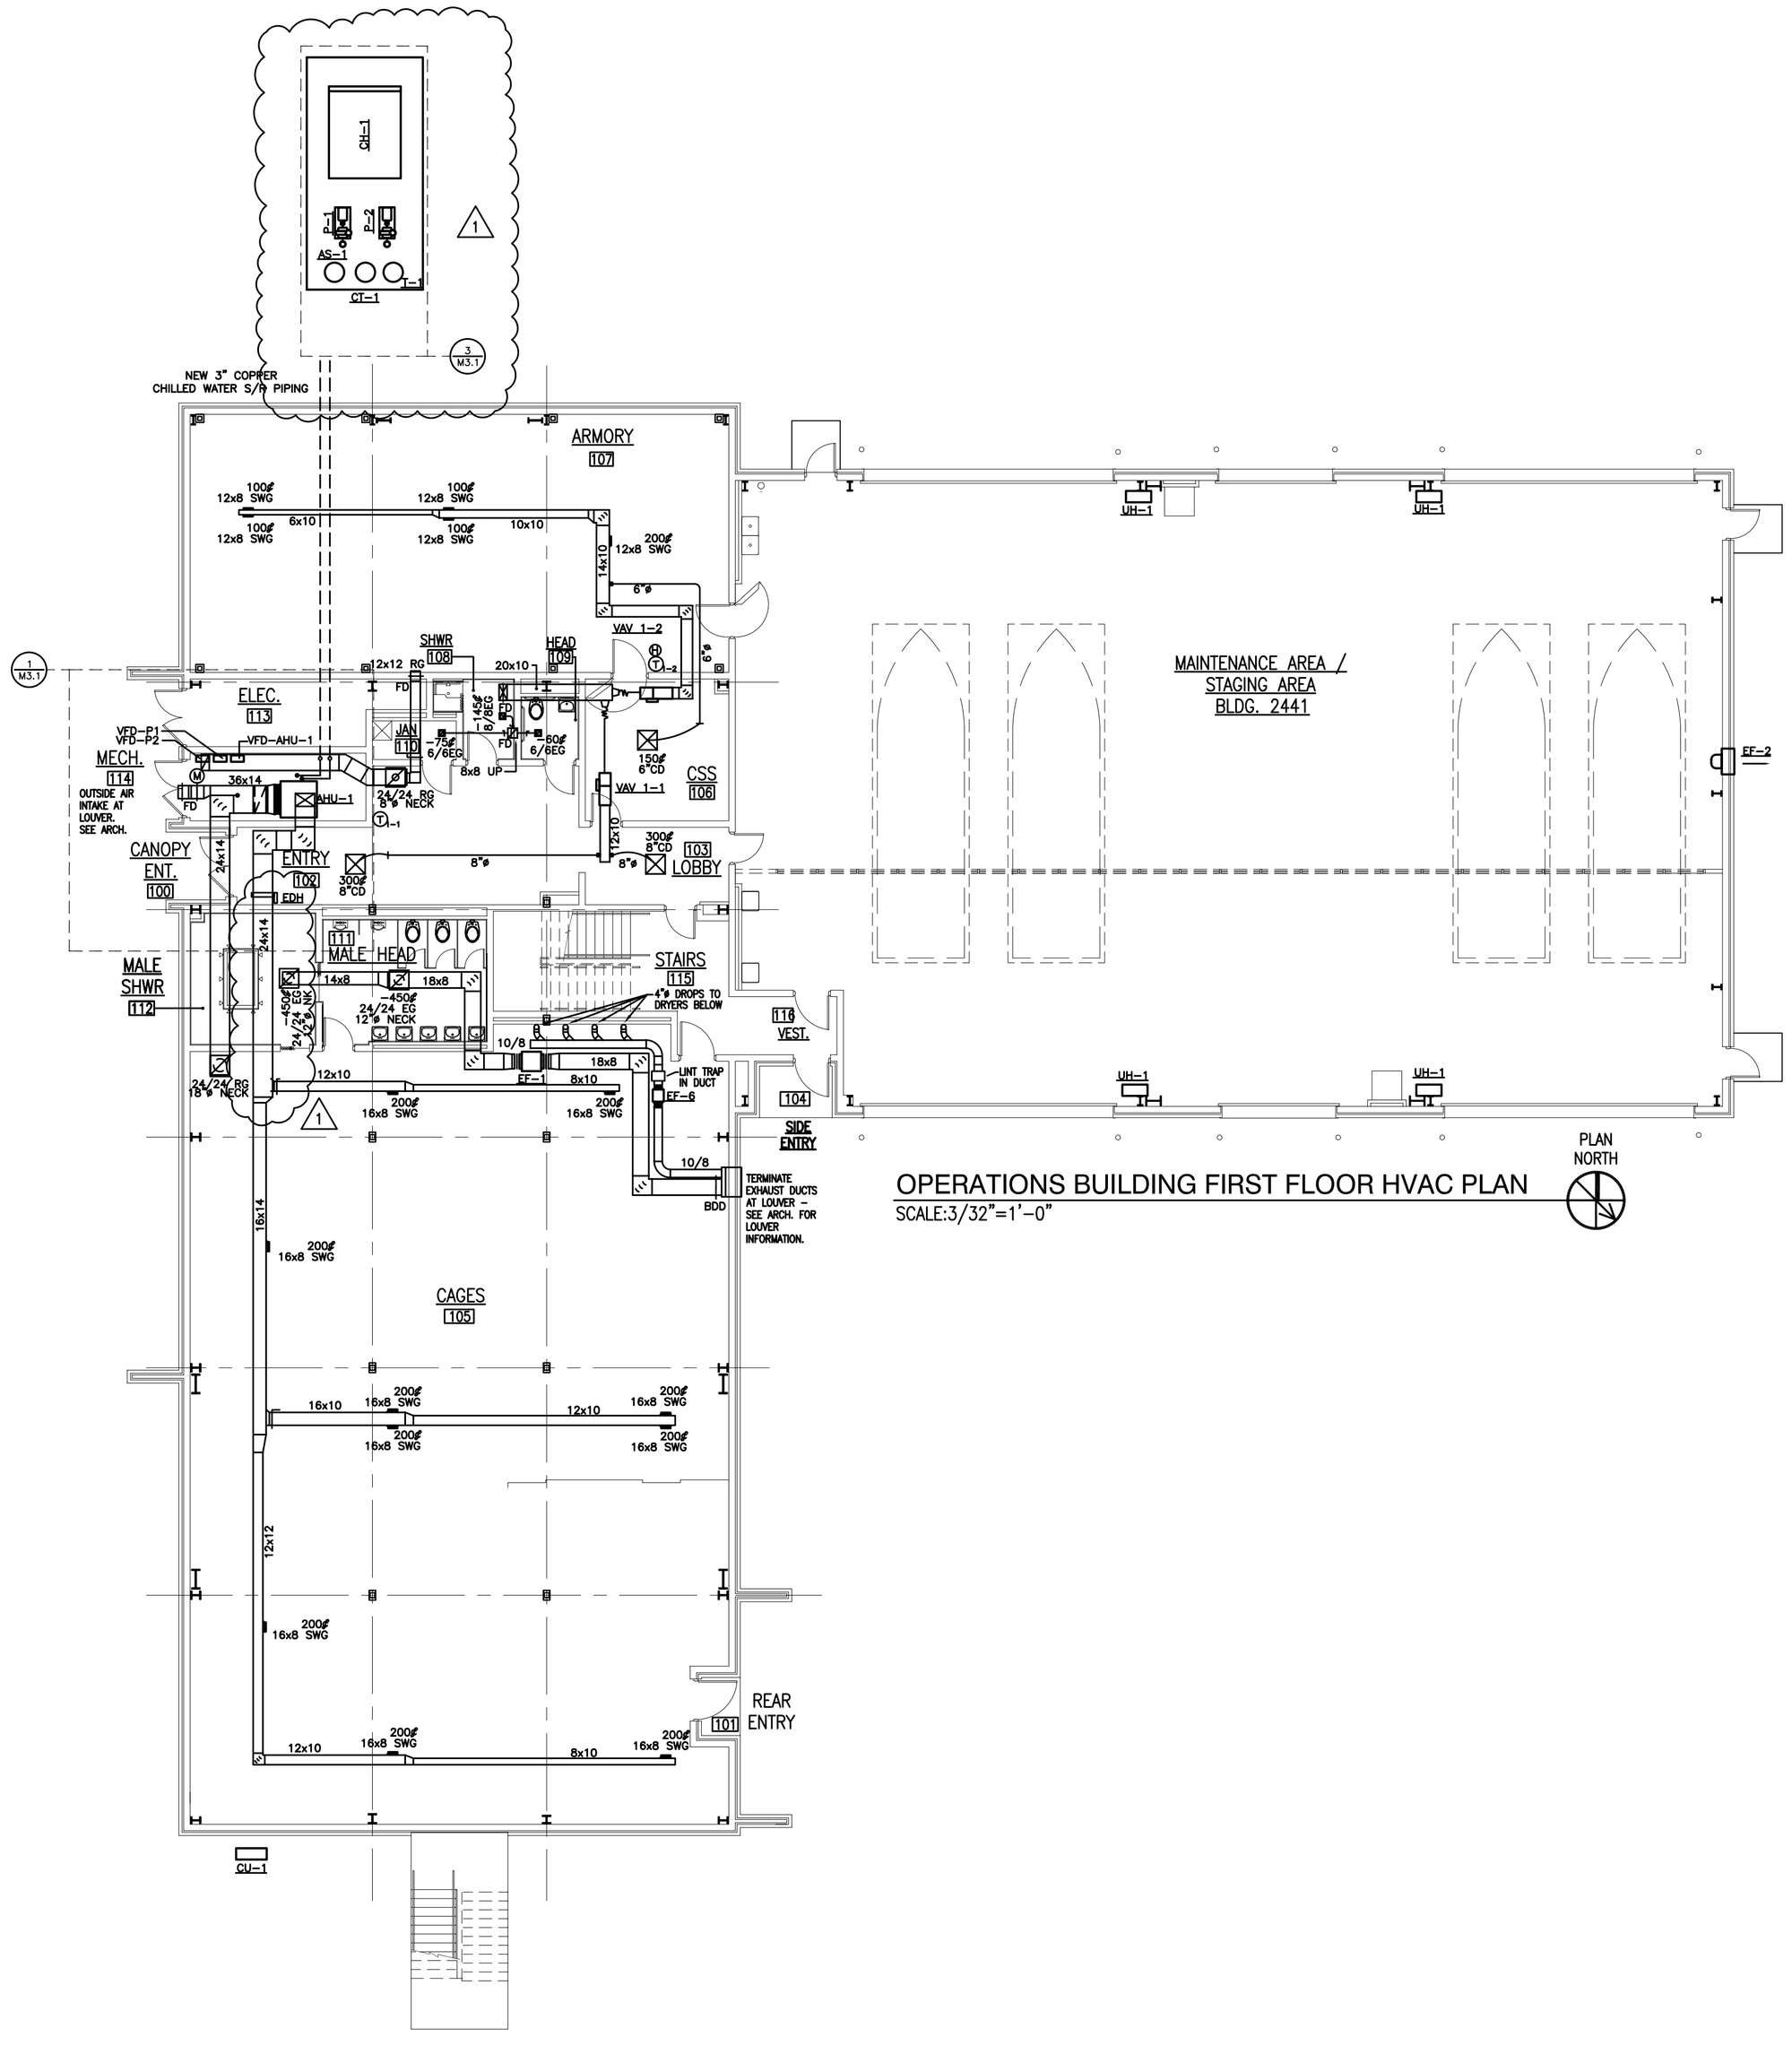

OPERATIONS BUILDING FIRST FLOOR HVAC PLAN
SCALE:3/32"=1'-0"

DAMIEN W. SERAUSKAS, P.E.
PROFESSIONAL ENGINEERING SERVICES
15 CYPRESS POINT LANE NEW ORLEANS, LA 70131
VOICE: (504)-866-2600 FAX: (504)-218-8480

1	AS-BUILT CONDITIONS SHOWN	06/10/2010	DWS	DWS		APPR
	RECORD DRAWING					
SYM	DESCRIPTION	DATE				

NAVFAC

DAMMON ENGINEERING, INC.
CHIEF ENGINEER EMMETT DAMMON, P.E.
CHIEF ARCHITECT ROBERT WILTSE
1095 FLORIDA AVENUE
SLIDELL, LA 70458
(985) 649-5832
SEPT 4, 2009

SEAL

REVIEWED BY: R. WILTSE
PM/DM: T. ARTRIP
CHIEF ENG/ARCH. P. DAMMON

DEPARTMENT OF THE NAVY
NAVAL FACILITIES ENGINEERING COMMAND
NAVAL FACILITIES ENGINEERING COMMAND SOUTHEAST
NAVAL AIR STATION JACKSONVILLE MISSISSIPPI
PT. GULF COAST
JOHN C. STENNIS SPACE CENTER
SOF RIVERINE AND COMBATANT CRAFT OPERATIONS FACILITY - PRE-FINAL
OPERATIONS BLDG FIRST FLOOR HVAC PLAN

CODE ID. NO. N4412	SIZE D
SCALE:	AS SHOWN
MAXIMO NO.	######
STA. PROJ. NO.	P-210
WORK ORDER NO.	510247
CONSTR. CONTR. NO.	N62467-05-D-0096
NAVFAC DRAWING NO.	15026732
SHEET 85 OF 132	

M1.1

DRAWFORM REVISION: 01 JAN 2009

REVDATE: FILE NAME: C:\Stennis Riverine Facility\Stennis Mechanical As-Built CAD.dwg LAYOUT NAME: M1.1 PLOTTED: Wednesday, June 09, 2010 - 6:14pm