


PARKING REQUIREMENTS:

1 SPACE PER 350 SQ.FT. OF OFFICE SPACE
 1 SPACE PER 750 SQ.FT. OF WAREHOUSE SPACE
 TOTAL REQUIRED=160
 TOTAL PROVIDED=162


LEGEND:

- - - - - PROPERTY LINE
- - - - - SETBACK LINE
- - - - - NEW BUILDING
- CLASS "A" TREE--MINIMUM OF 10' TO 12' HIGH. CALIPER OF 2-1/2" MEASURED AT 1-1/2 FT ABOVE THE GROUND
- CLASS "B" TREE--MINIMUM OF 8' TO 10' HIGH. CALIPER OF 1-1/2" MEASURED AT 1-1/2 FT ABOVE THE GROUND
- SHRUB

U . S . I N T E R S T A T E H W Y . 1 2

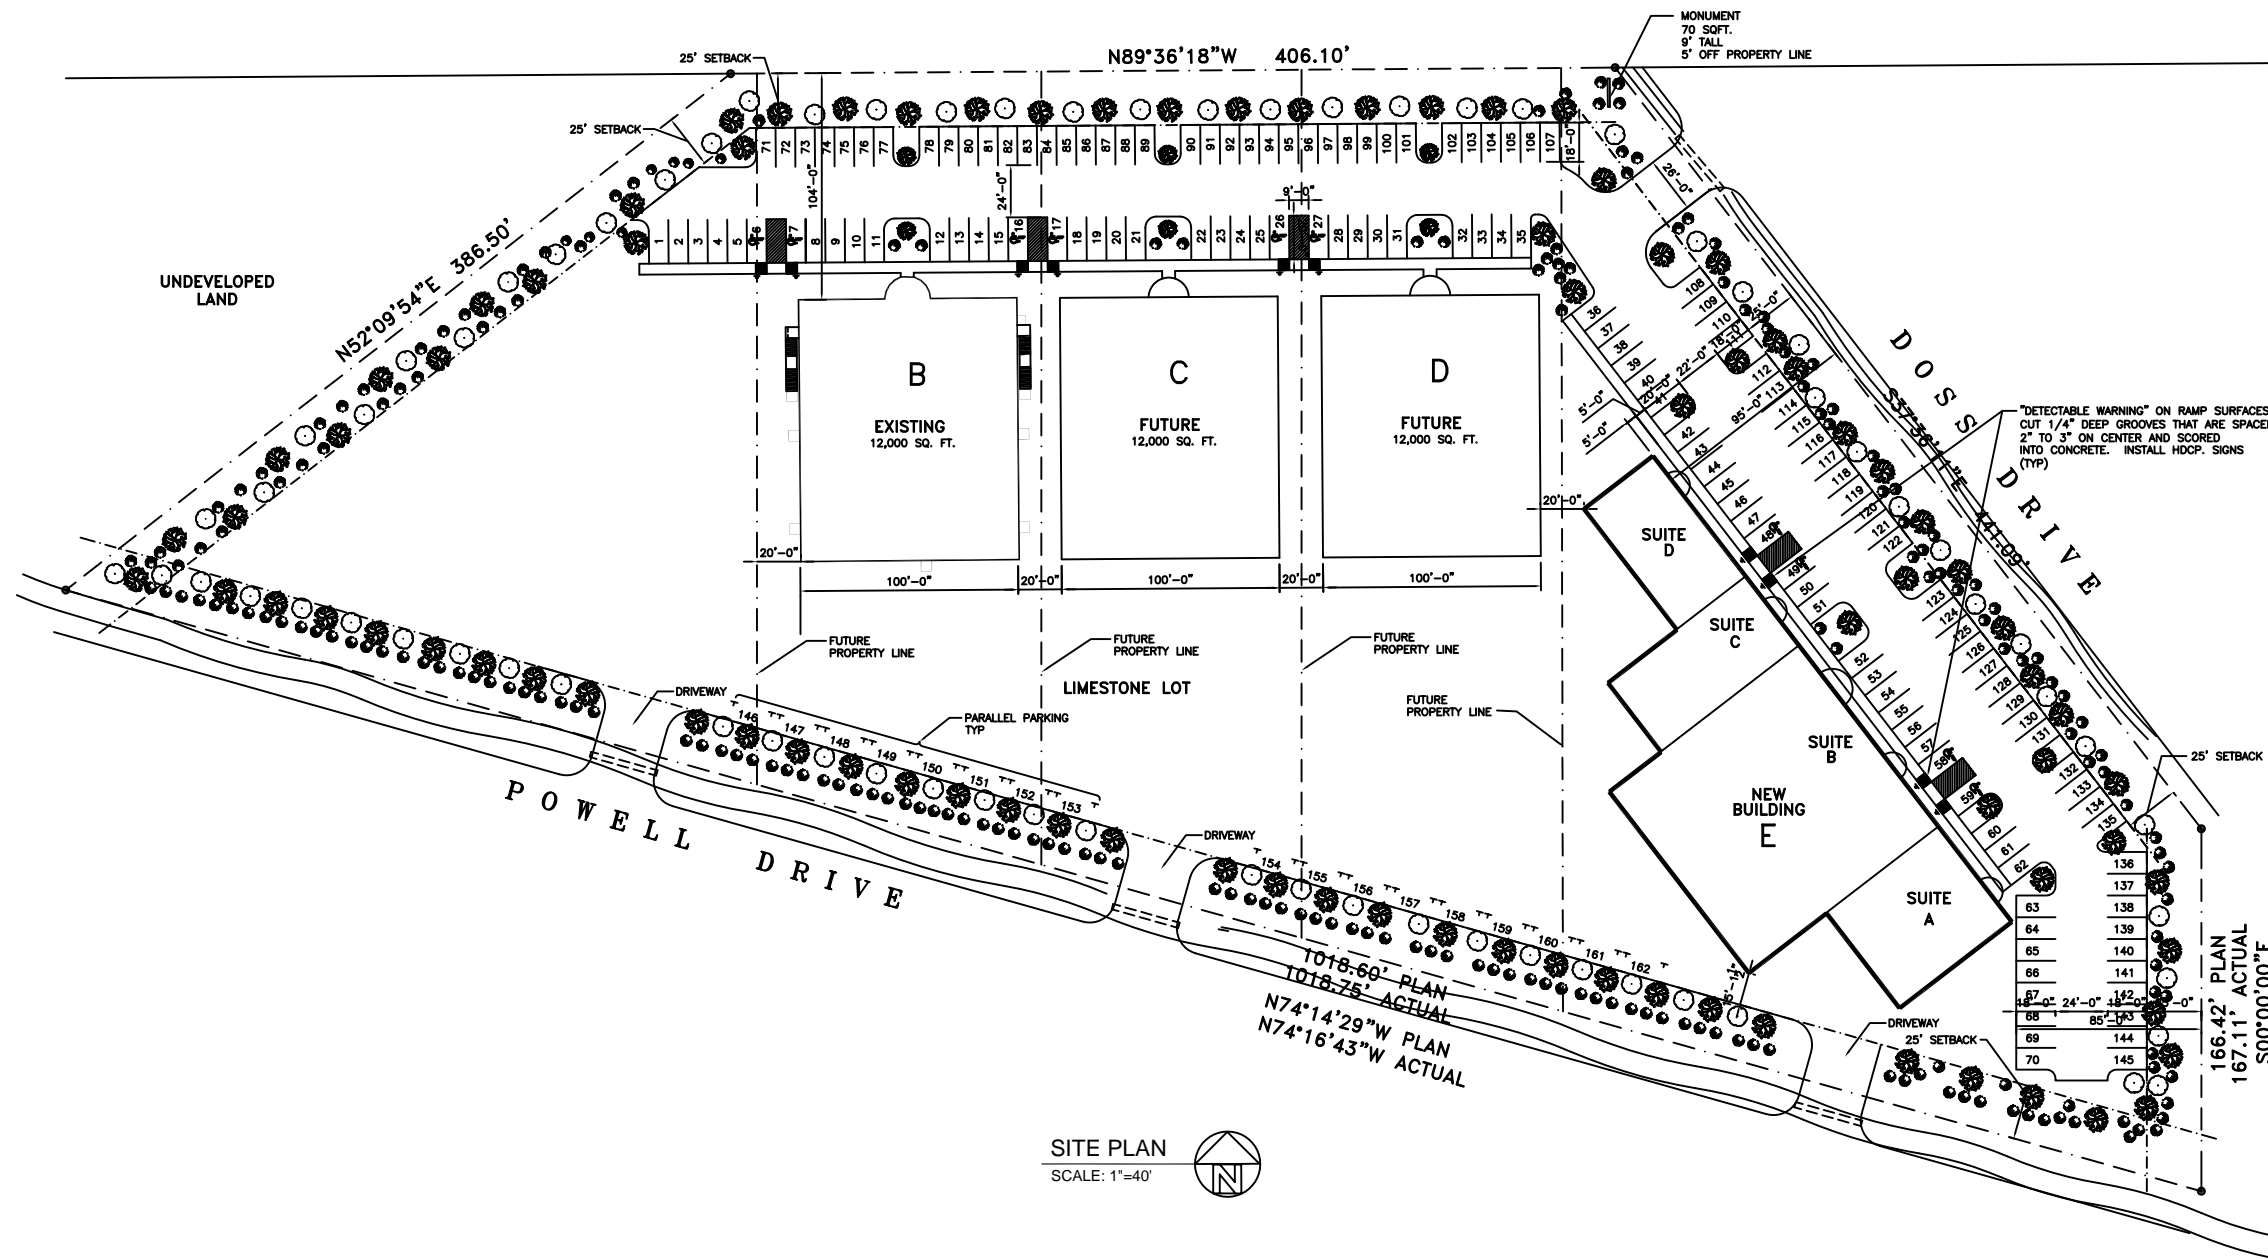

SITE PLAN
 SCALE: 1"=40'

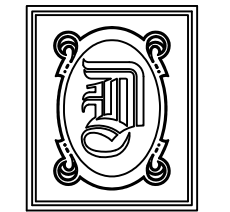

DAMMON ENGINEERING, INC.

CHIEF ENGINEER
 EMMETT DAMMON, P.E.

CHIEF ARCHITECT
 ROBERT WILTSE

1095 FLORIDA AVENUE
 SLIDELL, LA. 70458
 OFFICE: 985-649-5832
 FAX: 985-641-5950

WEBSITE:
 WWW.DAMMONENGINEERING.COM

EMAIL:
 DAMMONENG@BELLSOUTH.NET

- ARCHITECTURE
- ENGINEERING
- STUDIES
- PLANNING
- INVESTIGATION
- EXPERT WITNESS

SOUTHEAST LOUISIANA VETERANS HEALTH CARE SYSTEM

SITE PLAN

REV:

SCALE: AS NOTED

JOB#: 2011

DATE: 04-06-09

SHEET 2

C-2

OF 14