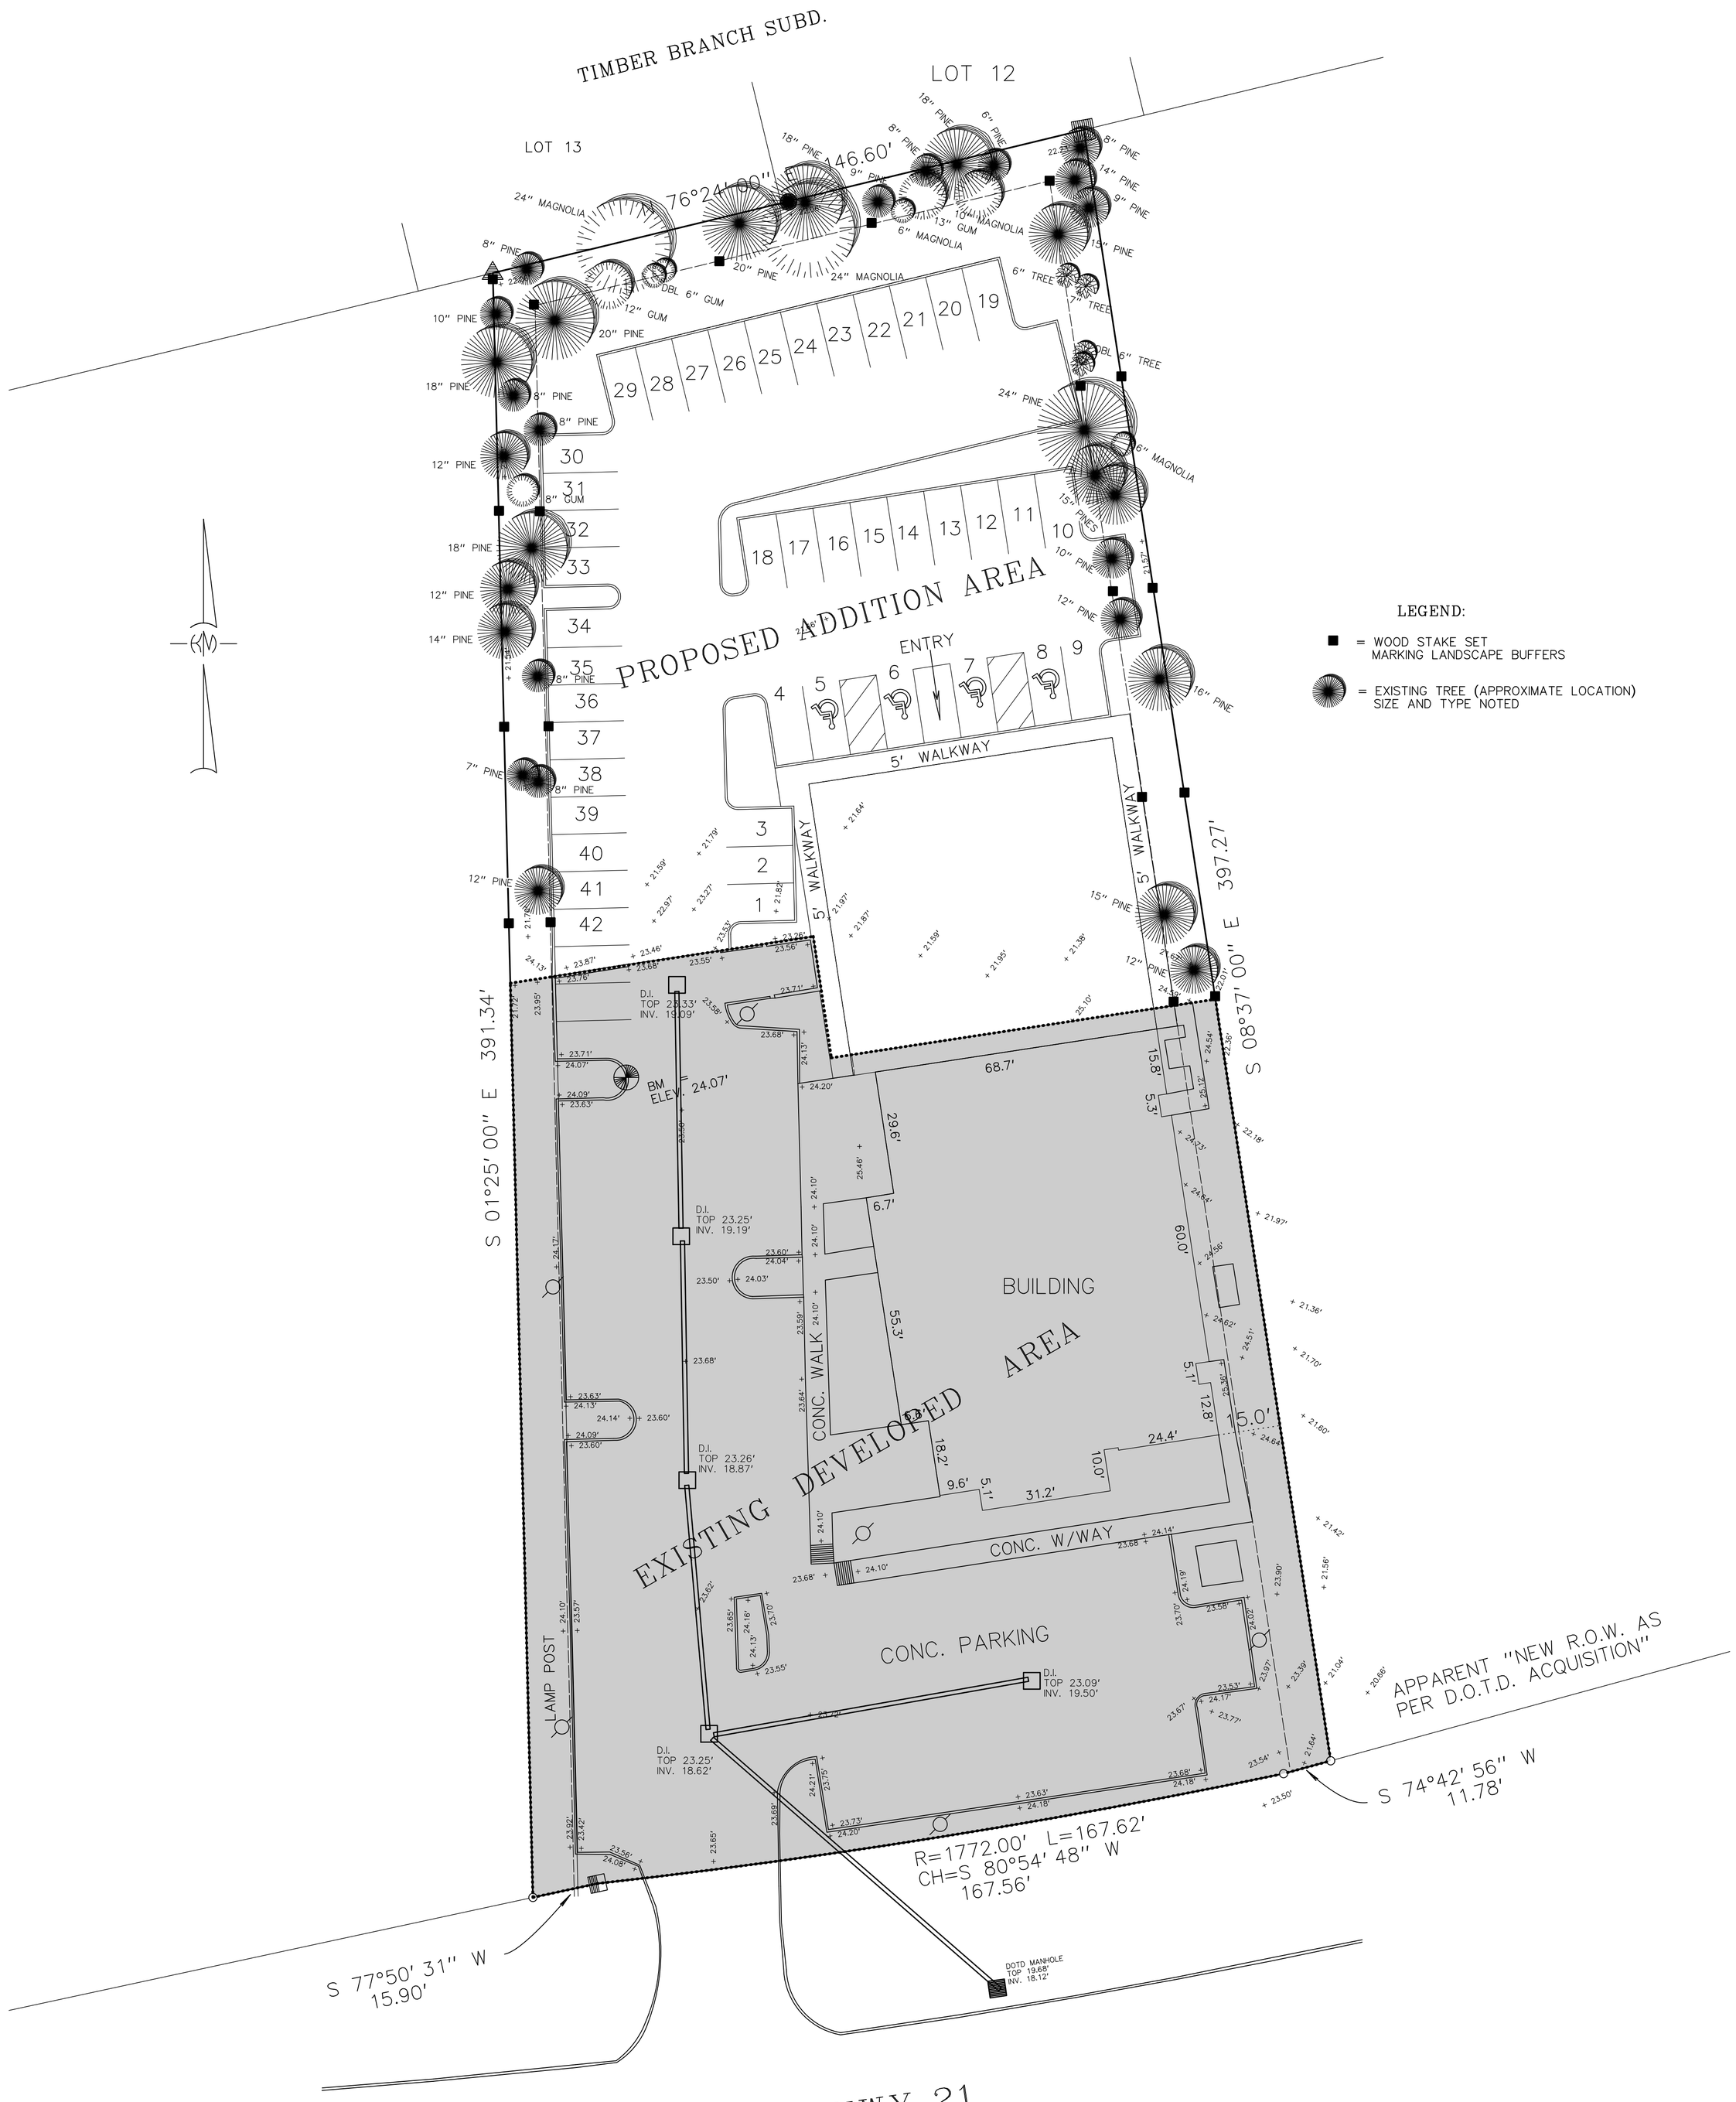

STATE OF LOUISIANA
KELLY McHUGH
License No. 18940
PROFESSIONAL ENGINEER
IN
CIVIL ENGINEERING
07-30-21

TREE SURVEY

PARCEL AB-1,
SECTION 46, T-7-S, R-11-E,
ST. TAMMANY PARISH, LOUISIANA.

REVISIONS	
MARK	DATE

KELLY J. McHUGH & ASSOC., INC.
CIVIL ENGINEERS & LAND SURVEYORS
845 GALVEZ ST. – MANDEVILLE, LA.
626-5611

SCALE:	1" = 20'	DATE:	07-30-21
DRAWN:	DRJ	JOB NO.:	02-208
CHECKED:	KJM	DWG. NO.:	02-208-TS