


RELOCATED FACILITIES  
 SCALE: 3/32" = 1'-0"

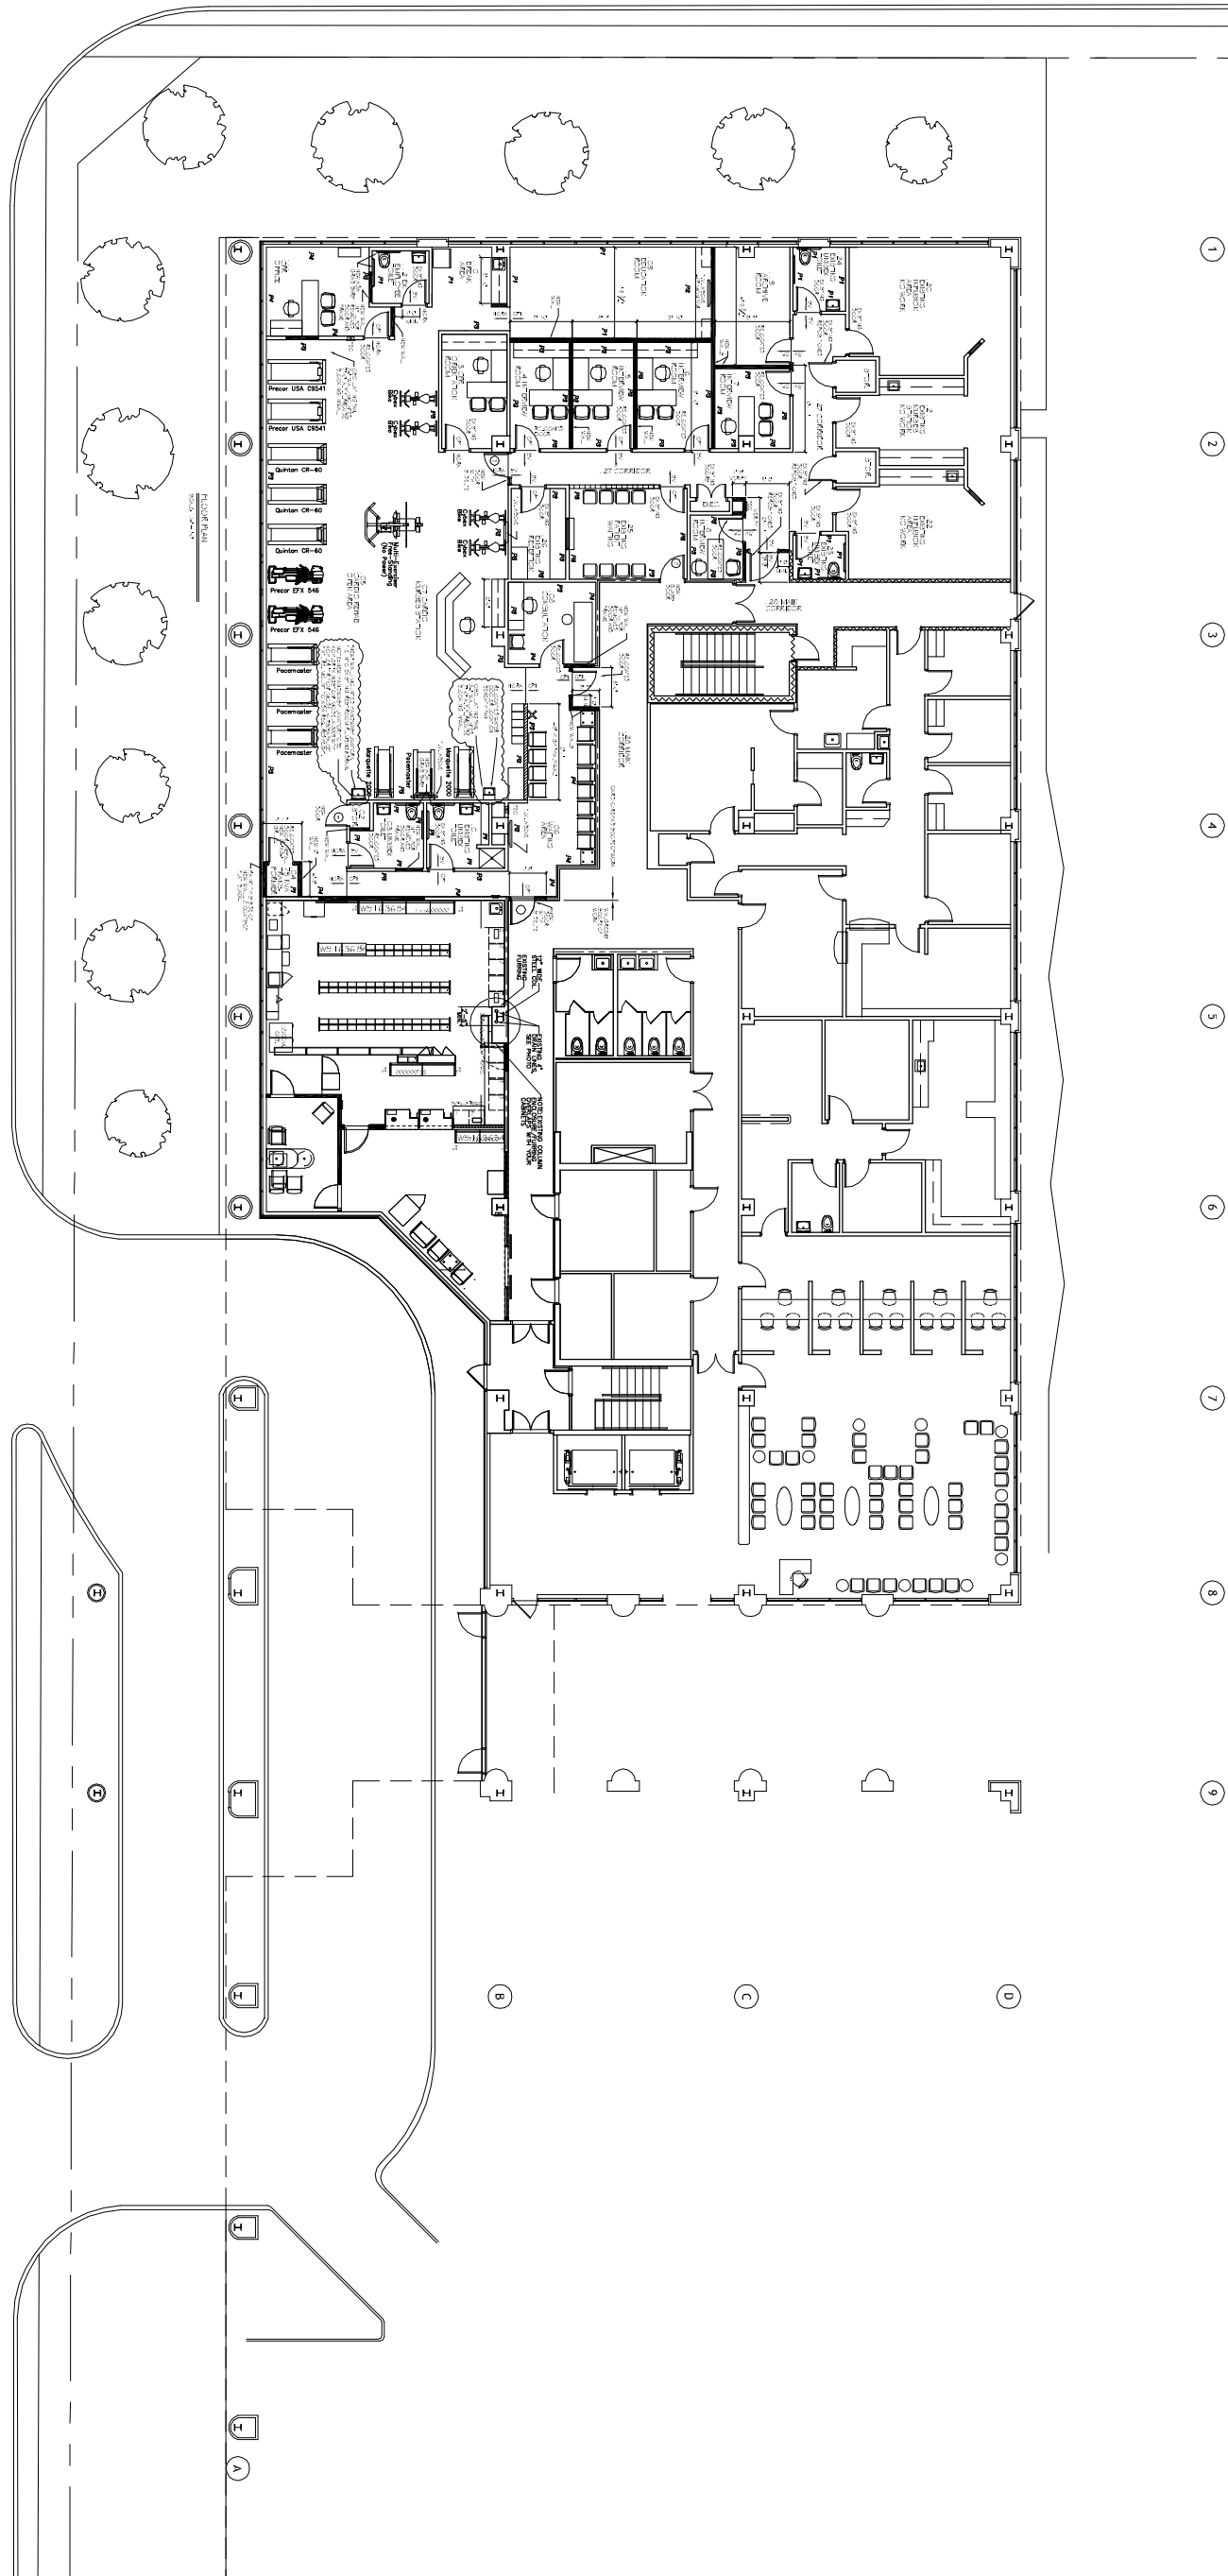

REVISIONS		
#	DESCRIPTION	DATE
1	ADDED NEW LAV & RELOCATED WATER COOLER	02-10-14

SLIDELL MEMORIAL HOSPITAL  
**CARDIO/REHAB RENOVATION**  
 1001 CAUSE BOULEVARD  
 SLIDELL, LA 70458

JOB No: 2185    DATE: 11-12-2013  
 DRAWN BY: JTL    CHECKED BY: CKD

**DAMMON**  
 ENGINEERING, INC.  
*Architects & Engineers*

CHIEF ENGINEER: BRIAN MISTICH, PE  
 CHIEF ARCHITECT: KEVIN KINCHEN, NCARB  
 554 OLD SPANISH TRAIL  
 SLIDELL, LA 70458

dammonengineering.com  
 dammoneng@bellsouth.net  
 PHONE: 985-649-5832  
 FAX: 985-641-5950