

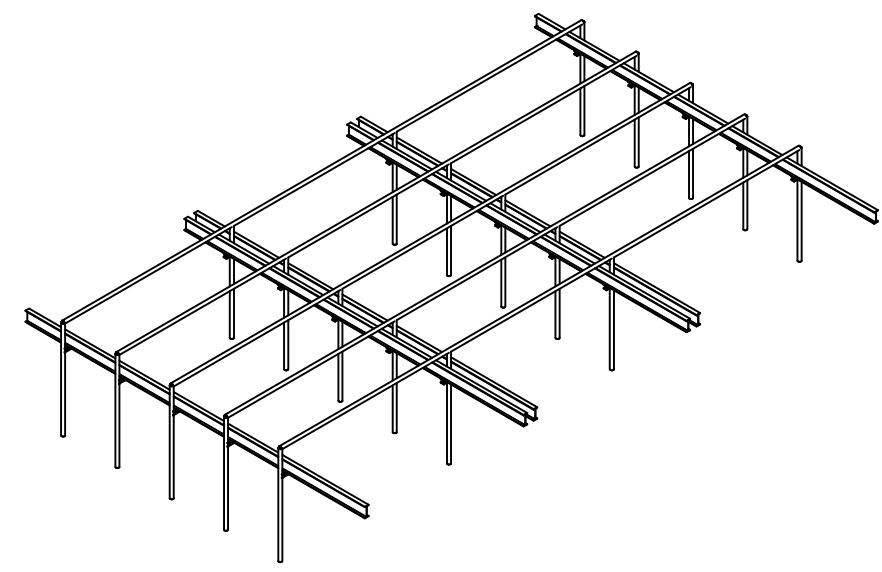


8 7 6 5 4 3 2 1


D  
C  
B  
A

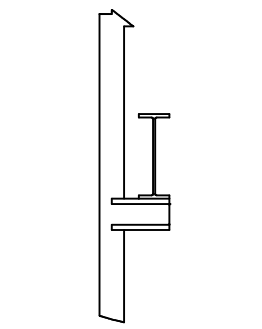

**ISO VIEW**  
SCALE= 1/300

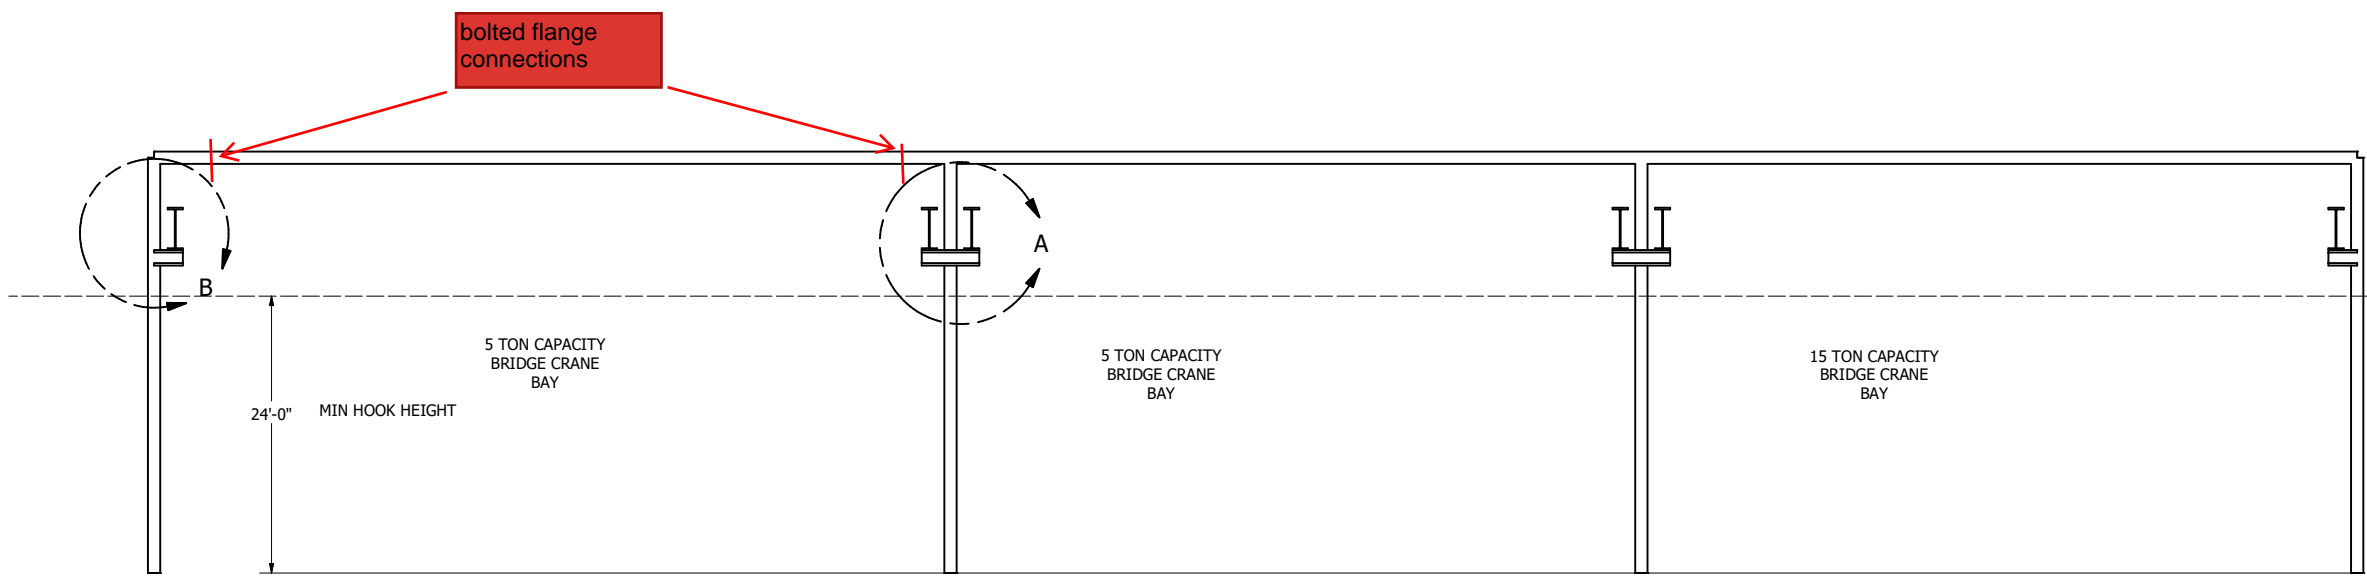

**DETAIL B**  
SCALE= 1 / 50  
Exterior Column Detail

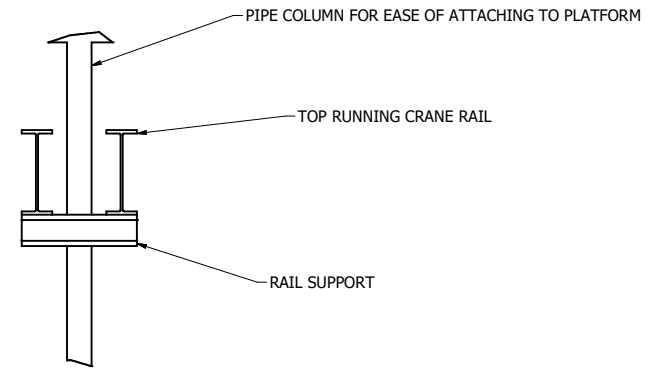

**DETAIL A**  
SCALE= 1 / 50  
Interior Column Detail

**PRELIMINARY**  
NOT FOR PRODUCTION

DO NOT SCALE DRAWING ALL DIMENSIONS ARE IN INCHES		THIRD ANGLE PROJECTION		This document is copyrighted and, whether containing patentable or nonpatentable subject matter, embodies proprietary and confidential information. The recipient and the recipient's company agree that it is loaned in confidence with the understanding that it nor the information in it will be reproduced, used, or disclosed in whole or in part for any purpose except the limited purpose for which it is loaned. This document shall be returned to Sparrows upon demand.			DRAWING TITLE	
UNLESS NOTED OTHERWISE REMOVE ALL BURRS AND SHARP CORNERS APPROX. 0.03 x 45° CHAMFER OR 0.03 RADIUS		UNLESS NOTED OTHERWISE FRACTIONS = ± 1/16 X.X = ± 0.06 X.XX = ± 0.03 X.XXX = ± 0.006 ANGLES = ± 1/2°					SQ53740 SHELL JUNCTION BRIDGE CRANE LAYOUT	
BY	DATE	SIZE	DRAWING NUMBER		REV.			
DRAWN	J BOURG	99/99/9999	D	SQ53740-B99-100	C1			
CHECKED	M LEGE	8/31/23	SCALE:	WEIGHT: N/A	SHEET 1 OF 1			
APPROVED	M BARCELONA	8/31/23						

C1	8/31/23	NEW DWG	DR-A8984	JMB	ML	RMB
REV	DATE	DESCRIPTION	DCN. NO.	DRN	CKD	APPD

8 7 6 5 4 3 2 1