

DAMMON
ENGINEERING, INC.

CHIEF ENGINEER
EMMETT
DAMMON, P.E.

CHIEF ARCHITECT
ROBERT
WILTSE

554 OLD SPANISH TRAIL
SLIDELL, LA. 70458
OFFICE: 985-649-5832
FAX: 985-641-5950

WEBSITE:
WWW.DAMMONENGINEERING.COM

EMAIL:
DAMMONENG@BELLSOUTH.NET

ARCHITECTURE
ENGINEERING
STUDIES
PLANNING
INVESTIGATION
EXPERT WITNESS

NEW
ADDITION

FEAST CATERING
109 TAOS ST.
SLIDELL, LA

SECTIONS

Robert Wiltse

REV:

SCALE: AS NOTED


JOB#: 2140

DATE: 04-20-12



SHEET

A-2

OF

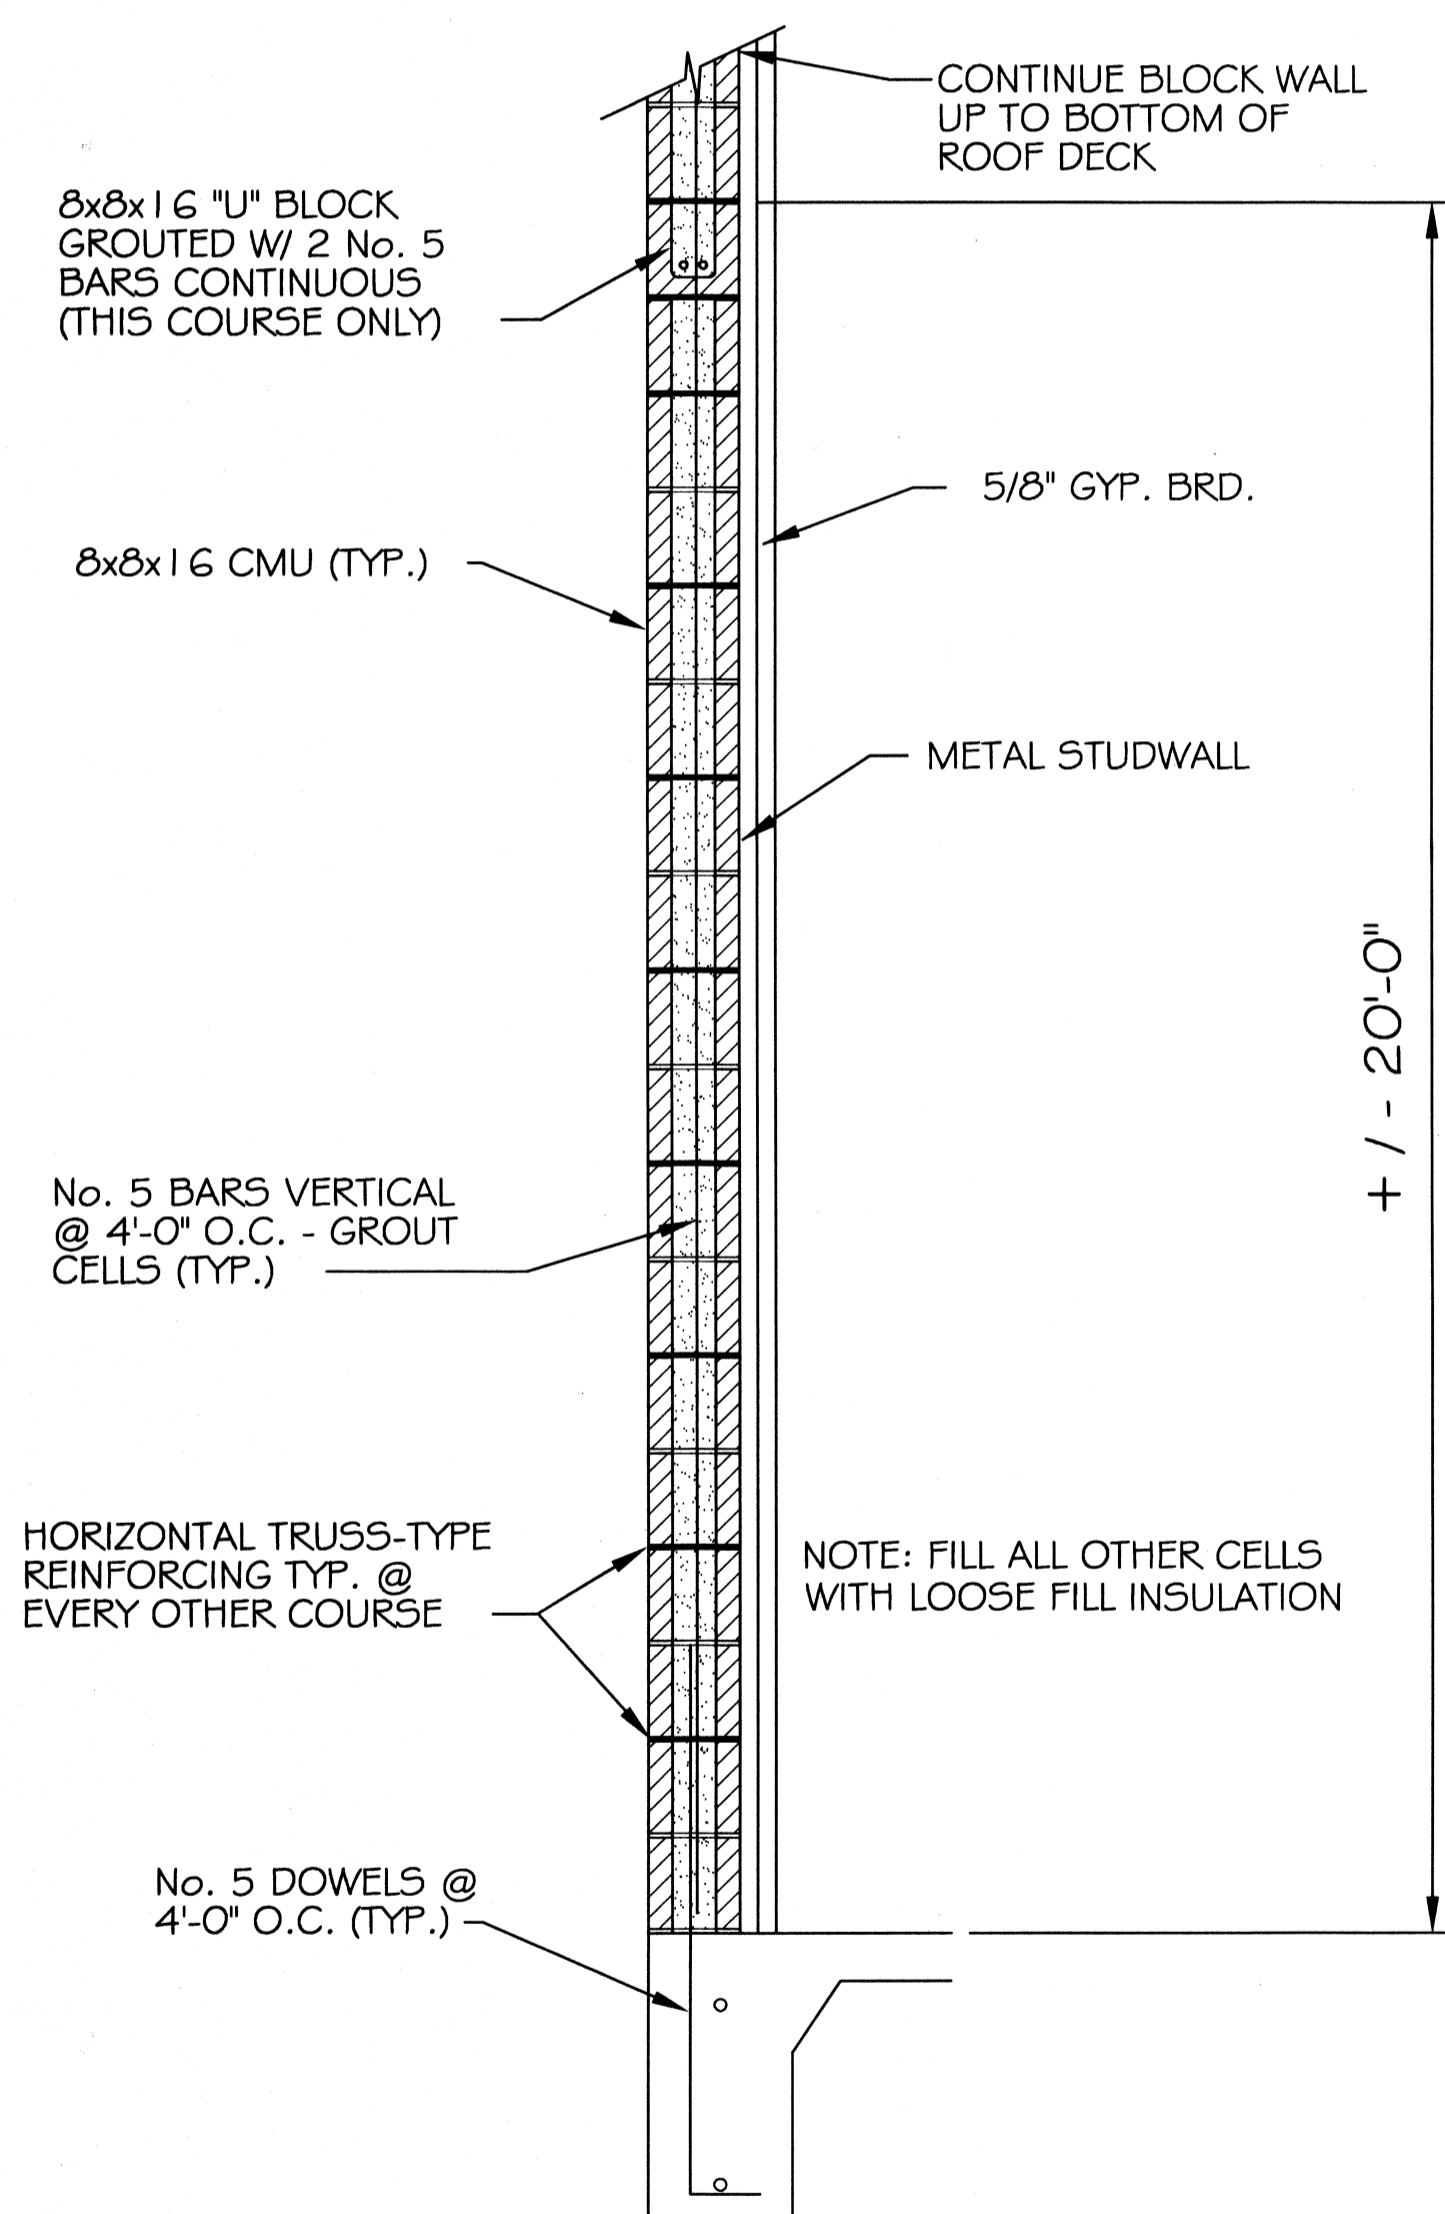


3 HR. WALL UL#U914
N.T.S.

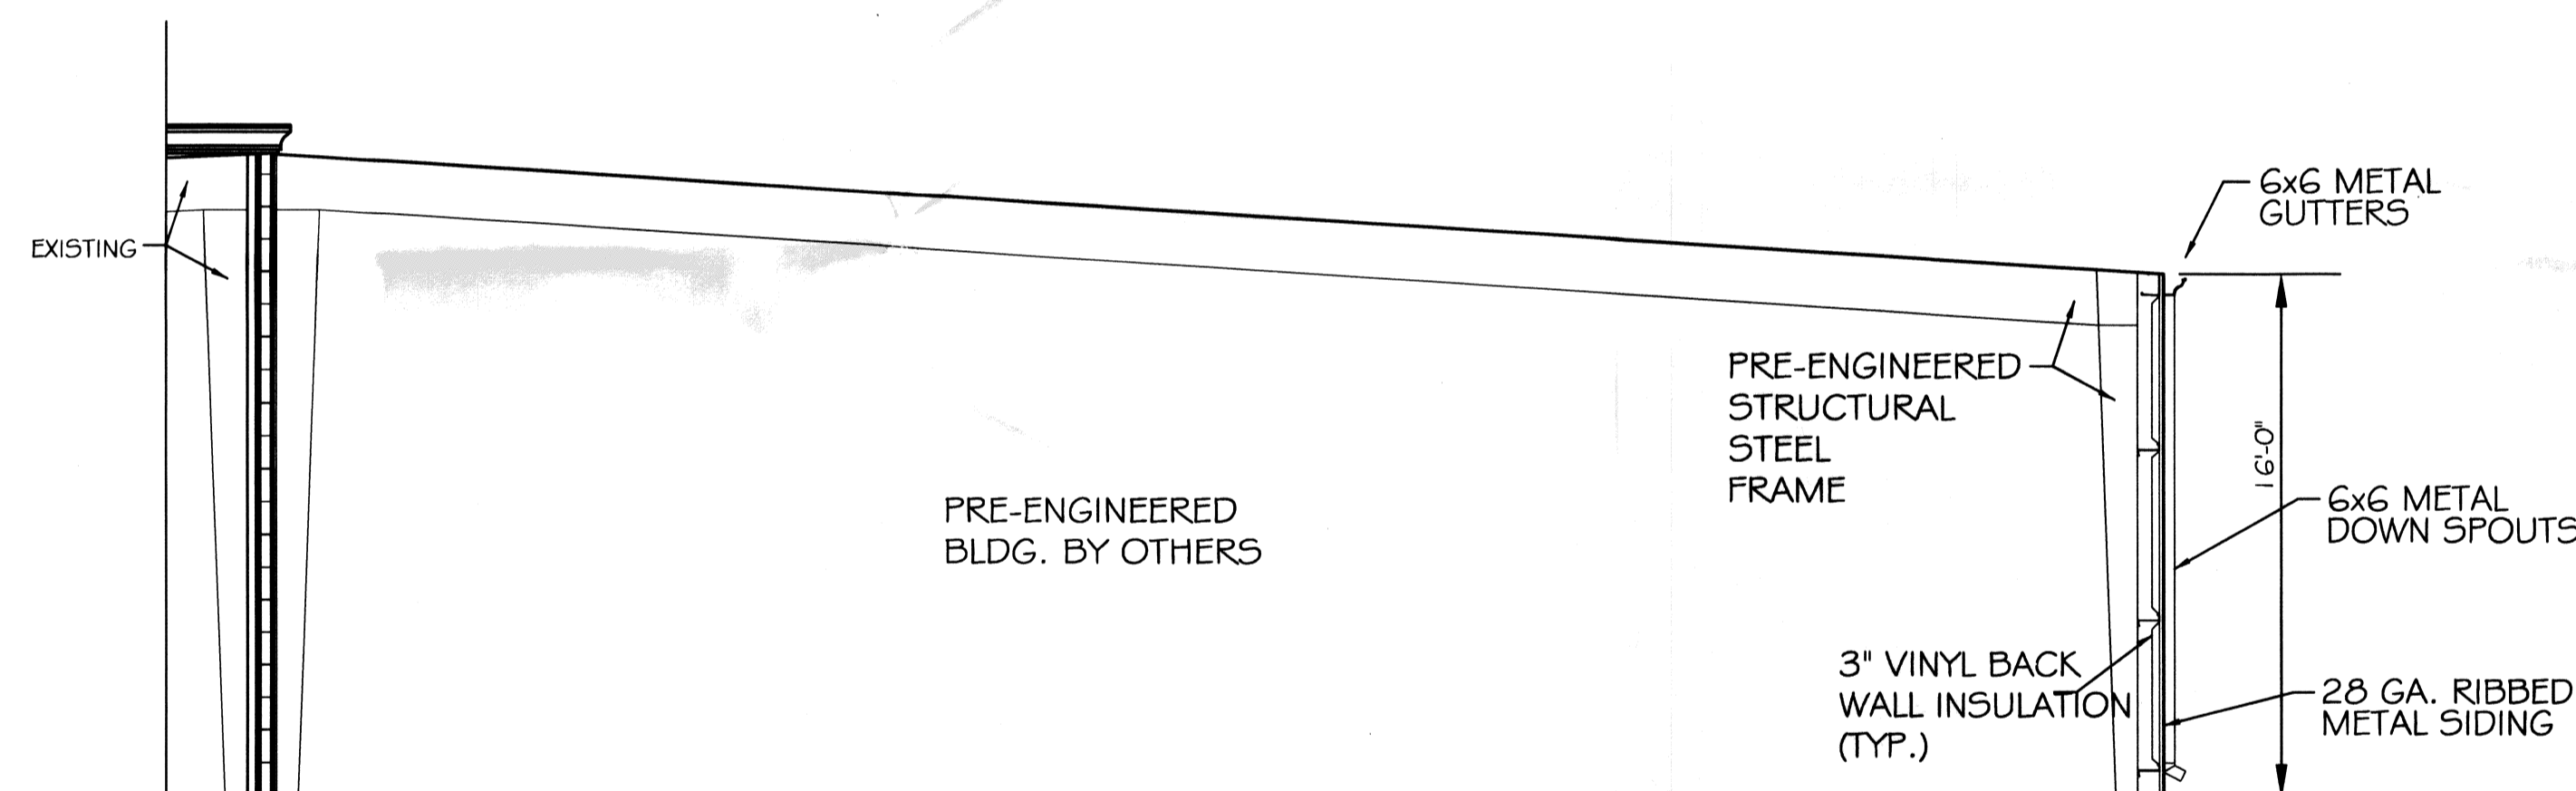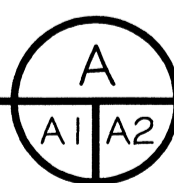

SECTION

SCALE: 3/16" = 1'-0"

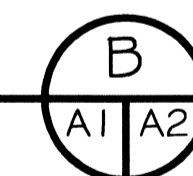

414757
REVIEWED FOR
STATE FIRE MARSHAL
AS PER REVIEW LETTER
BY: WILLIAM D. JONES, ARCHITECT, CBO
William D. Jones