

DAMMON ENGINEERING, INC.

CHIEF ENGINEER
EMMETT
DAMMON, P.E.

CHIEF ARCHITECT
ROBERT
WILTSE

554 OLD SPANISH TRAIL
SLIDELL, LA. 70458
OFFICE: 985-649-5832
FAX: 985-641-5950

WEBSITE:
WWW.DAMMONENGINEERING.COM

EMAIL:
DAMMONENG@BELLSOUTH.NET

- ARCHITECTURE
- ENGINEERING
- STUDIES
- PLANNING
- INVESTIGATION
- EXPERT WITNESS

NEW ADDITION

FEAST CATERING
109 TAOS
SLIDELL
LA

SITE PLAN

Robert Wiltse

REV:

SCALE: AS NOTED

JOB#: 2140


DATE: 04-20-12

SHEET

C-1

OF

- LEGEND**
- PROPERTY LINE
 - - - SETBACK LINE
 - NEW BUILDING
 - PARKING

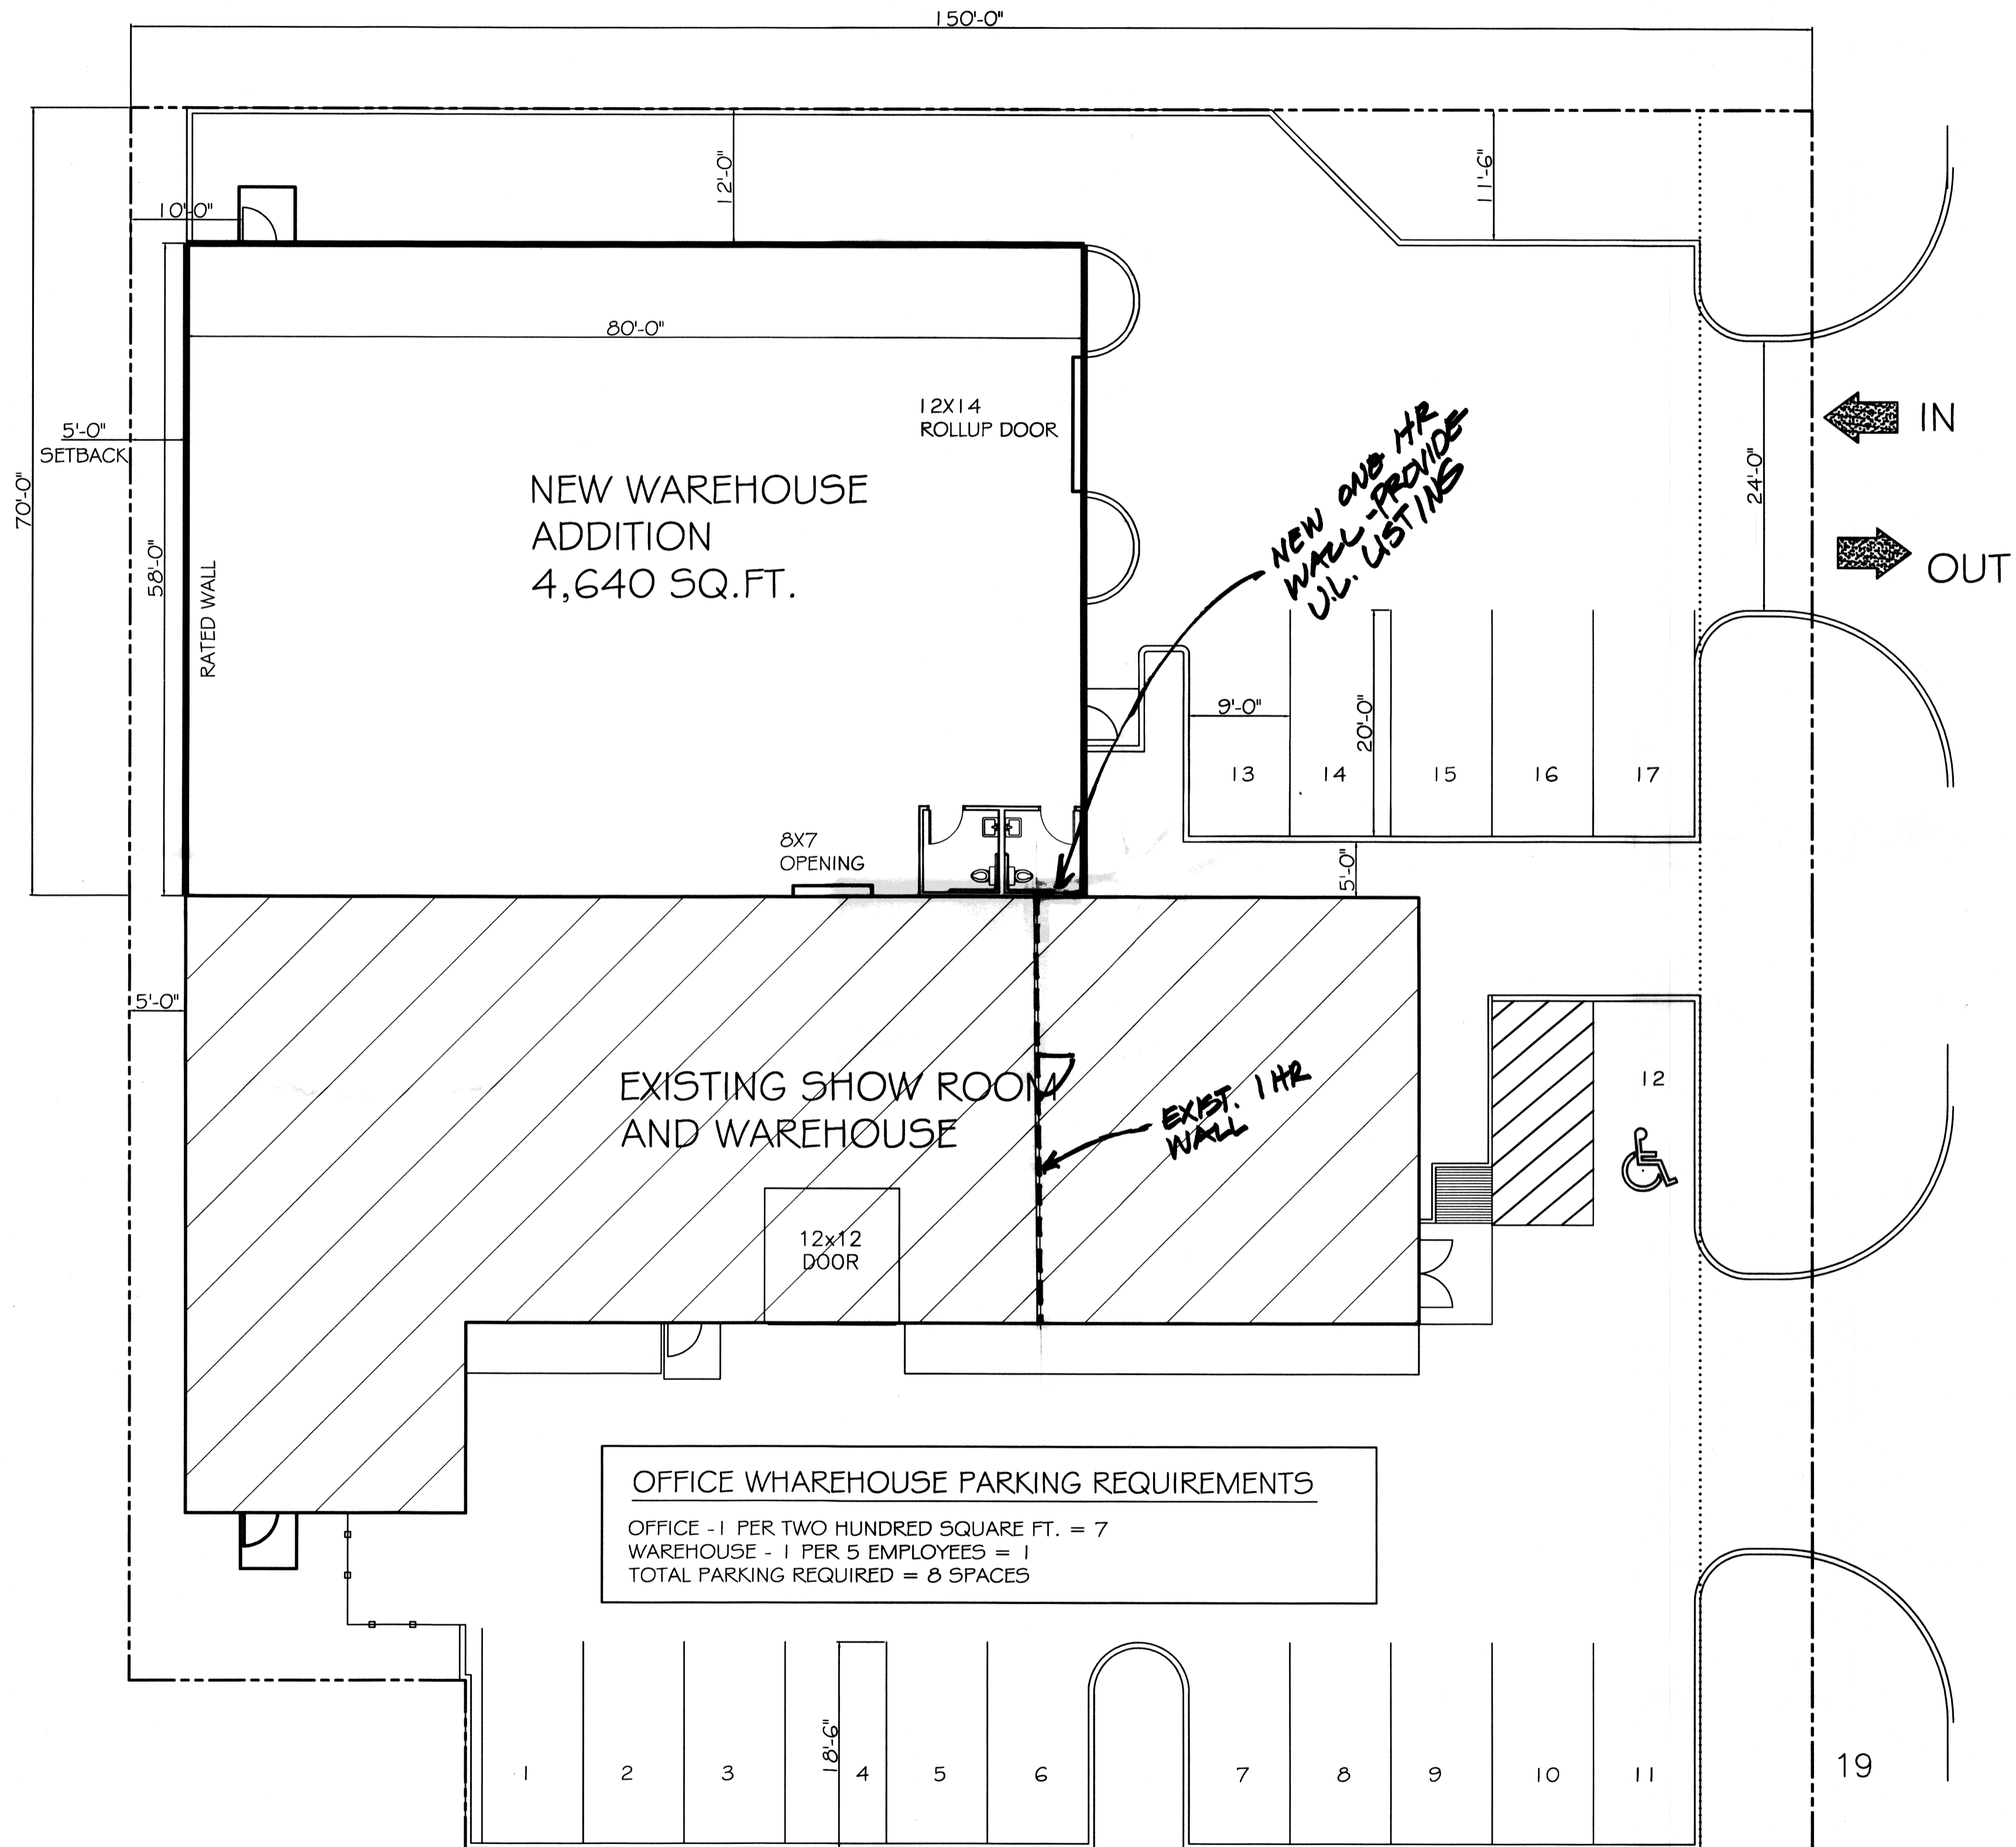

OFFICE WAREHOUSE PARKING REQUIREMENTS
 OFFICE - 1 PER TWO HUNDRED SQUARE FT. = 7
 WAREHOUSE - 1 PER 5 EMPLOYEES = 1
 TOTAL PARKING REQUIRED = 8 SPACES

SITE PLAN
 SCALE: 1" = 10'

TAOS STREET