J.V. Burkes & Associates, Inc.
1805 Shortcut Highway
Slidell, LA 70458
Tel: (985) 649-0075 Fax: (985) 649-0154
www.jvburkes.com

Invoice Date	Invoice Num
Aug 25, 2016	INV14987
Billing From	**Billing To**
Jul 01, 2016	Aug 25, 2016

Chuck Dammon
Dammon Engineering
554 Old Spanish Trail
Slidell LA 70458

INVOICE

dammoneng@gmail.com

JOB ID: 20160543:SU
JOB Name: Survey and Topo
Job Location: Dalecrest Lot 1, Square 35A

Dalecrest Lot 1, Square 35A
1352 7th Street

Amount: $1,500.00

Amount Due This Invoice: **$1,500.00**

This invoice is due on 8/30/2016

BillQuick Standard Report Copyright © 2016 BQE Software, Inc.

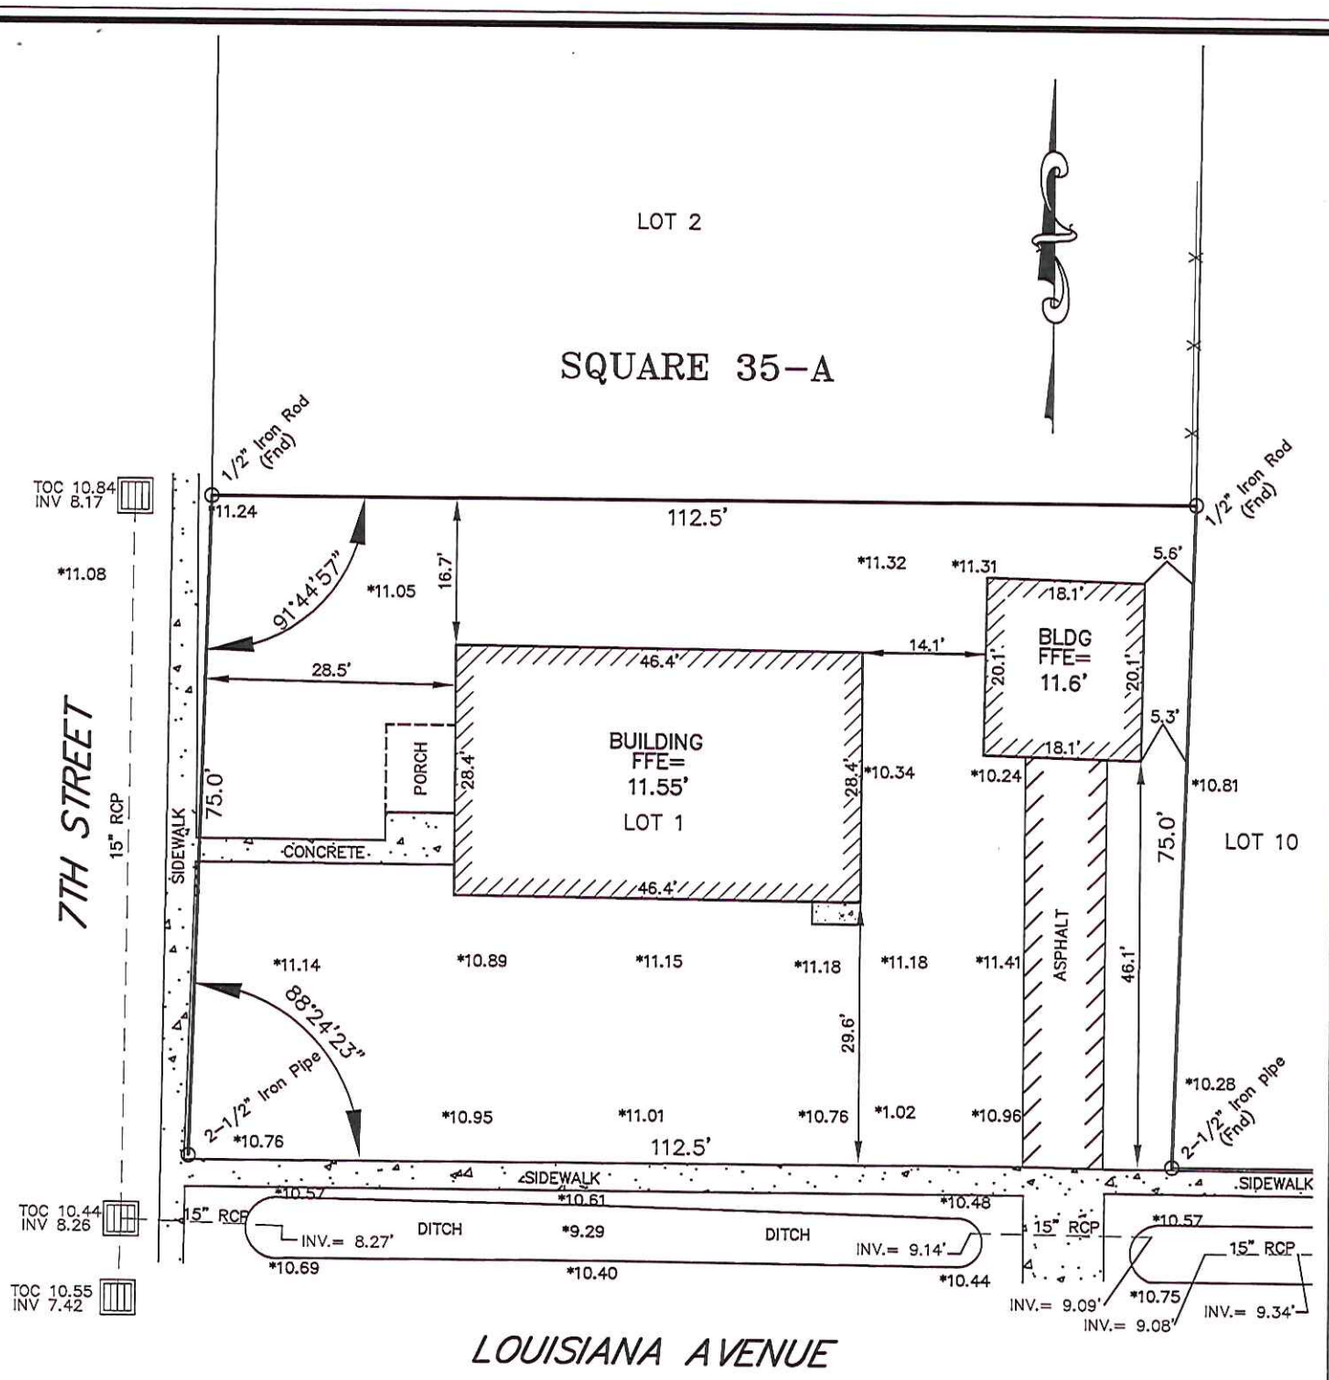

LEGEND

- ○ 1/2" Iron Rod Set
- ● 1/2" Iron Rod Found
- ⊕ Cross

ADDRESS: 1352 7TH STREET

GRAPHIC SCALE

30 0 15 30

(IN FEET)

1 INCH = 30 FEET

BUILDING SETBACKS
(* Verify Prior to Construction)

Front Setback.....*
Side Setback.....*
Rear Setback.....*

I CERTIFY THAT THIS PLAT DOES REPRESENT AN ACTUAL GROUND SURVEY AND THAT TO THE BEST OF MY KNOWLEDGE NO ENCROACHMENTS EXIST EITHER WAY ACROSS ANY OF THE PROPERTY LINES, EXCEPT AS SHOWN.

PROPERTY IS SURVEYED IN ACCORDANCE WITH THE LOUISIANA "MINIMUM STANDARDS FOR PROPERTY BOUNDARY SURVEYS" FOR A CLASS C SURVEY. BEARINGS ARE BASED ON RECORD BEARINGS UNLESS NOTED OTHERWISE.

ENCUMBRANCES SHOWN HEREON ARE NOT NECESSARILY EXCLUSIVE. ENCUMBRANCES OF RECORD AS SHOWN ON TITLE OPINION OR TITLE POLICY WILL BE ADDED HERETO UPON REQUEST, AS SURVEYOR HAS NOT PERFORMED ANY TITLE SEARCH OR ABSTRACT.

F.I.R.M. No. 220204 0010 C
F.I.R.M. Date 04/21/1999
ZN: AE B.F.E. 12'
* Verify prior to construction with Local Governing Body.

DRAWING NO. 20160543

DATE: 08/23/16

J.V. Burkes & Associates, Inc.

SURVEYING • ENGINEERING • ENVIRONMENTAL

1805 SHORTCUT HIGHWAY
Slidell, Louisiana 70461
E-mail: jvbassoc@jvburkes.com
Phone: 985-649-0075 Fax: 985-649-0154

DRAWN BY: WLS

CHECKED BY: JCR

SCALE: 1" = 30'

DECLARATION IS MADE TO ORIGINAL PURCHASER OF THE SURVEY. IT IS NOT TRANSFERABLE TO ADDITIONAL INSTITUTIONS OR SUBSEQUENT OWNERS. SURVEY IS VALID ONLY IF PRINT HAS ORIGINAL SEAL OF SURVEYOR.

A SURVEY MAP OF LOT 1, SQ. 35-A, DALECREST SUBDIVISION, IN THE CITY OF SLIDELL, SECTION 10, T-9-S, R-14-E, GLD ST. TAMMANY PARISH LOUISIANA

CERTIFIED TO: DAMMON ENGINEERING

STATE OF LOUISIANA
SURVEYED BY:
SEAN M. BURKES
REG. NO. 4785
PROFESSIONAL LAND SURVEYOR

SEAN M. BURKES
LA REG. No. 4785

M:\SURVEYING\2016\LOT SURVEY\DALECREST\LOT 1,SQ.35A,20160543,DAMMON ENG.