PERMIT SET

The Lawrence Residence

Military Road
Slidell, LA

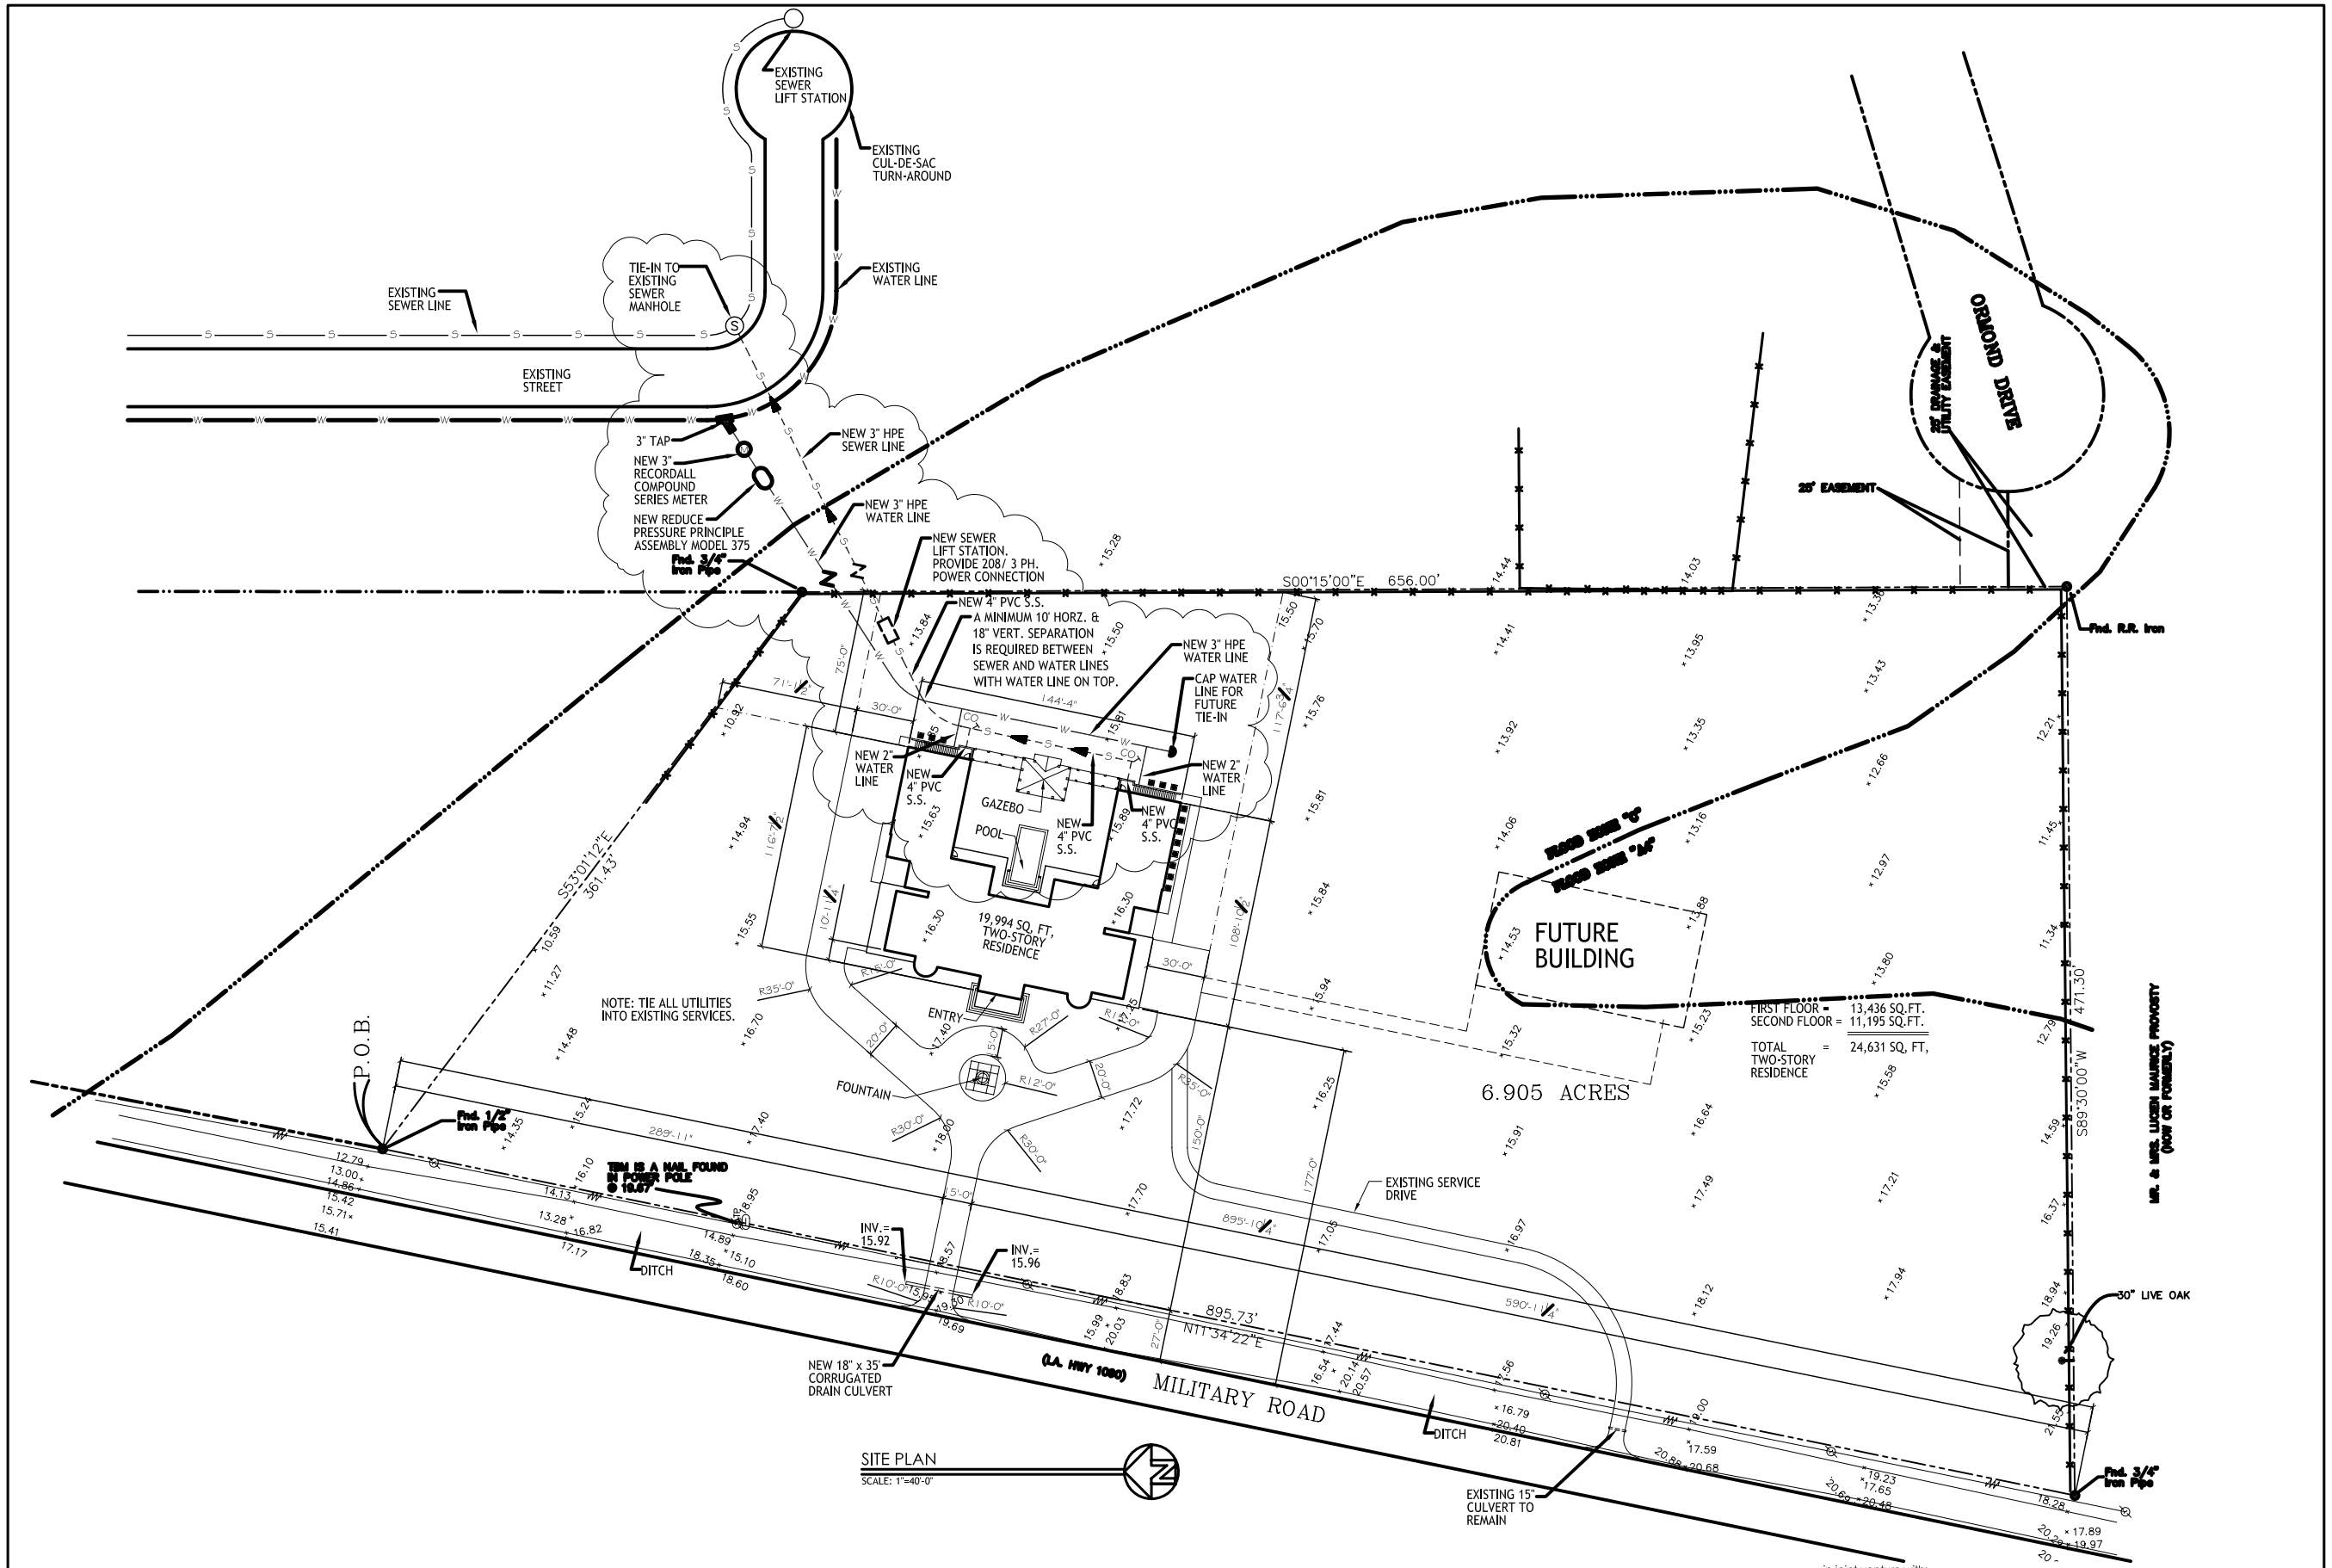

SITE PLAN
SCALE: 1"=40'-0"

in joint venture with:

DAMMON ENGINEERING, INC.
Architects & Engineers

Chief Architect: Kevin J. Kinchen, NCARB
Chief Engineer: Brian Mistich, PE
554 Old Spanish Trail
Slidell, LA 70458

www.dammoneng ineering.com
dammoneng@bellsouth.net
PH: 985.649.5832
F: 985.641.5950

Sheet #: 2 of 17

Project #: 2208	Revision: 06-25-2014
Date: 06-16-2014	Revision: 07-01-2014
Scale: 3/32" = 1'-0"	C1
Drawn By: JTL	
Checked By: CKD	
Revision: 10-23-2014	
Revision:	

MELANCON ORTEGA DESIGNS
architecture+interiors
NEW ORLEANS, LA
504.483.7727 -T 504.483.7728 - F

PLOTTED - Feb 19, 2015 - 3:34pm