


1 ENLARGED PLAN
1A1.1 CATO 1/4" = 1'-0"



2 ENLARGED PLAN
1A1.1 SHOE DEPT 1/4" = 1'-0"

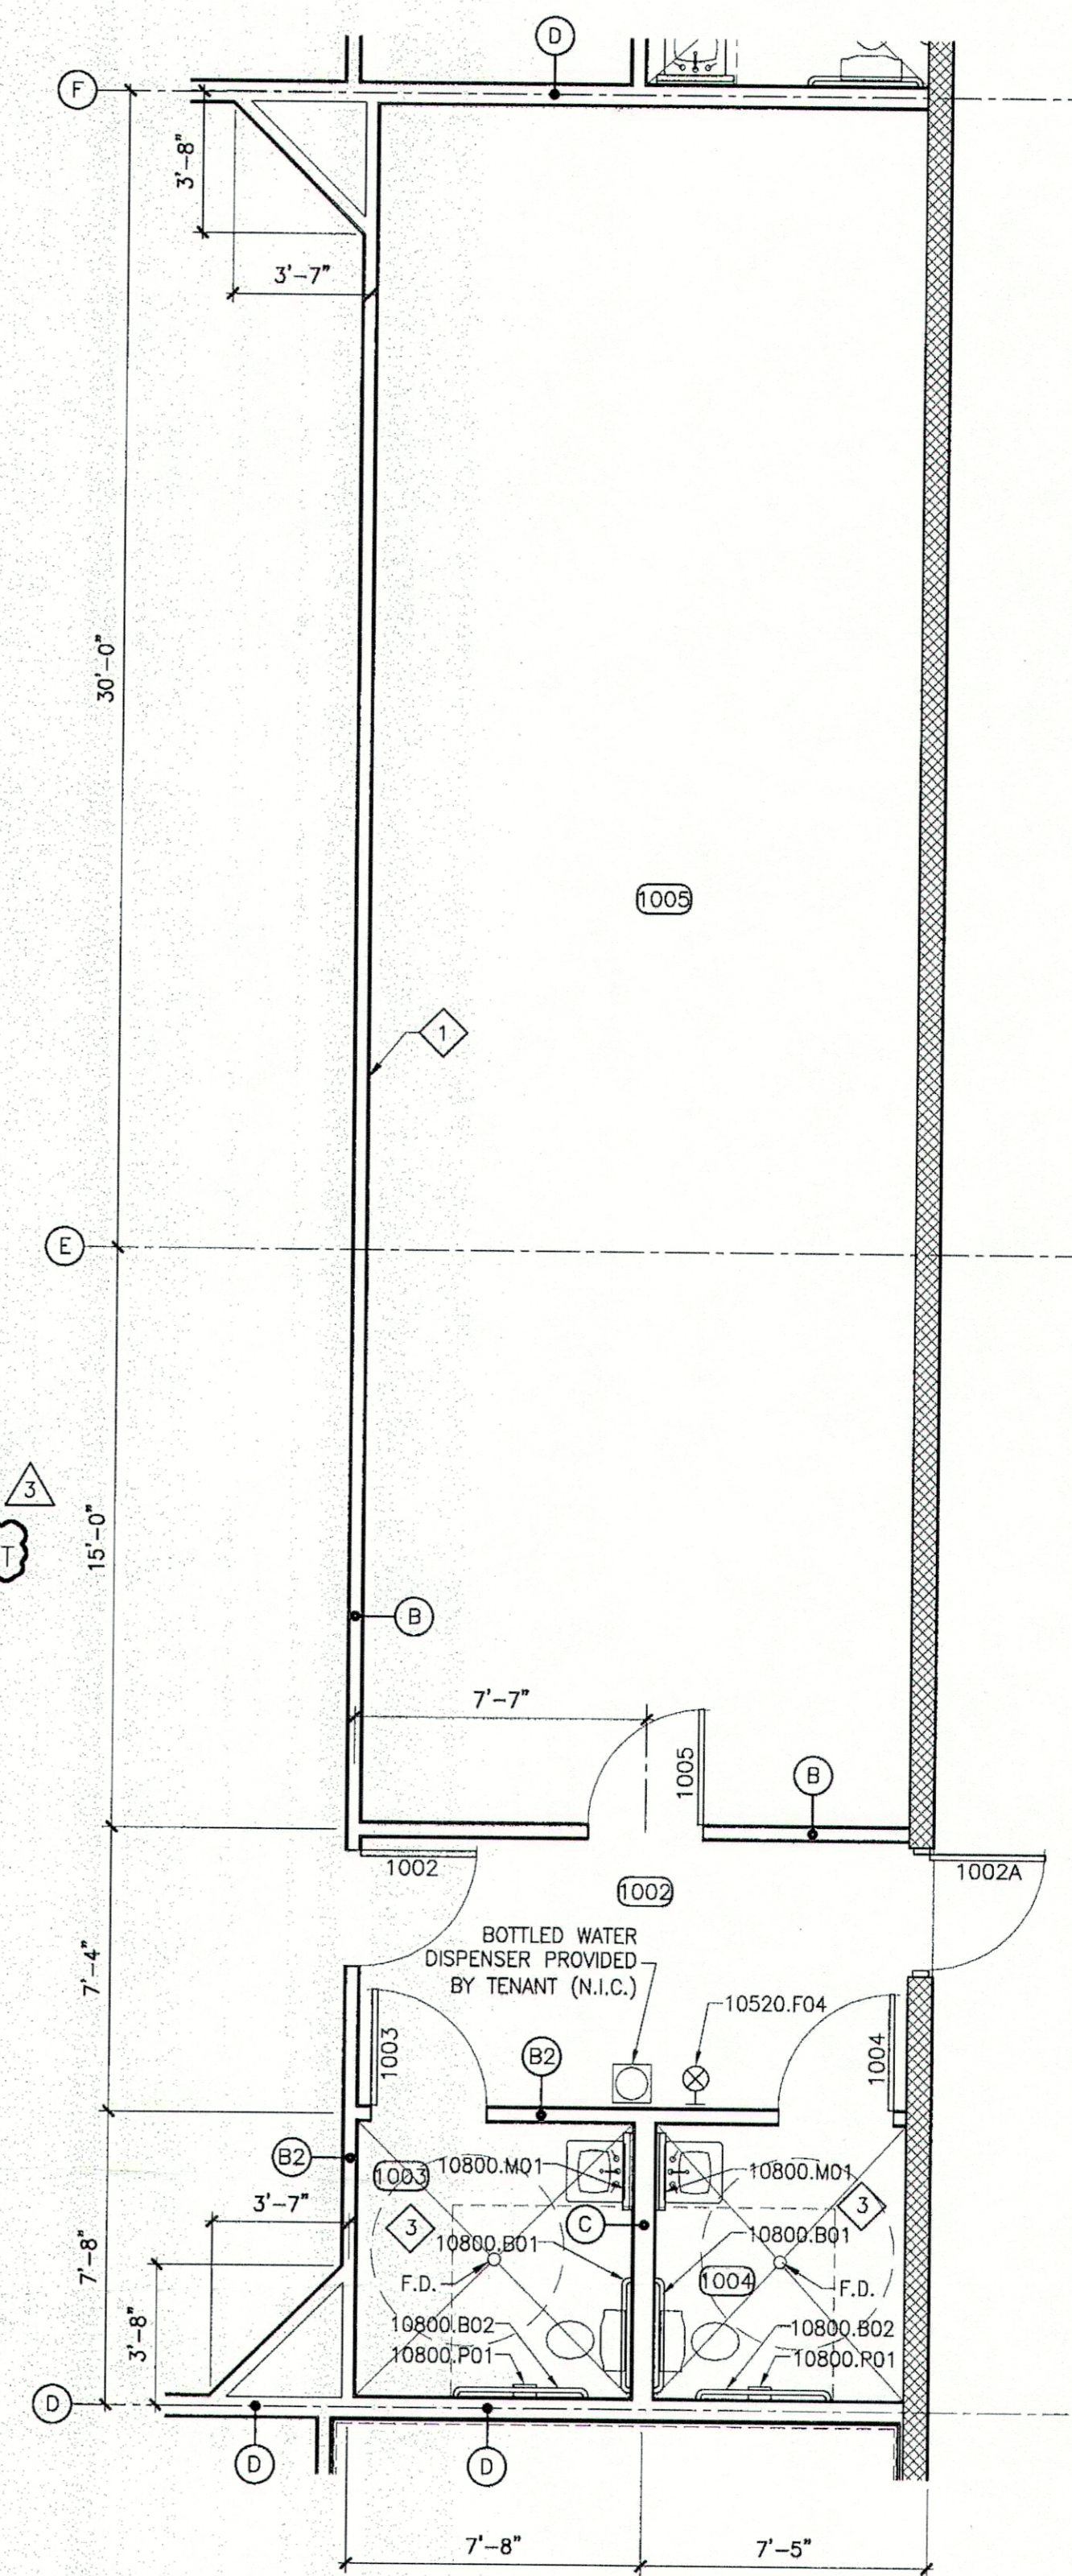