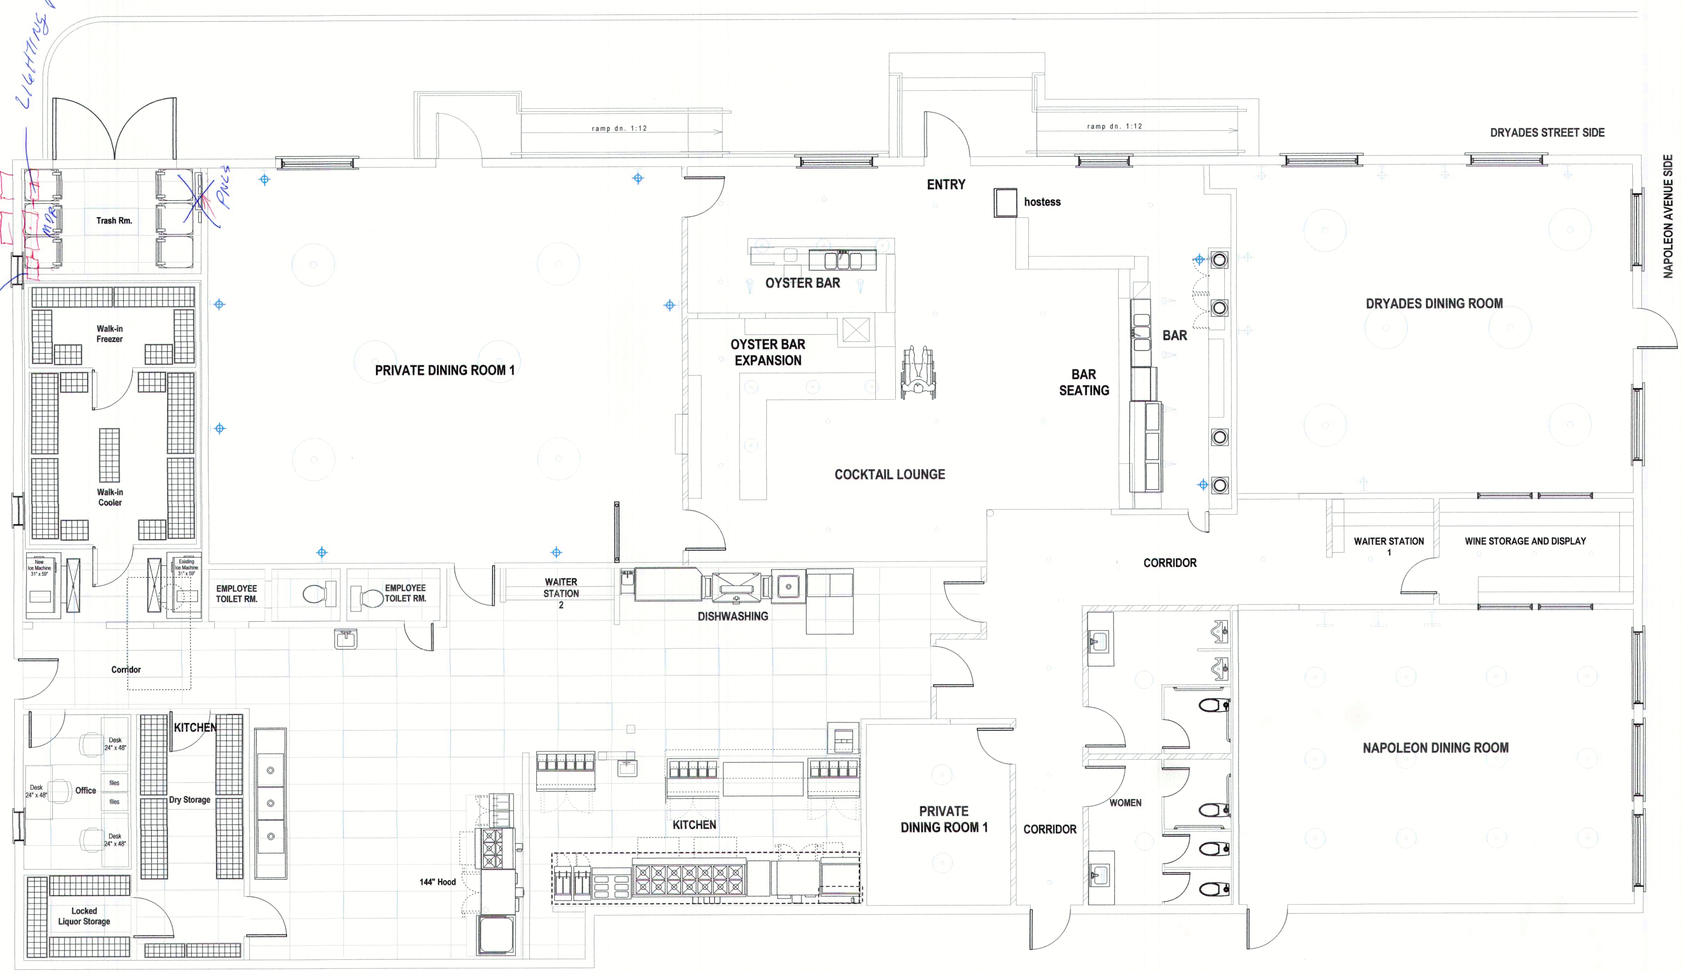

3 LIGHTING PLAN
SCALE: 3/16"=1'-0"

DAMMON ENGINEERING, INC.
LOUISIANA & MISSISSIPPI

www.dammonengineering.com
info@dammonengineering.com
PH: 985.649.5832

Chief Engineer: Brian Mistich, PE
5454 Russell Trail
Slidell, LA 70458

#	DESCRIPTION	DATE

REVISIONS

SEAL:

5/17/2024

Missing or invalid
File: P:\Stamps\E
Sheet: 1

RESTAURANT
PASCAL'S MANALE
1838 NAPOLEON AVENUE, NEW ORLEANS, LA 70115

JOB No:	2024	DATE:	06/25/2025
DRAWN BY:	CKD	CHECKED BY:	BAM

The plans, specifications, and reports prepared by Dammon Engineering, Inc. and all other documents that bear the name of Dammon Engineering, Inc. are instruments of service in respect of the client and are the property of Dammon Engineering, Inc. Reproduction or publication by any method, in whole or in part, without the written consent of Dammon Engineering, Inc. is prohibited. Title to these plans and specifications remains with Dammon Engineering, Inc. Visual contact with these plans and specifications shall constitute prima facie evidence of acceptance of these restrictions.

SHEET TITLE:
LIGHTING PLAN

DRAWING NUMBER:
E101

SHEET No: 2 of 7