


- Electrical: - Existing 3 phase coming in @ panel
 - lighting - Show Fixture location Fixture by owner
 - outlets - as Required by Code
 - Fire Alarm ?
- Plumbing/Aircondition system:
 - 6 - 5 ton condensers
 - exhaust as Required
 - new HWT

Front

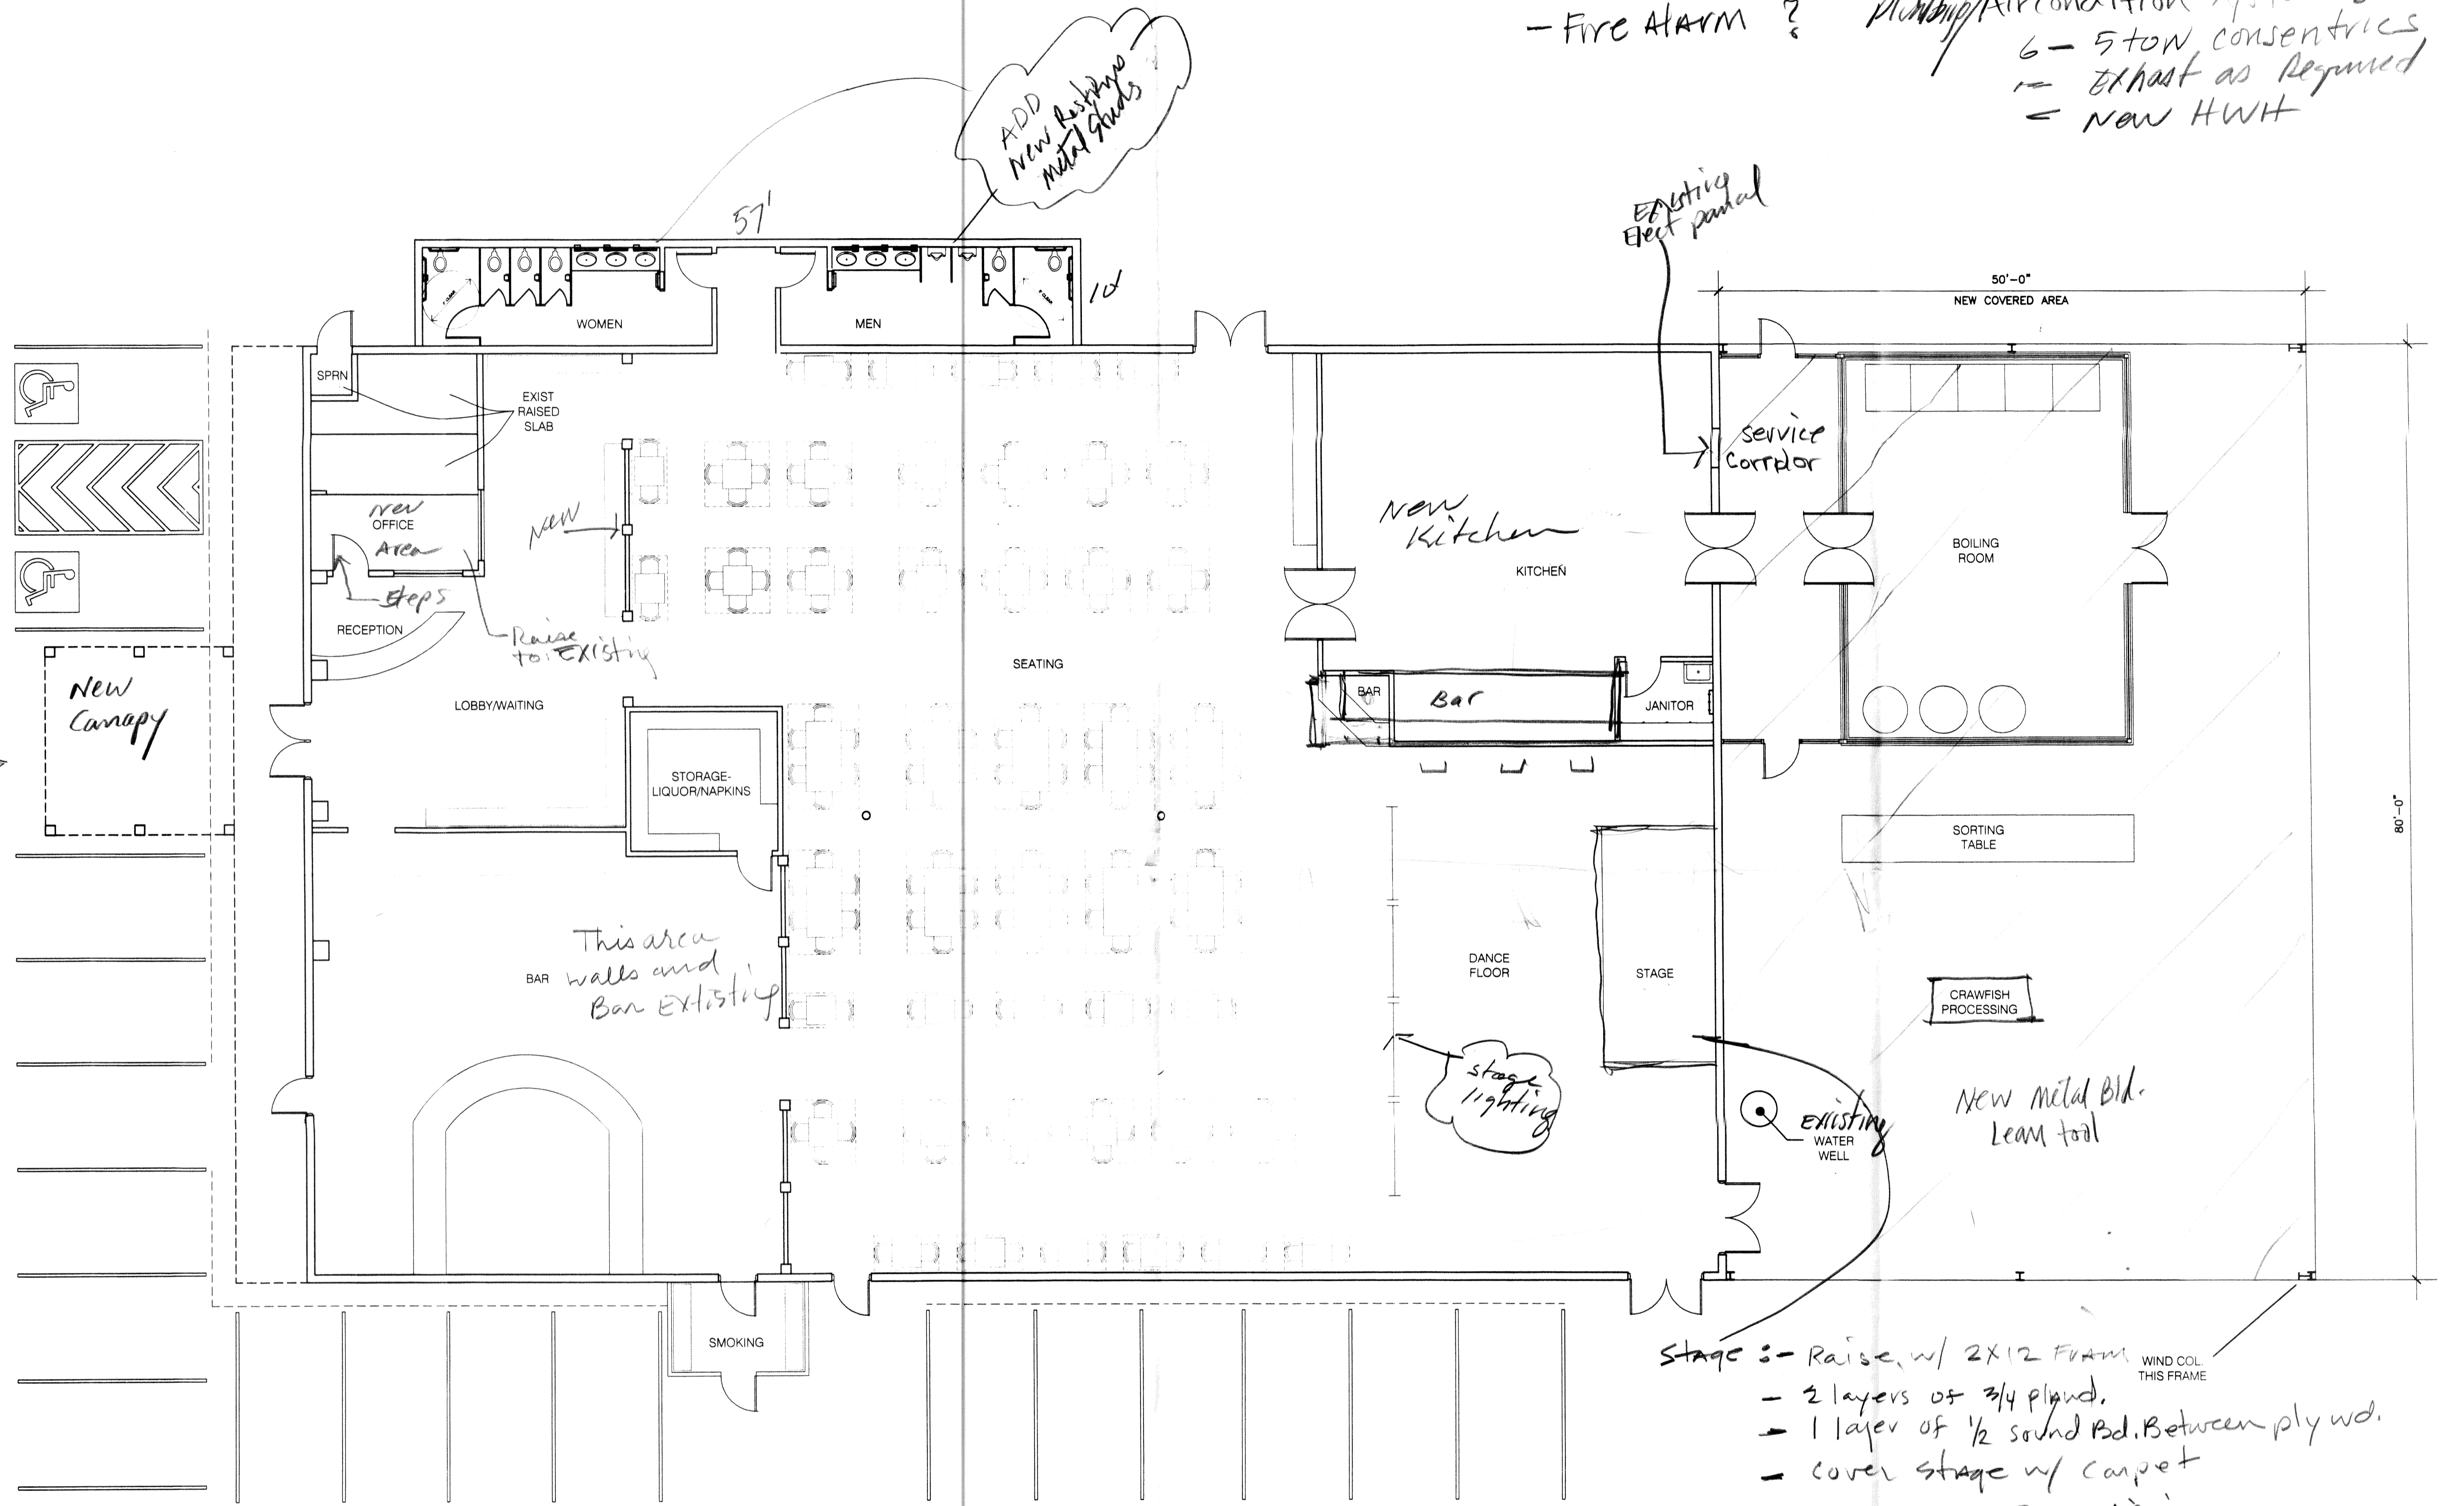

- Stage 3 - Raise w/ 2x12 Fram WIND COL THIS FRAME
 - 2 layers of 3/4 plywd.
 - 1 layer of 1/2 sound Bd. Between ply wd.
 - cover stage w/ carpet
 - Race ways for wiring
 - Electrical work [570] SF RR ADD
 4000 SF ADD ON AREA
 9600 SF EXISTING BLD.



PROJECT
SETH'S ON 700
 4607 HWY 700
 KAPLAN, LOUISIANA 70548

Architectural First Level Plan - Schematic Design Proposal

1'-0"