

Transmittal Memo

From: Service Air & Electrical Co., Inc.
 P.O. Box 334
 Hesser, La. 71341
 318-563-4271 Fax 318-563-8544
 Email: serviceair@bellsouth.net

Attn: DAMMON Eng. Inc

Date: 2-8-10

Re: Child Development Complex - Opel. La. (Electrical)

- For your information
- For approval
- For your use
- Number sheet including cover sheet.

- As requested
- For review and comment
- Quote and Fax:

Ph. 985-641-5950

Remarks: We HAVE met w/ Checo Rep. - Needs 2-4# sch 40 MC and one spare to new pole location as shown on NOT PLAN OK.


We are having the pole lights designed by a lighting co. OK

INTERIOR WIRING IN W/C OK, #12 AWG minimum.


We HAVE added ALL Disconnects NOT shown (MUS-BUILDING C#1-Subpanel)
 Provide disconnect for equipment that does not have internal disc.
 EXTERIOR ENTRANCE FIXTURES TO BE 70 WATT M.H. S.M. FIXTURES (None specified)
 O.K.

Do we need A.F.A. system? No - called out on coversheet.

Robert L. Wilber
 Chief Architect
 Dammon Eng.
 2.9.10

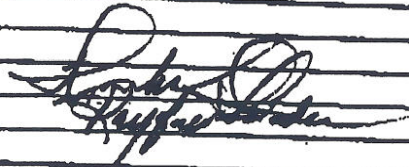

We would like to get some basic submittals on equipment / fixtures.
 Thanks, RLB

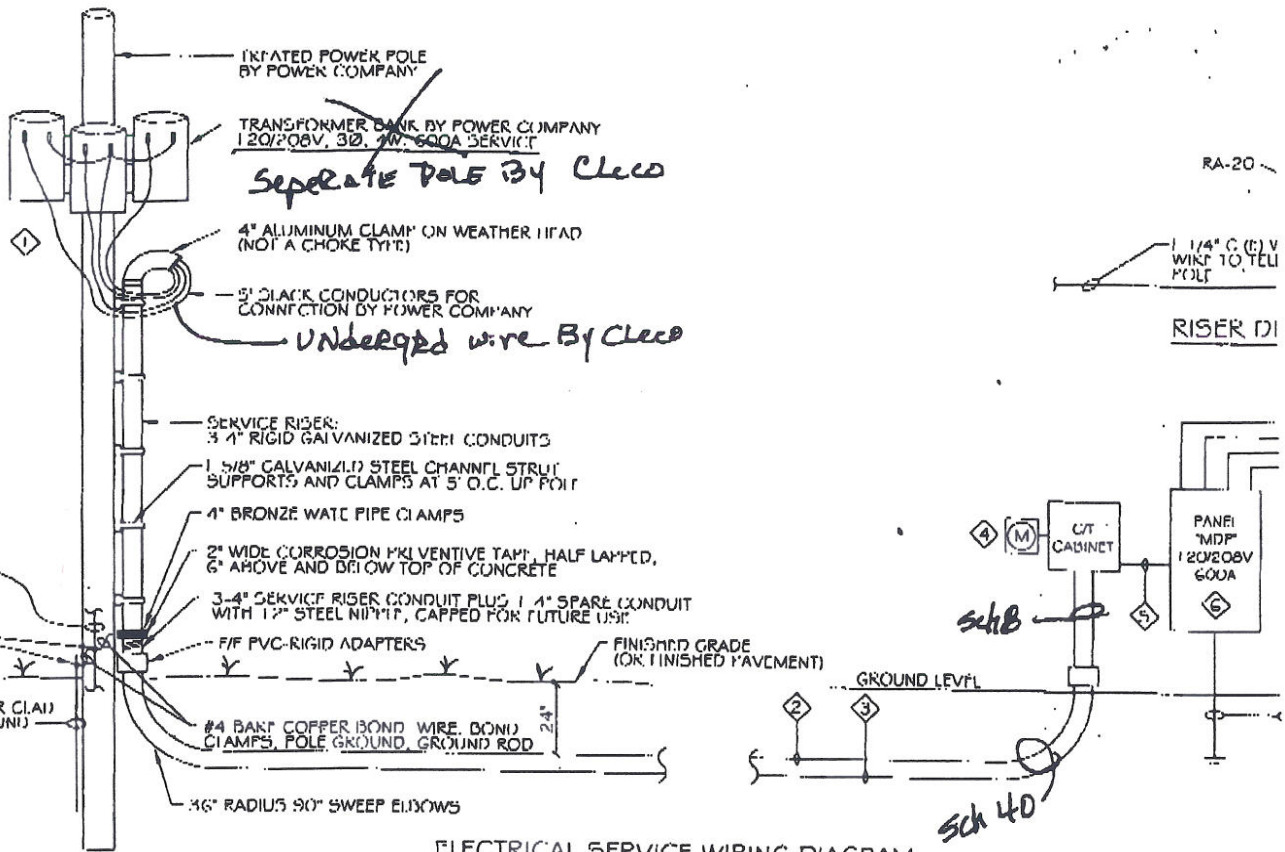

ELECTRICAL SERVICE WIRING DIAGRAM
N.T.S.

SPECIFIC NOTES

- ① UTILITY CO. SERVICE POLE. COORDINATE LOCATION WITH UTILITY CO.
 - ② 120/208V, 3Ø, 600A SERVICE
 - ③ (6)-500 MCM THWN
 - ④ 1 1/4" C (E) V WIRE TO TELL POLE
- By Cleco*

GENERAL NOTES

ALL EQUIPMENT FURNISHED AND ALL WORK REGULATORY INSPECTIONS FOR LOCAL AND LAWS, ORDINANCES, CODES AND RULES OF

