

DAMMON  
ENGINEERING, INC.

CHIEF ENGINEER  
EMMETT  
DAMMON, P.E.

CHIEF ARCHITECT  
ROBERT  
WILTSE

1 095 FLORIDA AVENUE  
SLIDELL, LA. 70458  
OFFICE: 985-649-5832  
FAX: 985-641-5950

WEBSITE:  
WWW.DAMMONENGINEERING.COM

EMAIL:  
DAMMONENG@BELLSOUTH.NET

ARCHITECTURE

ENGINEERING

STUDIES

PLANNING

INVESTIGATION

EXPERT WITNESS

NEW OFFICE  
COMPLEX

CHILD DEVELOPMENT  
COUNCIL OF  
ACADIANA, INC.  
OPELOUSAS, LA

BUILDING  
ELEVATIONS

REV: 12-7-09 FOR CONST.

8-3-10 CO

SCALE: AS NOTED


JOB#: 2030

DATE: 10-19-09


SHEET 12

A-3

OF 26

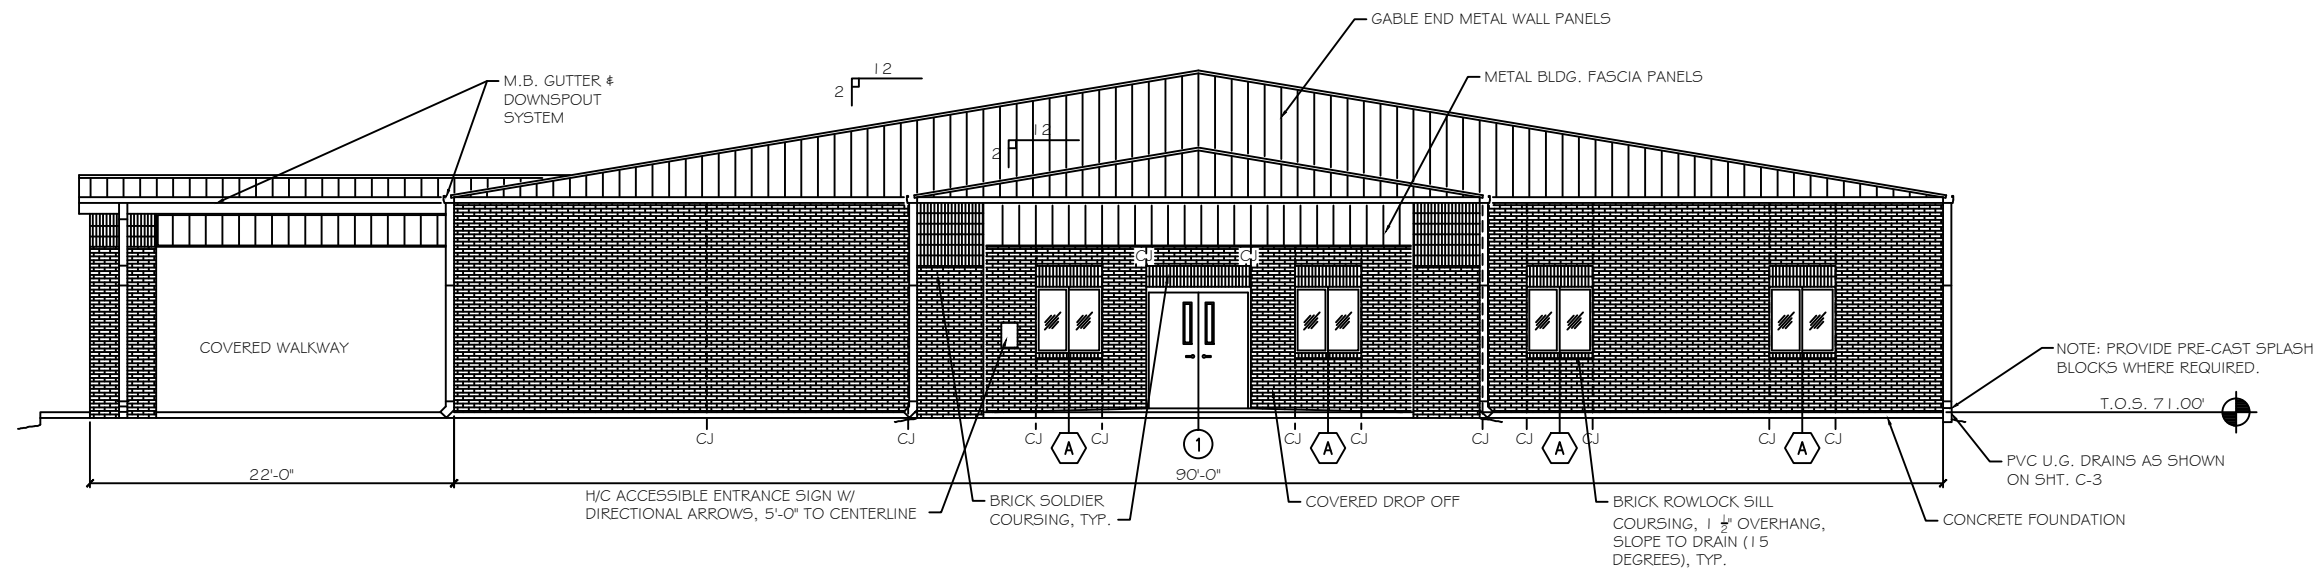

WEST ELEVATION  
SCALE: 3/16" = 1'-0"

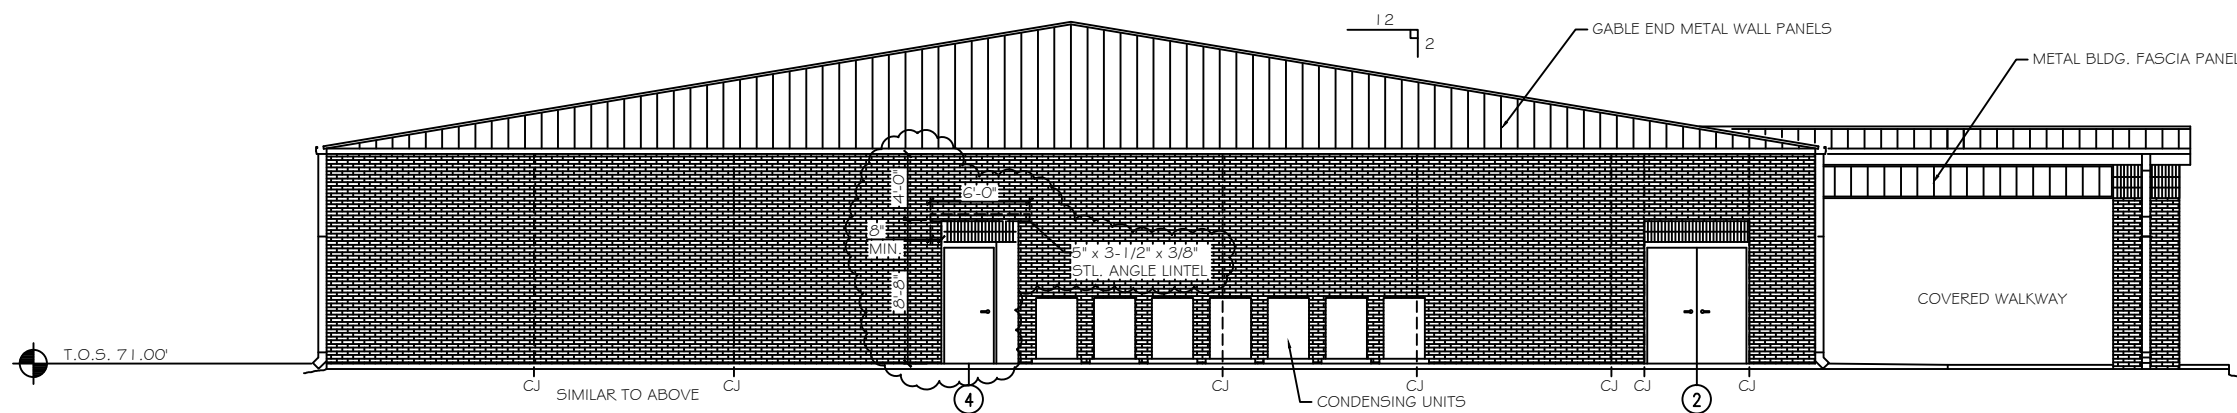

EAST ELEVATION  
SCALE: 3/16" = 1'-0"