
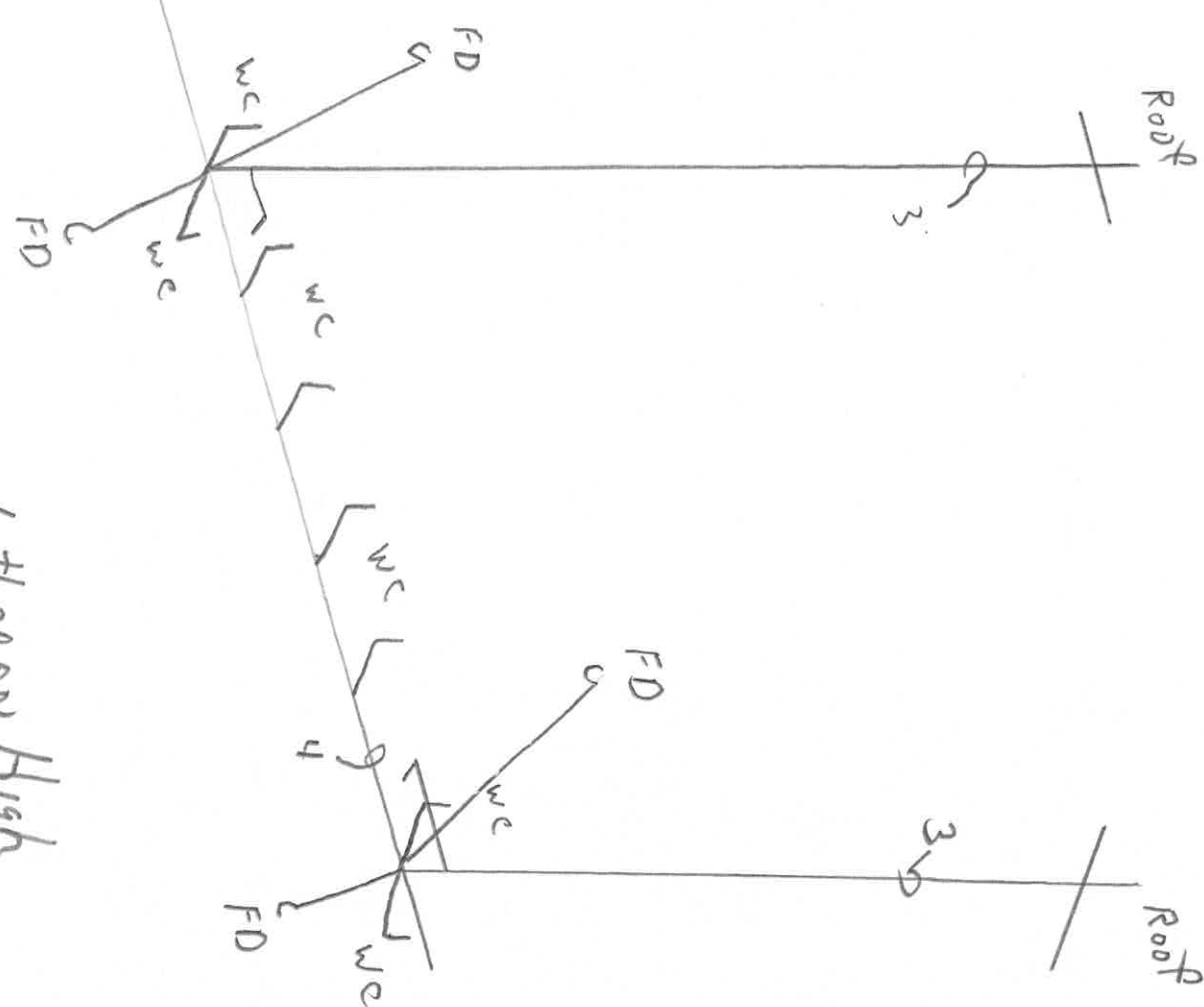


Lutheran High School
Boys Bathroom

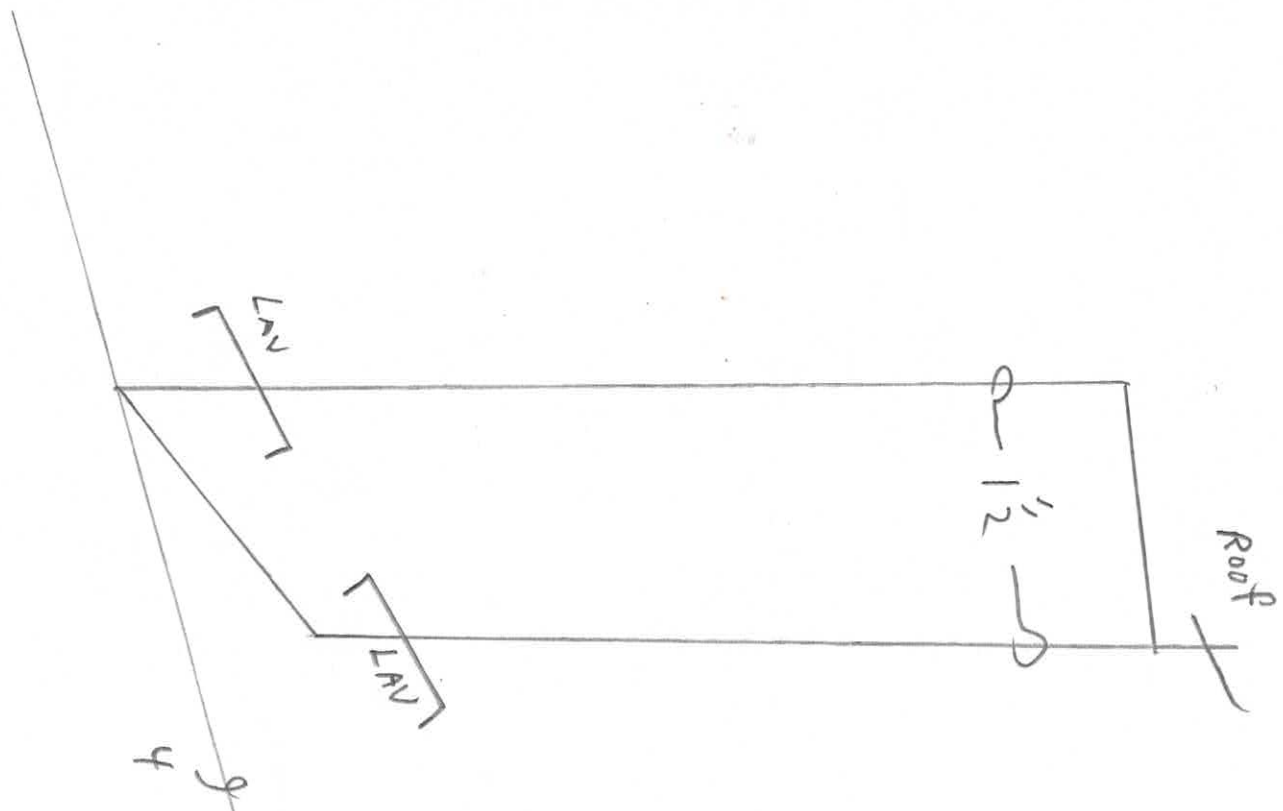

Lutheran High
 School
 Girls Bathroom