


WAREHOUSE STAIR DETAIL
SCALE: 1/4"=1'-0"

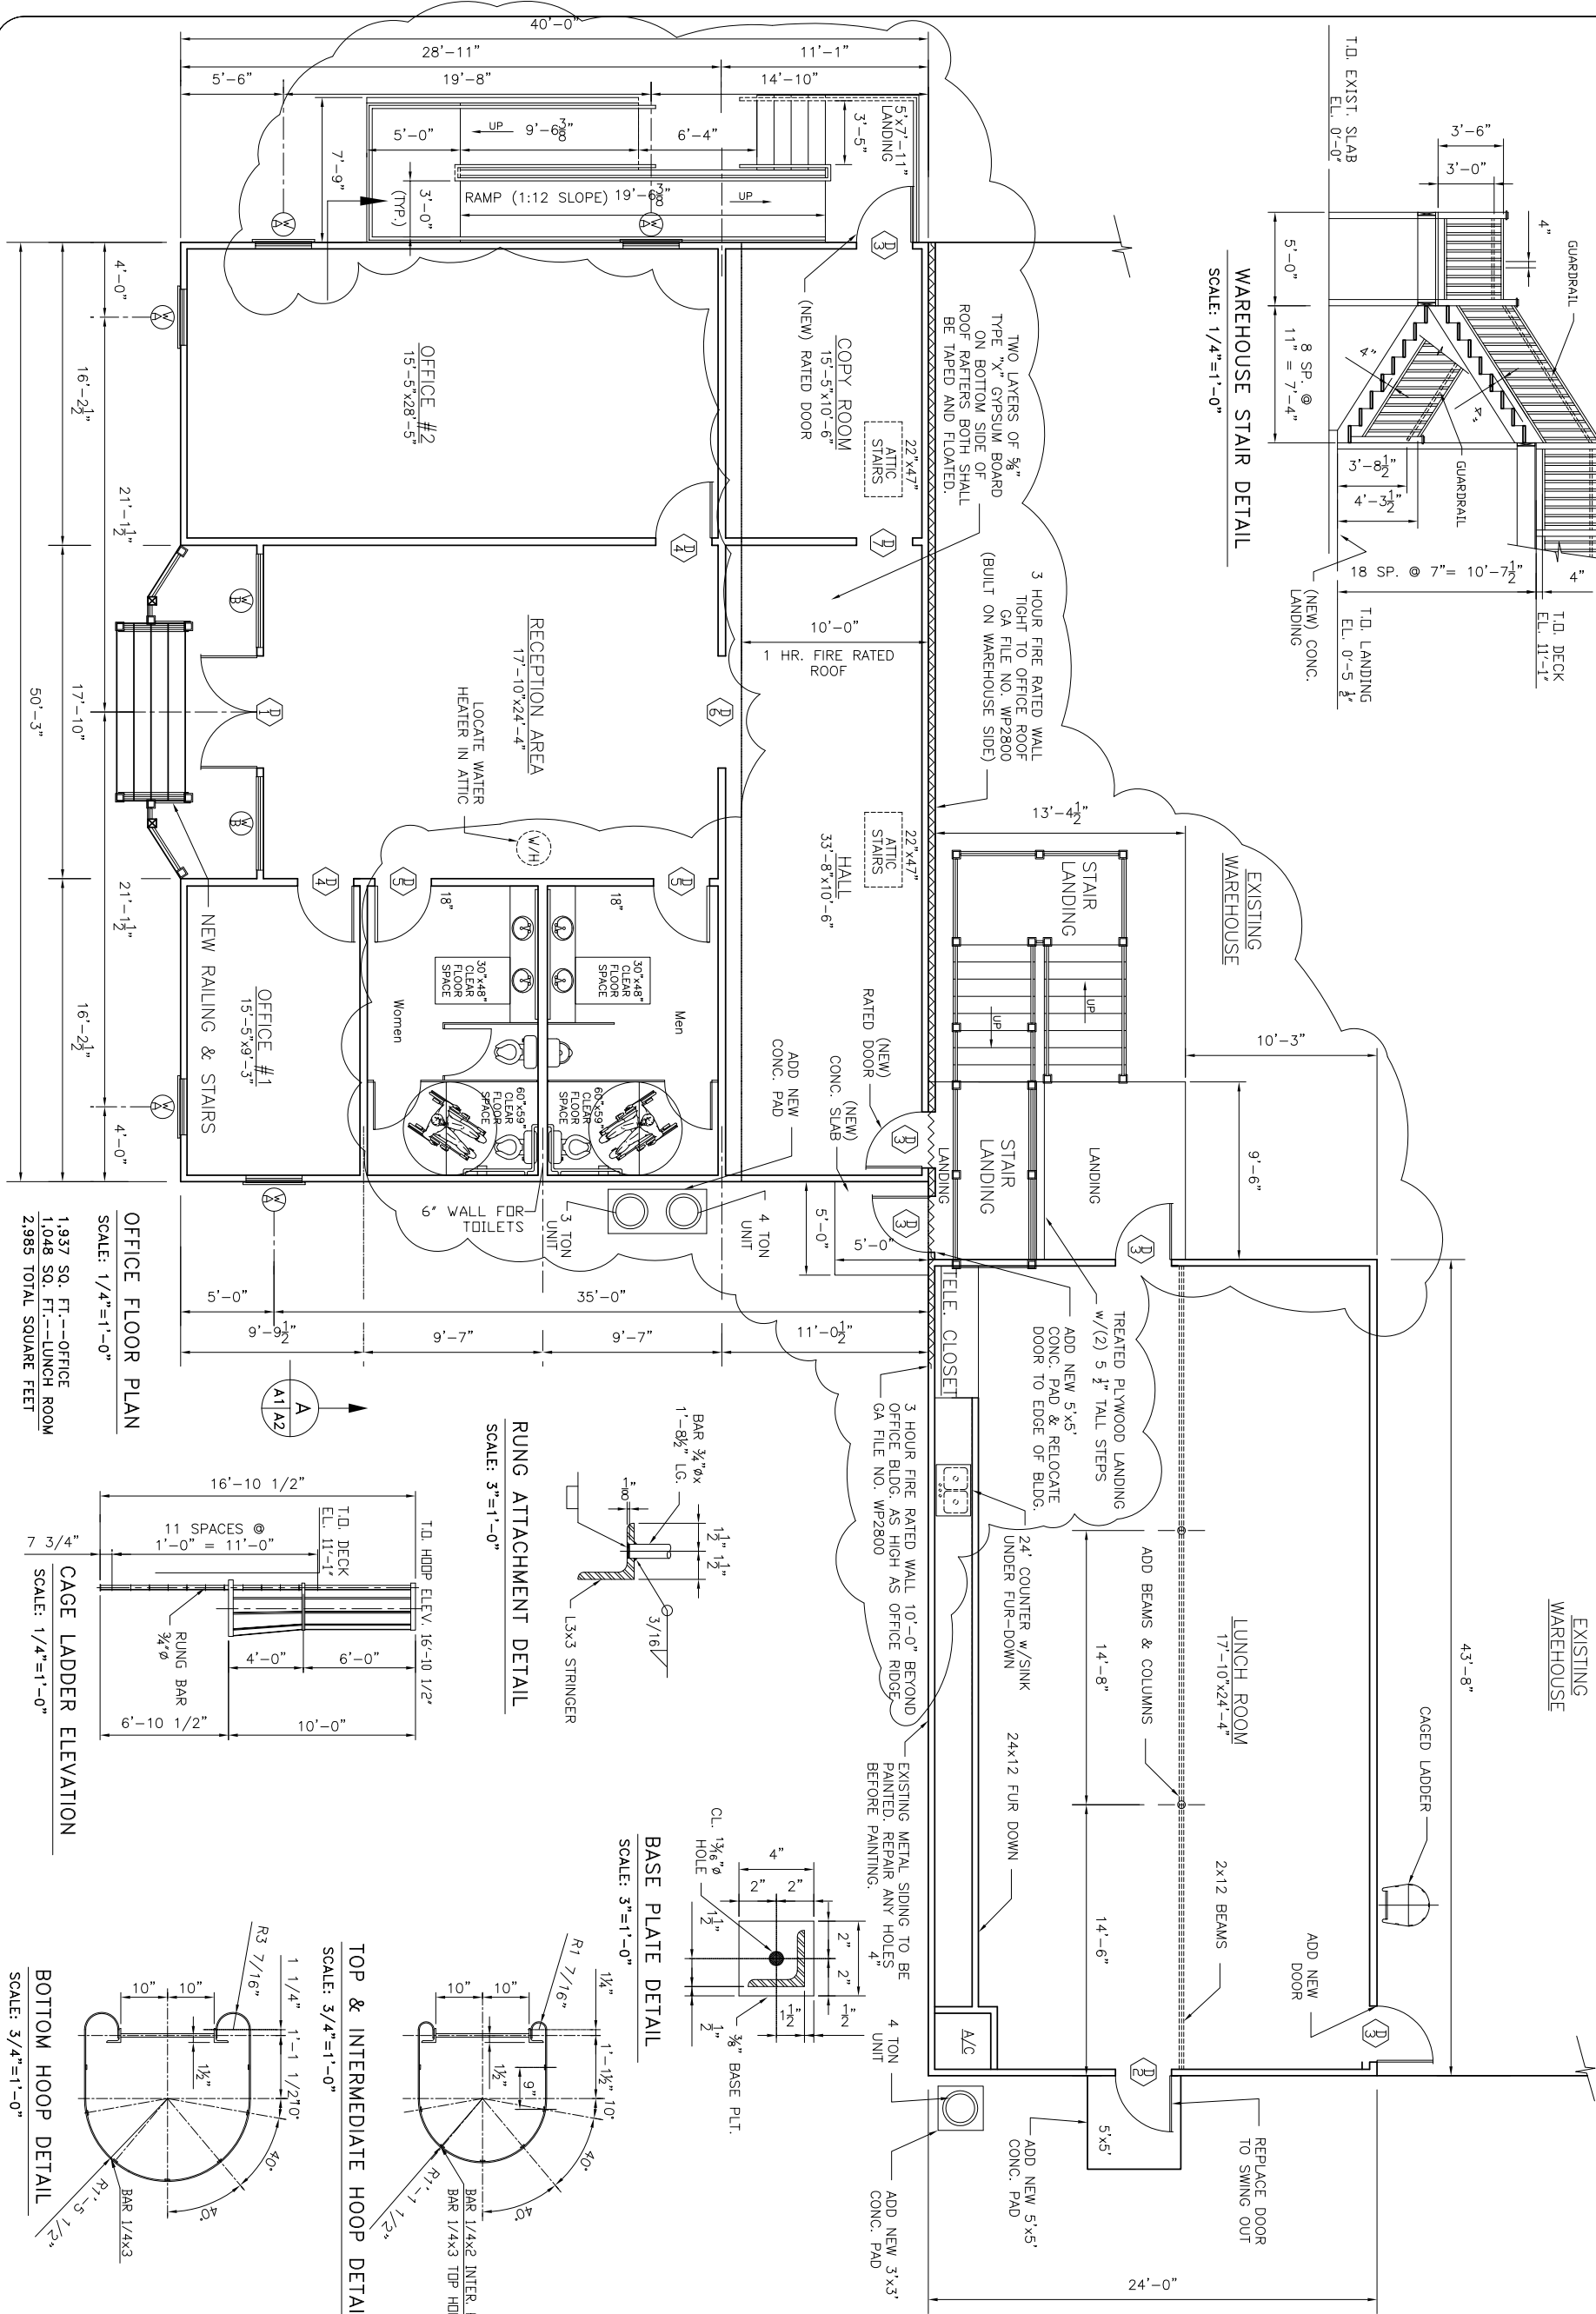

RUNG ATTACHMENT DETAIL

BASE PLATE DETAIL

TOP & INTERMEDIATE HOOP DETAIL
SCALE: 3/4"=1'-0"

OFFICE FLOOR PLAN
SCALE: 1/4"=1'-0"

CAGE LADDER ELEVATION
SCALE: 1/4"=1'-0"

BOTTOM HOOP DETAIL
SCALE: 3/4"=1'-0"

01/31/05 REVISED FIREWALL ON WAREHOUSE, REVISED BATHROOM
12/21/04 ADDED FIREWALL NOTE, STOOP, CHANGED DOOR SWING

FLOOR PLAN

TEXTRON MARINE & LAND
2582 FRONT STREET
SLIDELL, LOUISIANA

TEXTRON OFFICE/WAREHOUSE RENOVATION
DAMMON ENGINEERING, INC.
1095 FLORIDA AVENUE 985-649-5832 SLIDELL, LA. 70458
DAMMONENGINEERING.COM

SCALE: AS NOTED

FILE:

JOB NO. 1641

DATE: 12-02-04

SHEET

A-1

OF