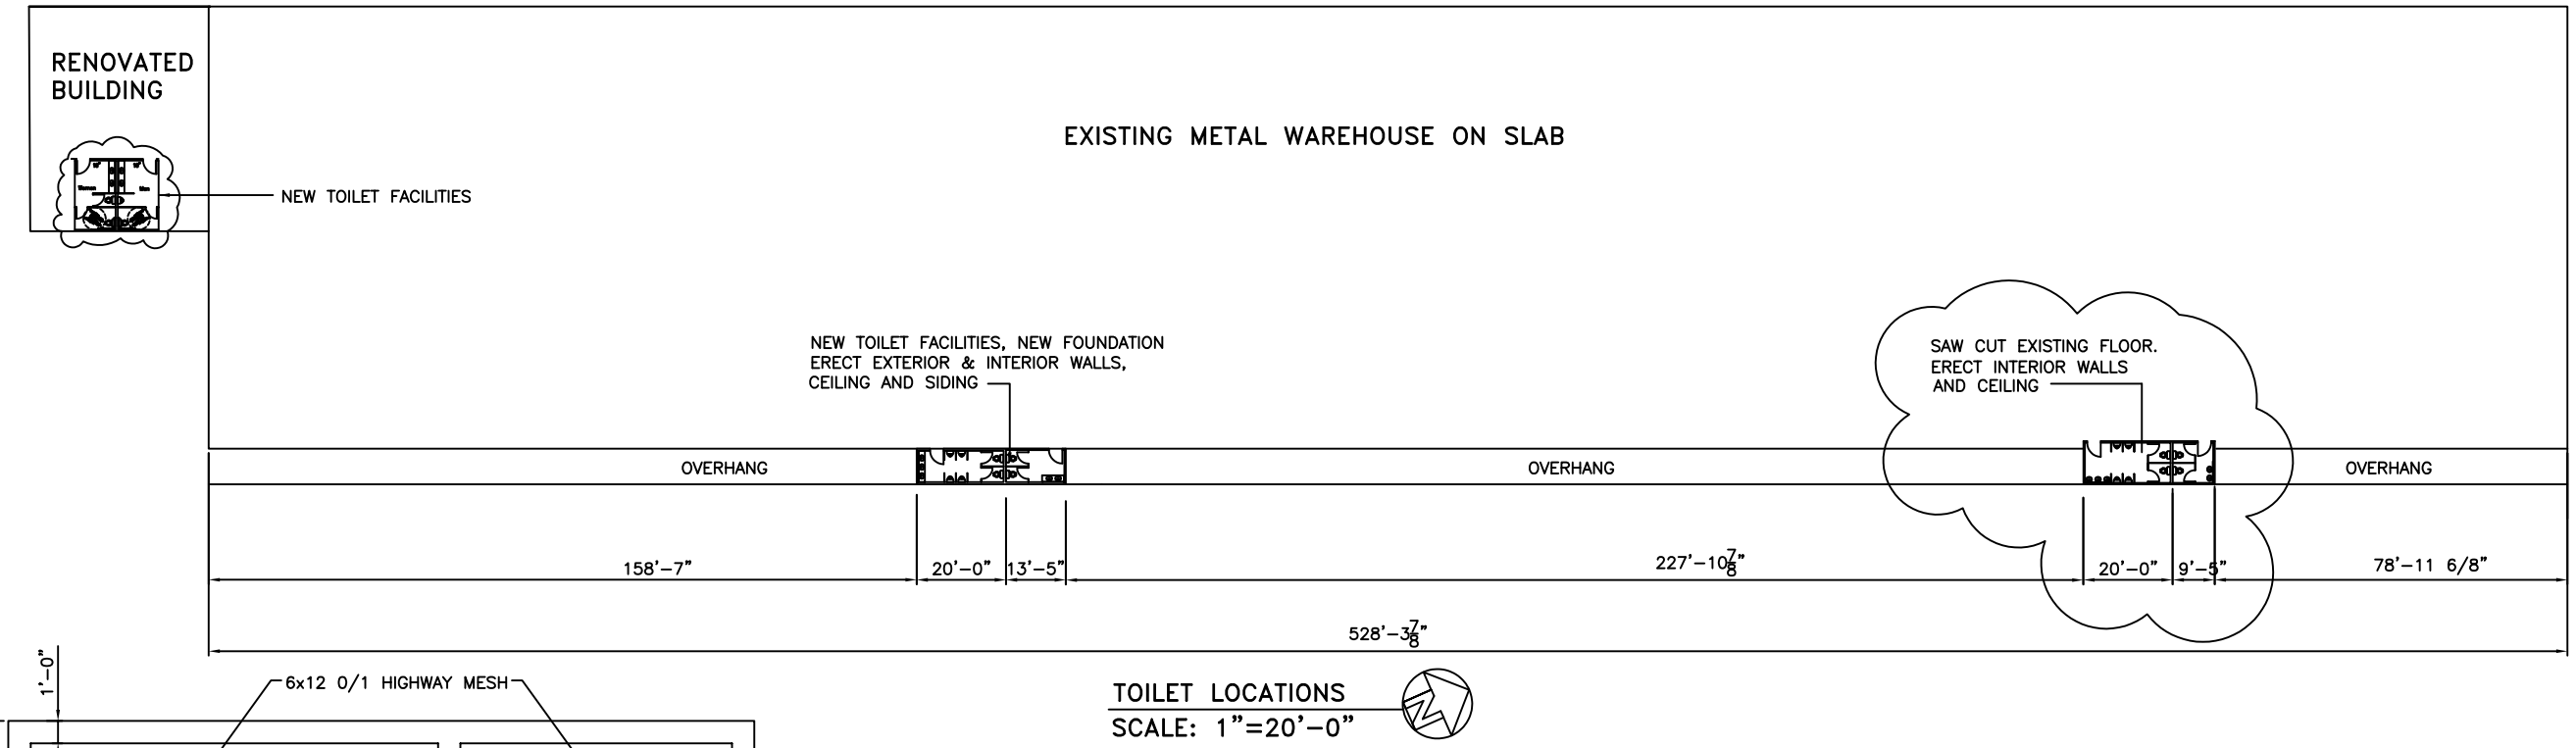

TOILET LOCATIONS
SCALE: 1"=20'-0"

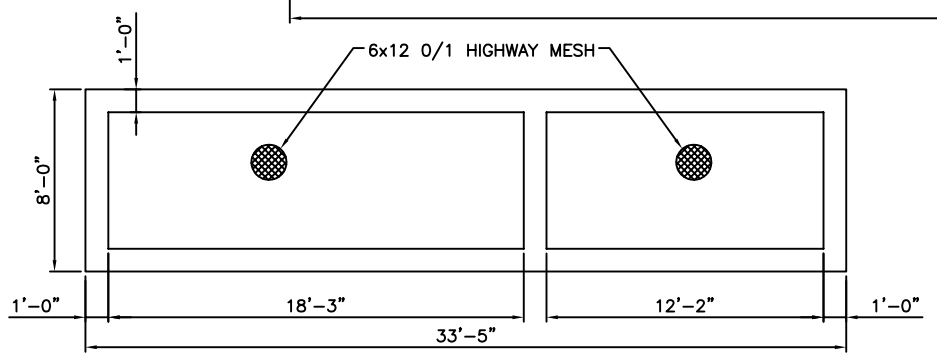

SOUTH RESTROOM FOUNDATION PLAN
SCALE: 1/4"=1'-0"

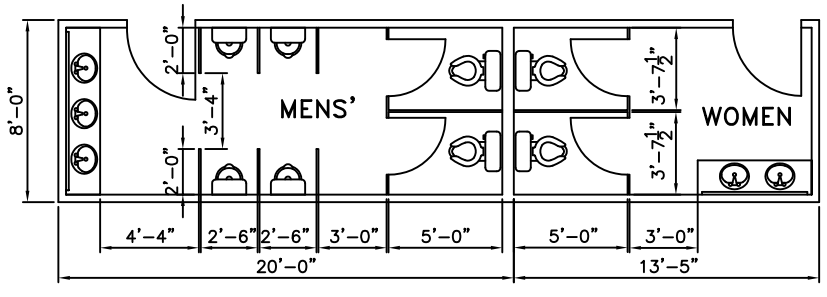

SOUTH WAREHOUSE TOILETS
SCALE: 1/4"=1'-0"

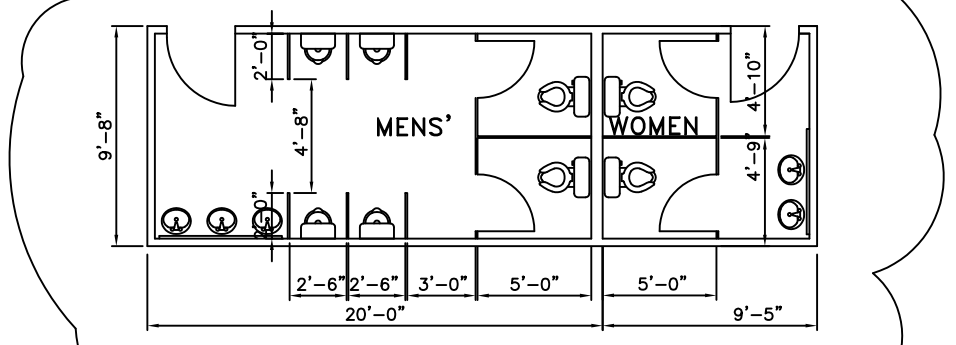

NORTH WAREHOUSE TOILETS
SCALE: 1/4"=1'-0"

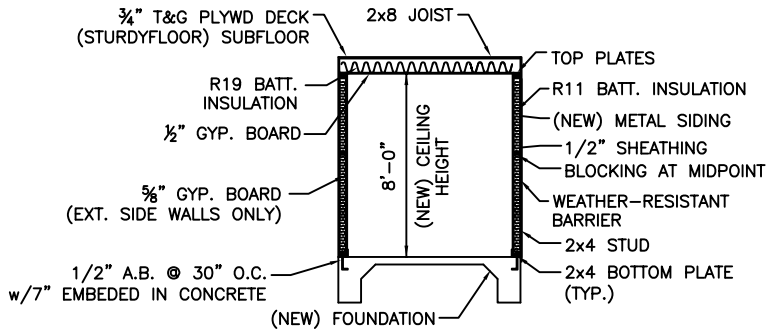

SECTION THRU RESTROOM
SCALE: N.T.S.

(CAULK ALL ALL JOINTS)

(FLASH AS AS REQ'D)

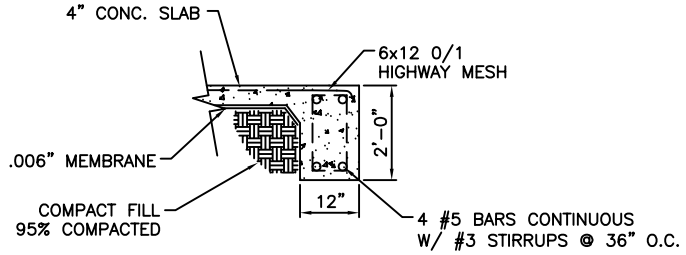

END SECTION
N.T.S.

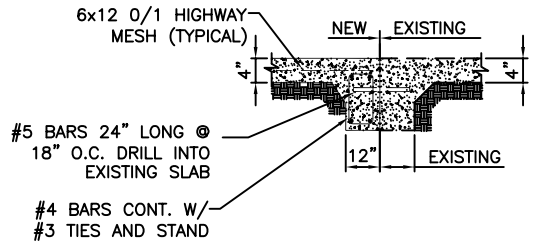

SECTION AT END OF BLDG.
N.T.S.

1 01-10-05 REVISED PLUMBING
2 02-02-05 REVISED RESTROOM LAYOUT IN OFFICE

TOILET LOCATIONS

TEXTRON MARINE & LAND
2585 FRONT STREET
SLIDELL, LOUISIANA

TEXTRON OFFICE/WAREHOUSE RENOVATION

DAMMON ENGINEERING, INC.
ARCHITECTS — ENGINEERS
1095 FLORIDA AVENUE 985-649-5832 SLIDELL, LA. 70458
DAMMONENGINEERING.COM

SCALE:AS NOTED
FILE:
JOB NO.1641
DATE:12-02-04
SHEET
A-6
OF