504-254-6715
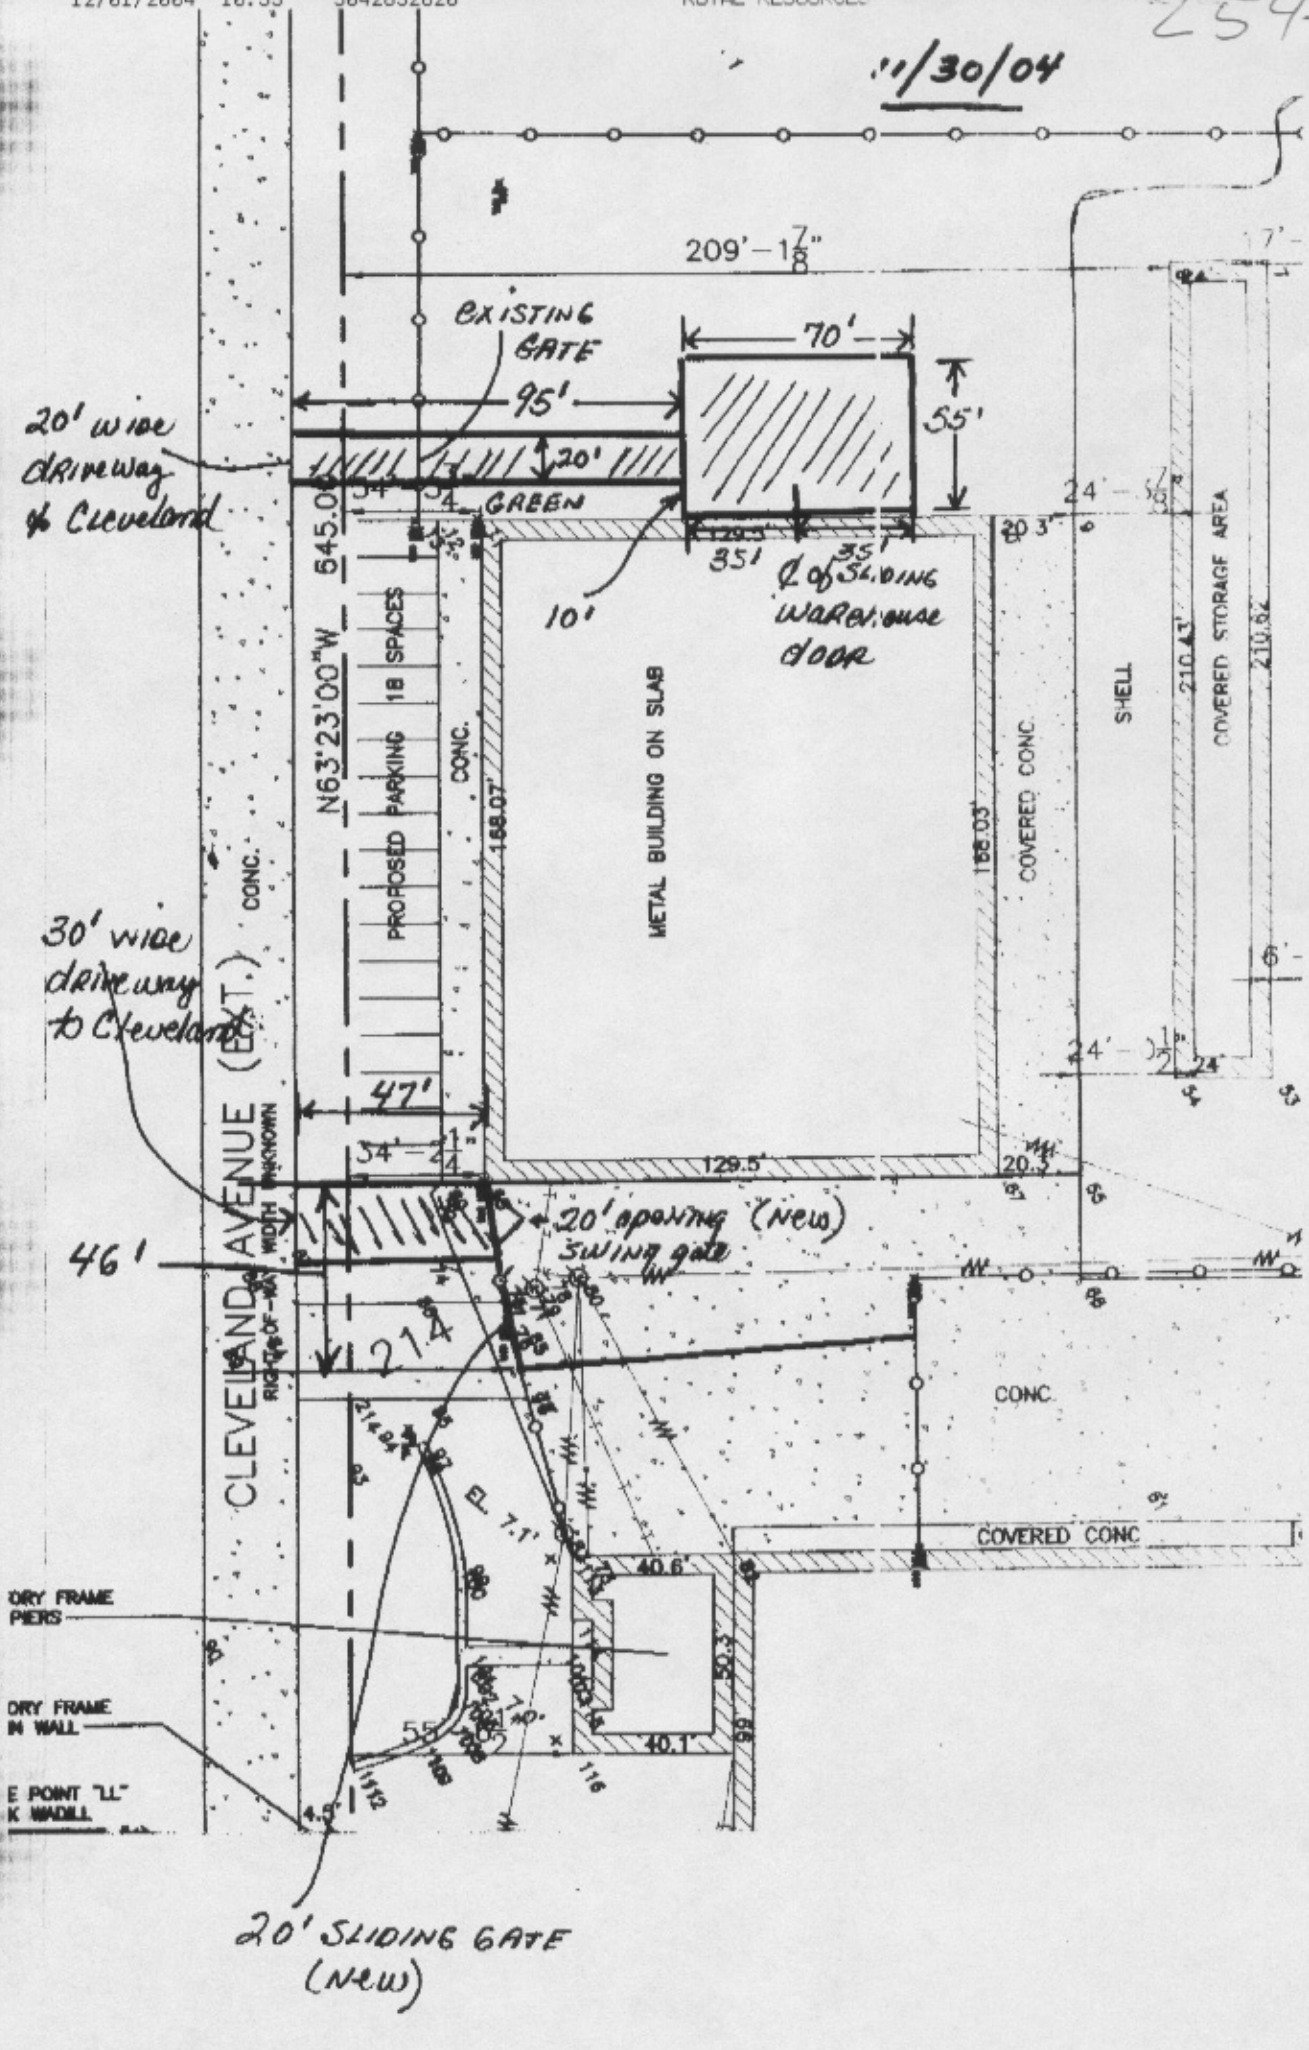
11/30/04