


ARCHITECTURAL ABBREVIATIONS

&	AND	MAS	MASONRY
@	AT	MAINT	MAINTENANCE
#	NUMBER, POUNDS	MATL	MATERIAL
+/-	PLUS OR MINUS	MAX	MAXIMUM
		MBM	METAL BUILDING MANUFACTURER
A.B.	ANCHOR BOLT	MBTB	MARKER BOARD / TACK BOARD
A/C	AIR CONDITIONING	MC	MEDICINE CABINET
ACOU	ACOUSTICAL	MECH	MECHANICAL
ADJ.	ADJUSTABLE	MFR, MANUF	MANUFACTURER
AFF	ABOVE FINISHED FLOOR	MGR	MANAGER
AHU	AIR HANDLING UNIT	MH	MANHOLE
ALUM	ALUMINUM	MIN	MIDDLE
ALT	ALTERNATE	MISC	MISCELLANEOUS
ANOD	ANODIZED	MM	MILLIMETER
APPROX	APPROXIMATELY	MO	MASONRY OPENING
ARCH	ARCHITECT(URAL)	MPH	MILES PER HOUR
AUX	AUXILIARY	MTL	METAL
BD	BOARD	N.	NORTH
BD, BM.	BOND BEAM	N.E.	NORTHEAST
BLDG	BUILDING	N.W.	NORTHWEST
BLK	BLOCK	NA	NOT APPLICABLE
BLKG	BLOCKING	NEG	NEGATIVE
BM	BEAM	NIC	NOT IN CONTRACT
BOS	BOTTOM OF STEEL	NO, #	NUMBER
BOT	BOTTOM	NOM.	NOMINAL
BRG.	BEARING	NTS	NOT TO SCALE
B.W.	BOTH WAYS		
CAB	CABINET	OC	ON CENTER
C.F.	CUBIC FEET	OD	OUTSIDE DIAMETER/DIMENSION
CFMF	COLD-FORMED METAL FRAMING	OH	OVERHEAD
CSB	CHALK BOARD / TACK BOARD		
CJ	CONTROL JOINT	P/C (PC)	PRECAST CONCRETE
CL, C	CENTER LINE	PL, C	PLATE
CLG	CEILING	PLM	PLASTIC LAMINATE
CLO	CLOSET	PLF	POUNDS PER LINEAL FOOT
CLR	CLEAR	PNL	PANEL
CMU	CONCRETE MASONRY UNIT	PNT	PAINT, PAINTED
COL	COLUMN	POS	POSITIVE
CONC	CONCRETE	PR	PAIR
CONST.	CONSTRUCTION	PREFAB	PREFABRICATED
CONST. CONST.	CONSTRUCTION JOINT	PREFIN	PREFINISHED
CONT	CONTINUOUS	PSF	POUNDS PER SQUARE FOOT
CONTR.	CONTRACTOR	PSI	POUNDS PER SQUARE INCH
CORR	CORRIDOR	PT	PRESSURE TREATED
CT	CERAMIC TILE	PTN	PARTITION
CTL	CONTROL	PVC	POLYVINYL CHLORIDE
C.Y.	CUBIC YARD	PWD	PLYWOOD
DBL	DOUBLE	QT	QUARRY TILE
DEMO	DEMOLISH, DEMOLITION		
DF	DIAMETER	R	RADIUS
DIA, Ø	DIAGONAL	RBR	RUBBER
DIM(S)	DIMENSION(S)	RD	ROOF DRAIN
DN	DOWN	REIN	REINFORCED, REINFORCEMENT
DR	DOOR	REF	REFER, REFERENCE
DS	DOWNSPOUT	REQD	REQUIRED
DTL	DETAIL	REV	REVERSE(D), REVISED
DWG	DRAWING	RO	ROUGH OPENING
		RM	ROOM
		RTU	ROOM TOP UNIT
E	EAST	S.	SOUTH
ELEC	ELECTRICAL	S.E.	SOUTHEAST
EA	EACH	S.W.	SOUTHWEST
EIFS	EXTERIOR INSULATION FINISH SYSTEM	SAC	SUSPENDED ACOUSTICAL CEILING
EJ	EXPANSION JOINT	SC	SOLID CORE
EL, ELEV	ELEVATION	SCHED	SCHEDULE
EQ	EQUAL	SD	SMOKE DETECTOR
EQUIP	EQUIPMENT	SF	SQUARE FEET
ETC	ET CETERA	SGL	SINGLE
EW	ELECTRIC WATER COOLER	SHT	SHEET
EXIST	EXISTING	SHWR	SHOWER
EXP	EXPOSED	SIM	SIMILAR
EXT	EXTERIOR	SND	SANITARY NAPKIN DISPOSAL UNIT
		SPEC.	SPECIFICATION(S)
FD	FLOOR DRAIN	SQ	SQUARE
FE	FIRE EXTINGUISHER	SR	SHOWER ROD
FEC	FIRE EXTINGUISHER CABINET	SS	STAINLESS STEEL
FF	FINISH FLOOR	STD	STANDARD
FFE	FINISH FLOOR ELEVATION	STL	STEEL
FG	FIBERGLASS	STOR	STORAGE
FIN	FINISH	STRUCT	STRUCTURE, STRUCTURAL
FLR	FLOOR	SYMB	SYMBOL
FND	FOUNDATION		
FOC	FACE OF CONCRETE		
FOM	FACE OF MASONRY		
FR	FIRE-RETARDANT	T&B	TOP AND BOTTOM
FRWD	FIRE-RETARDANT TREATED WOOD	T&G	TONGUE AND GROOVE
FT	FEET OR FOOT	TEL	TELEPHONE
FTG.	FOOTING	TECH	TECHNICAL
		TEMP	TEMPERATURE
G	GAS	TCC	TOP OF CONCRETE
GA	GAUGE	TOD	TOP OF DRAIN
GALV	GALVANIZED	TOF	TOP OF FOOTING
GB	GRAB BAR	TOM	TOP OF MASONRY
GC	GENERAL CONTRACTOR	TOS	TOP OF STEEL
GD	GRADE	TOW	TOP OF WALL
GDW, GYP. BD.	GYP. DRYWALL	TP	TOILET PARTITION
GEN	GENERAL	TTD	TOILET TISSUE DISPENSER
GL	GLASS	TP	TYPICAL
GND	GROUND		
		UNO	UNLESS NOTED OTHERWISE
HB	HOSE BIBB	URL	URINAL
HC	HANDICAPPED	URS	URINAL SCREEN
HDR	HEADER	UTIL	UTILITY
HDWR	HARDWARE		
HEWC	HANDICAP ELECTRIC WATER COOLER	VERT	VERTICAL
HM	HOLLOW METAL	VCT	VINYL COMPOSITION TILE
HORIZ	HORIZONTAL	VTR	VENT THROUGH ROOF
HR, HRS	HOUR, HOURS	WVC	VINYL WALL COVERING
HT	HEIGHT		
ID	INSIDE DIAMETER, DIMENSION	W, /	WEST
IN	INCH, INCHES	WC	WATER CLOSET, TOILET
INCL	INCLUDE(D), INCLUDING	WD	WOOD
INSUL	INSULATION	WH	WATER HEATER
INT	INTERIOR	W/O	WITHOUT
IRWC	IMPACT-RESISTANT WALL COVERING	WT	WEIGHT
		WWF	WELDED-WIRE FABRIC
JAN	JANITOR		
JST	JOIST		
JT	JOINT		
K.	KIPS		
K.O.	KNOCK OUT		
L	ANGLE SHAPE		
LAM	LAMINATE		
LAV	LAVATORY		
LB	POUND		
LF	LINEAR FOOT (FEET)		
LG	LIGHT GAUGE		
LLH	LONG LEG HORIZONTAL		
LLV	LONG LEG VERTICAL		
LVL	LAMINATED VENEER LUMBER		
LVR	LOUVER		

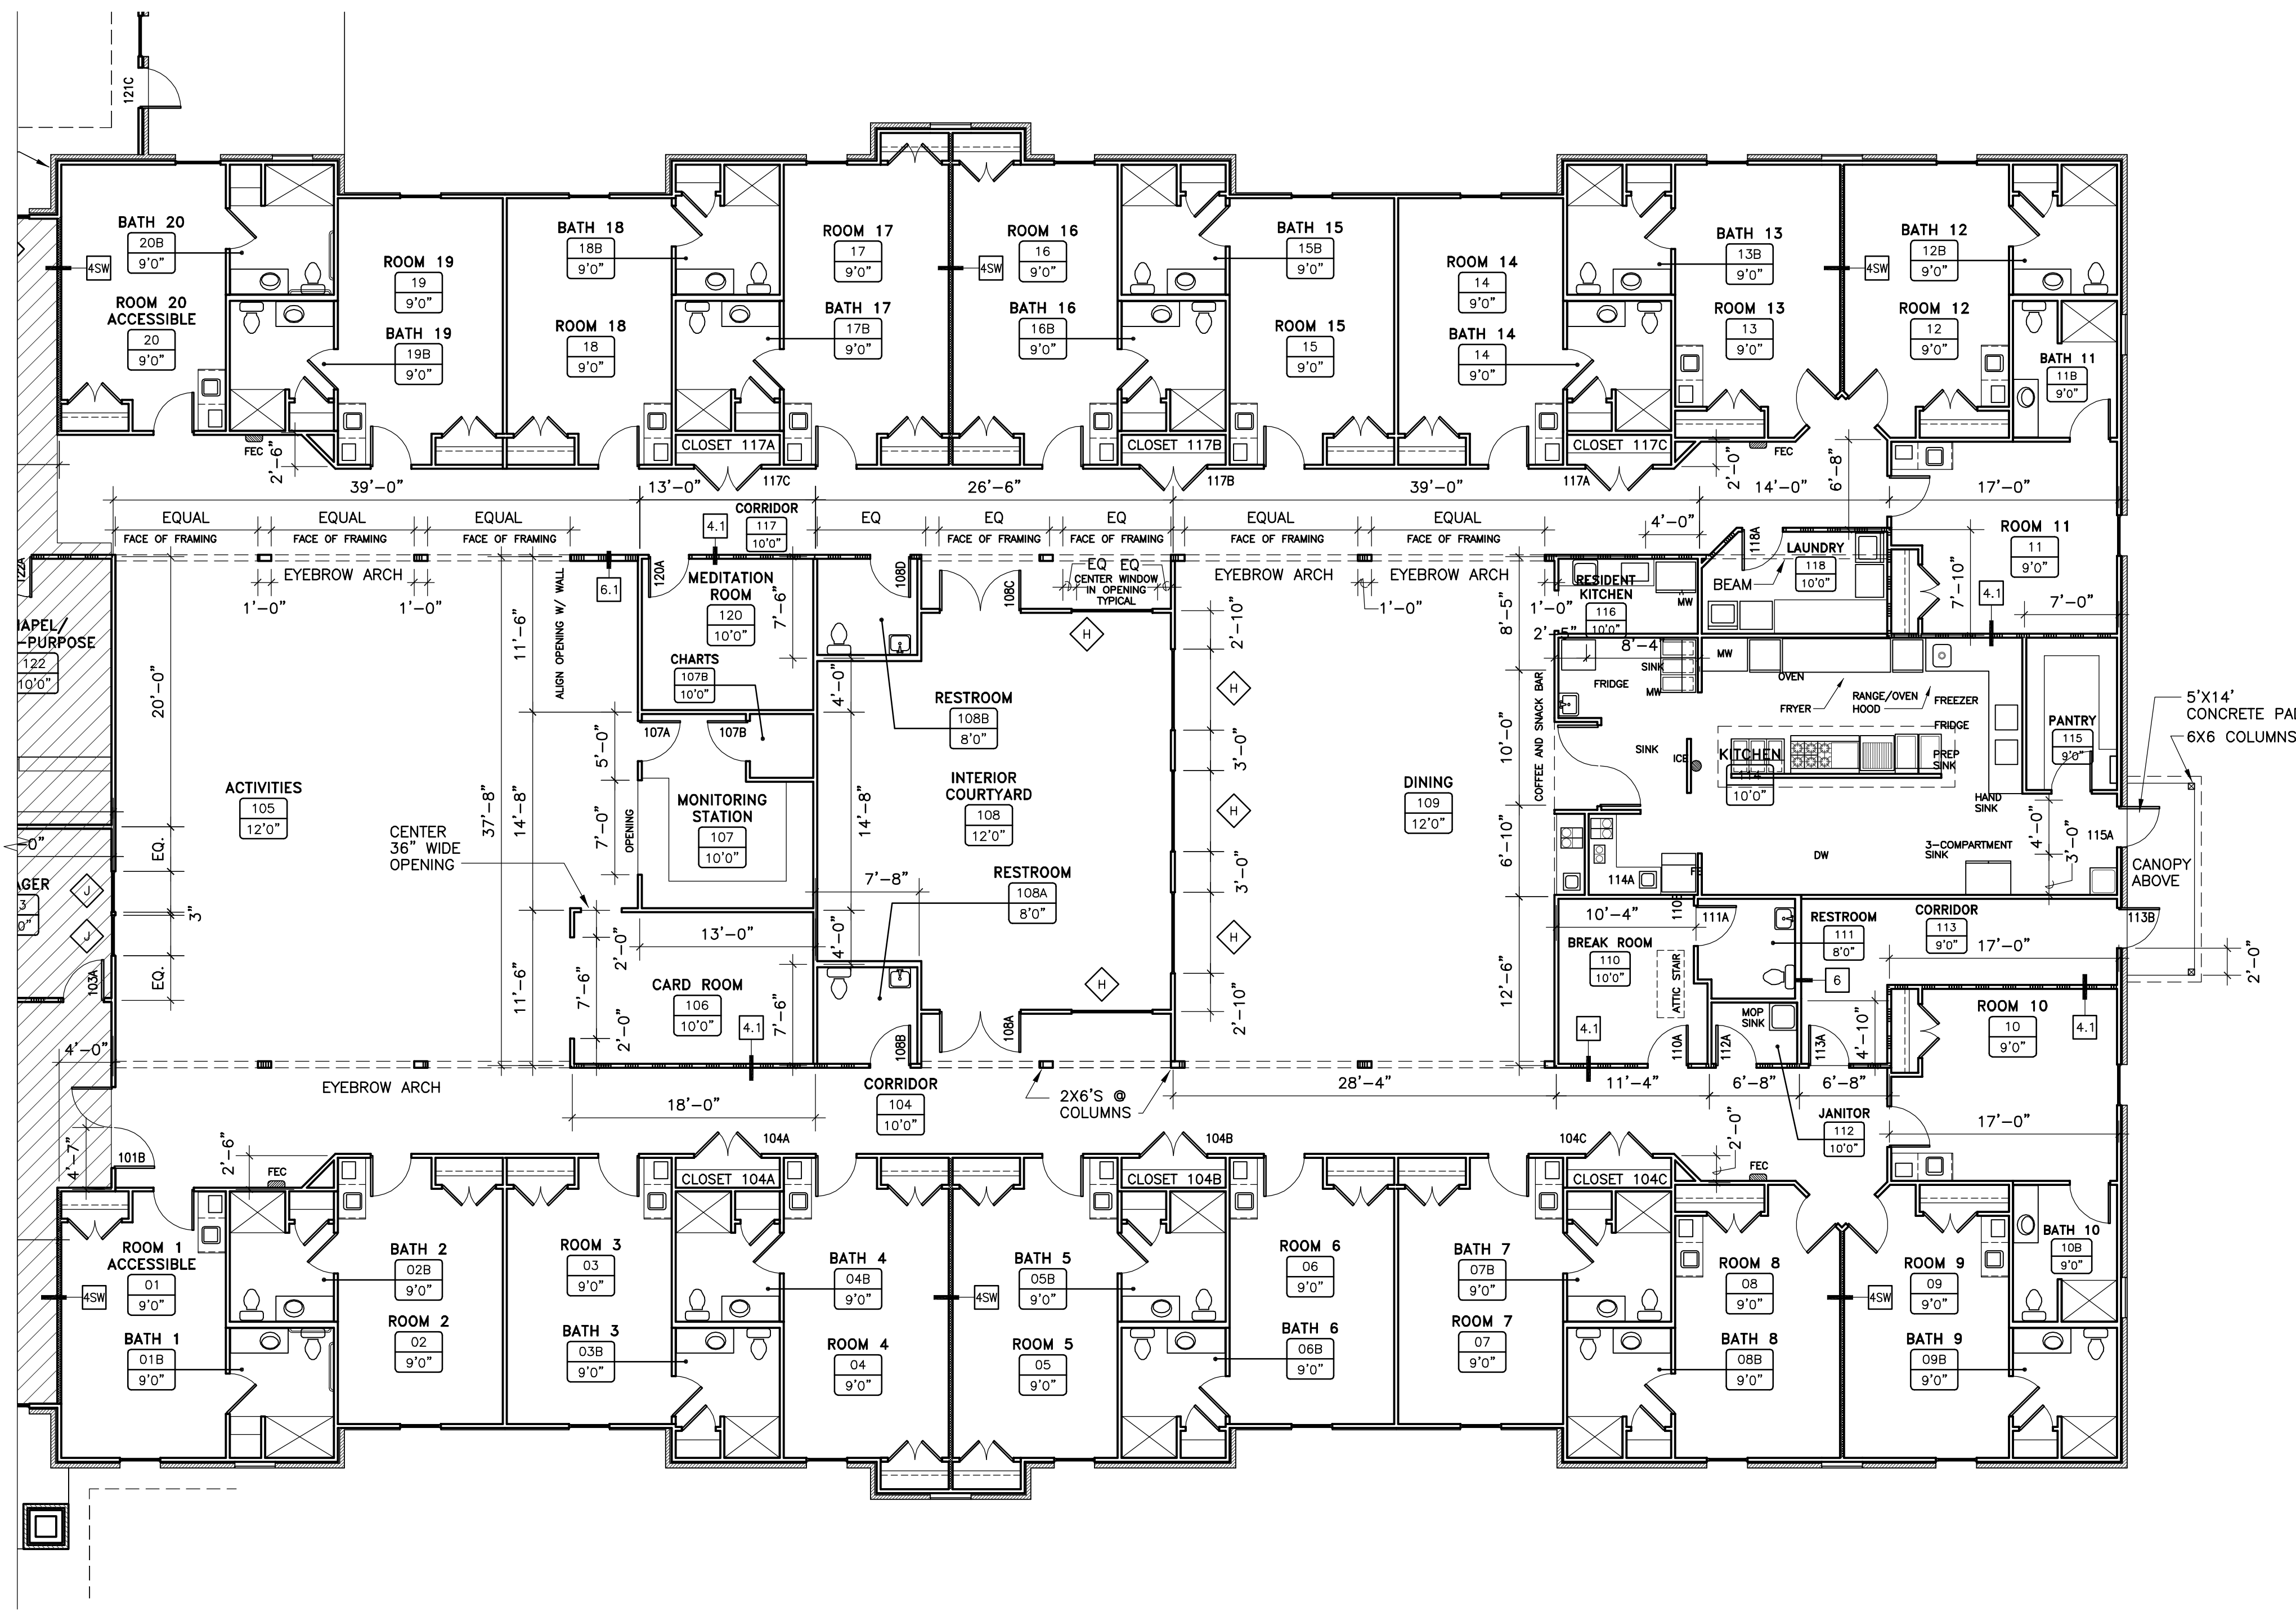


1 FLOOR PLAN - NORTH SIDE
SCALE: 1/8" = 1'-0"


PLAN LEGEND

1-HOUR WALL
1-HOUR RATED SMOKE BARRIER
SHEAR WALL

SEE A2.2 FOR WALL TYPES

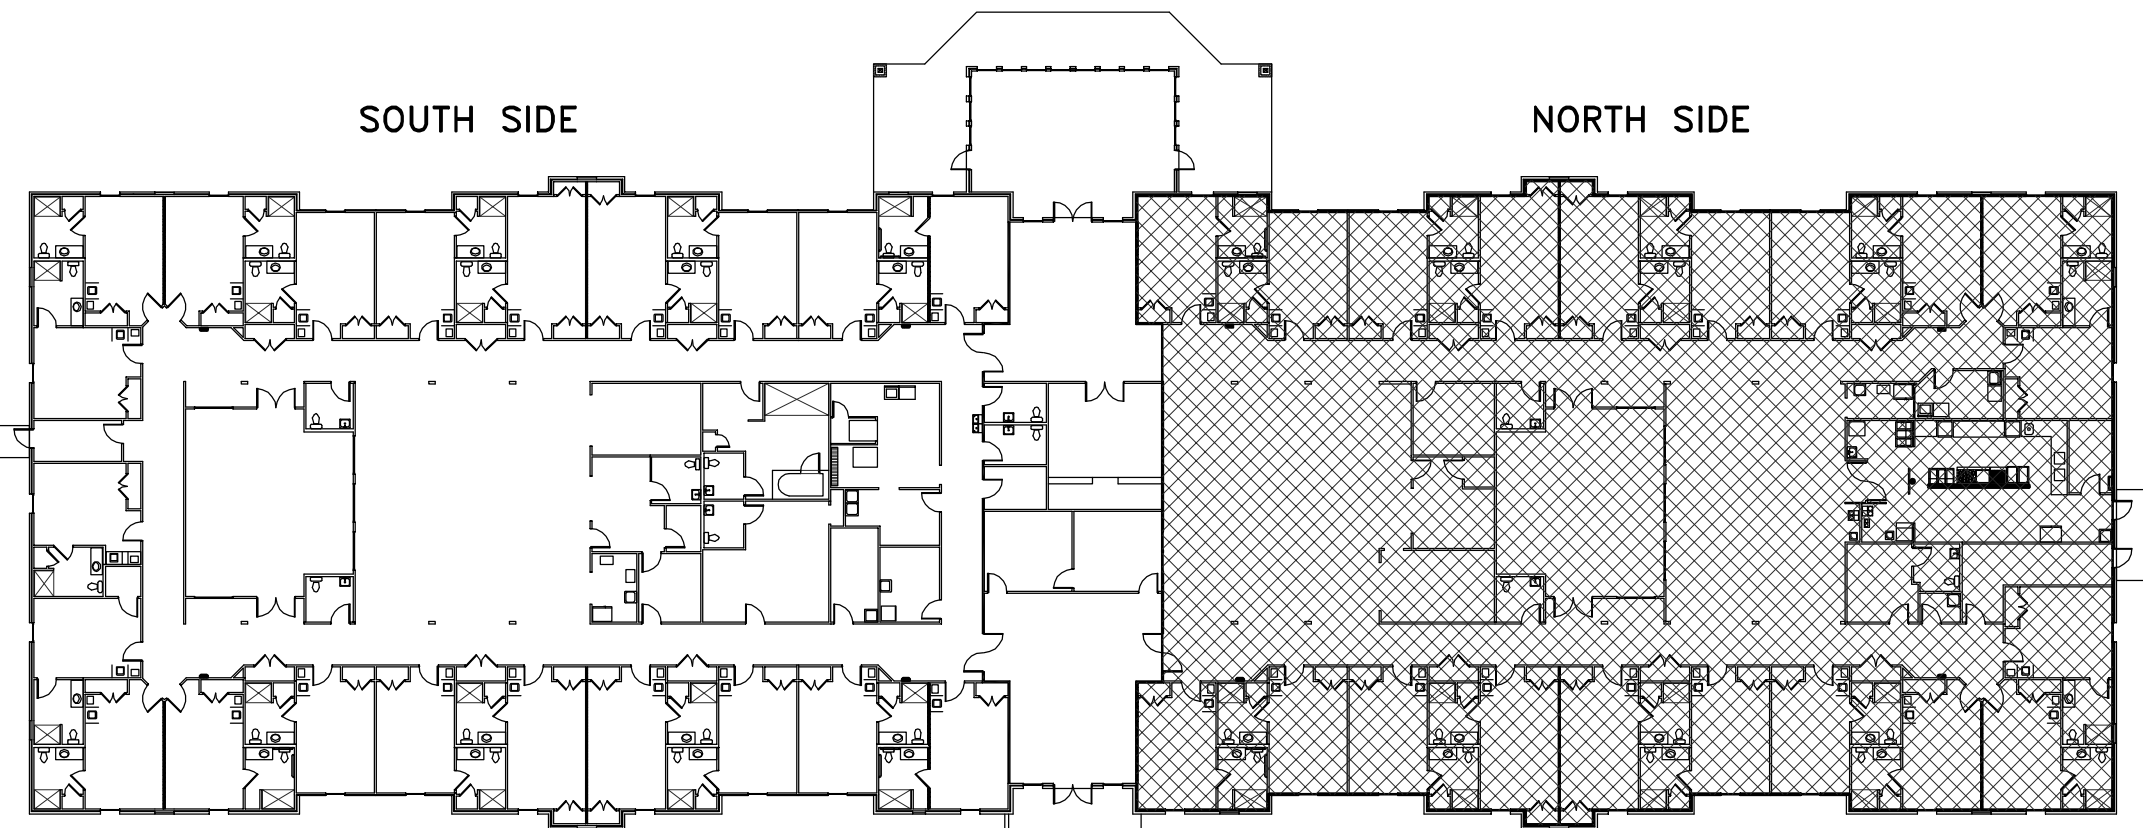

SHADED AREA INDICATES THE BUILDING AREA SHOWN ON THIS PLAN
2 KEY PLAN
SCALE: N.T.S.

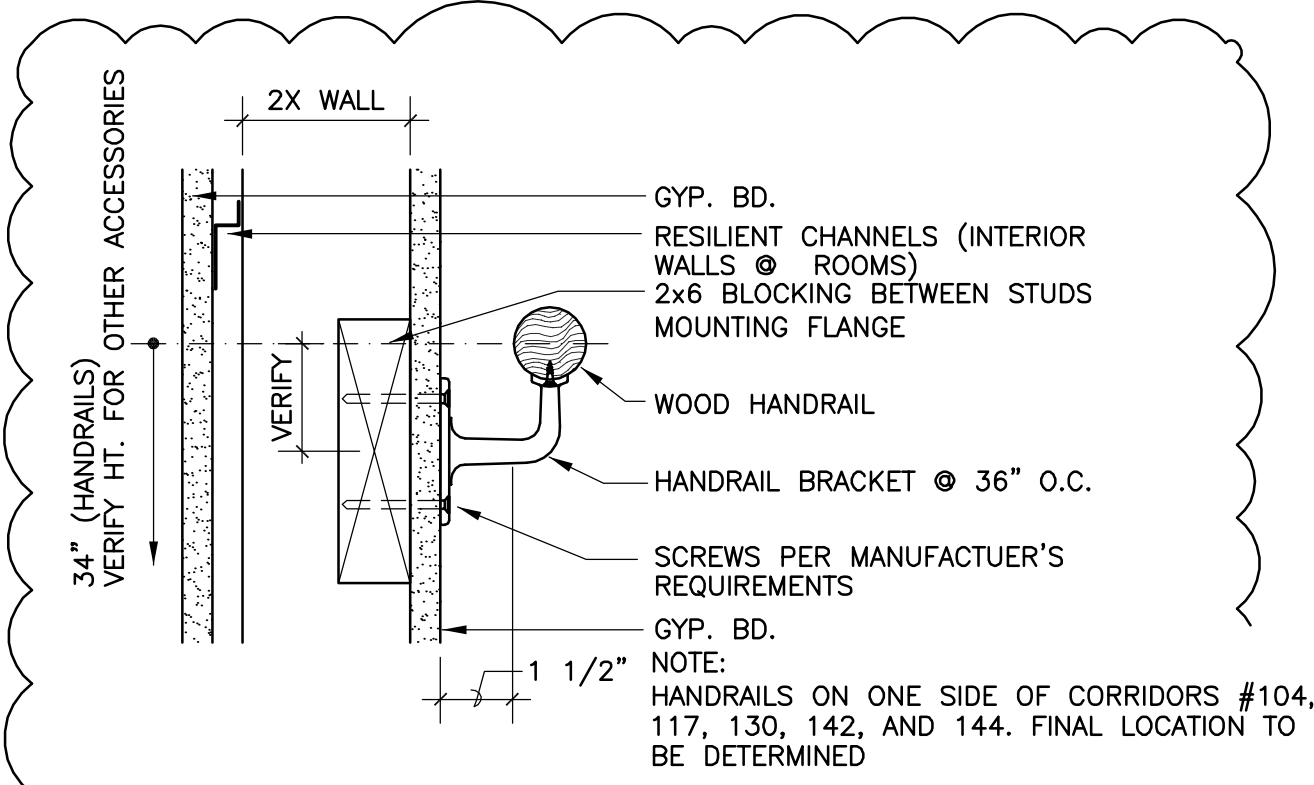

3 HANDRAIL DETAIL
SCALE: 3" = 1'-0"