


ANDERSON MEMORY CARE
AT SUMMERFIELD


4104 DAUPHINE STREET SLIDELL, LOUISIANA

DATE: 25 JUNE 2010
PROJECT: 10-181

PRELIMINARY
NOT FOR CONSTRUCTION

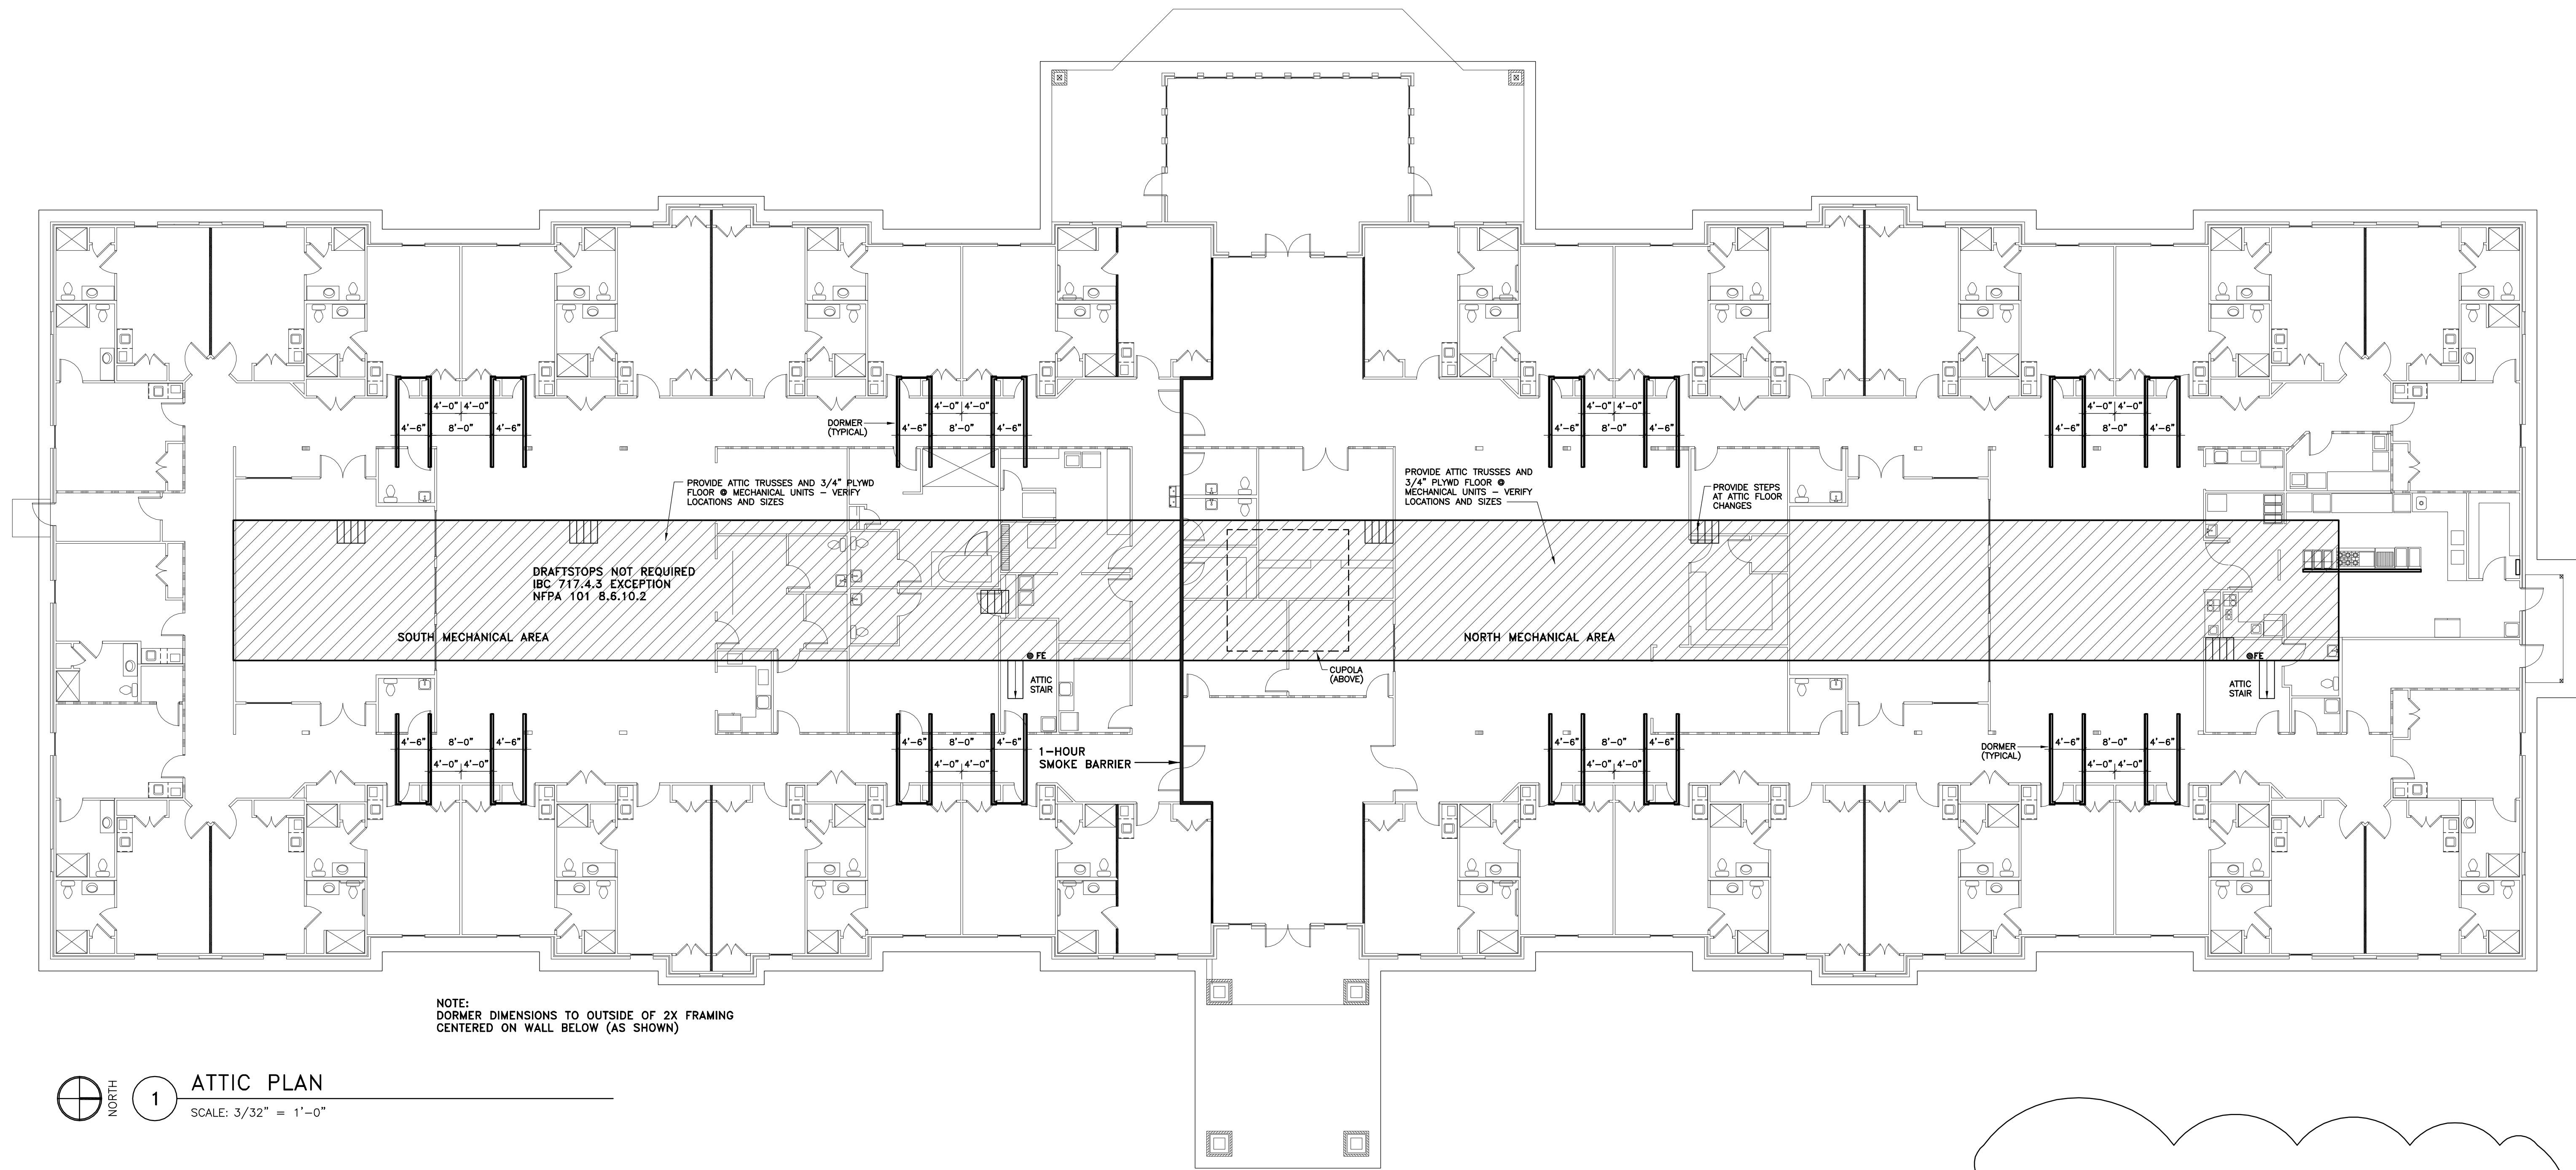

1 ATTIC PLAN
SCALE: 3/32" = 1'-0"

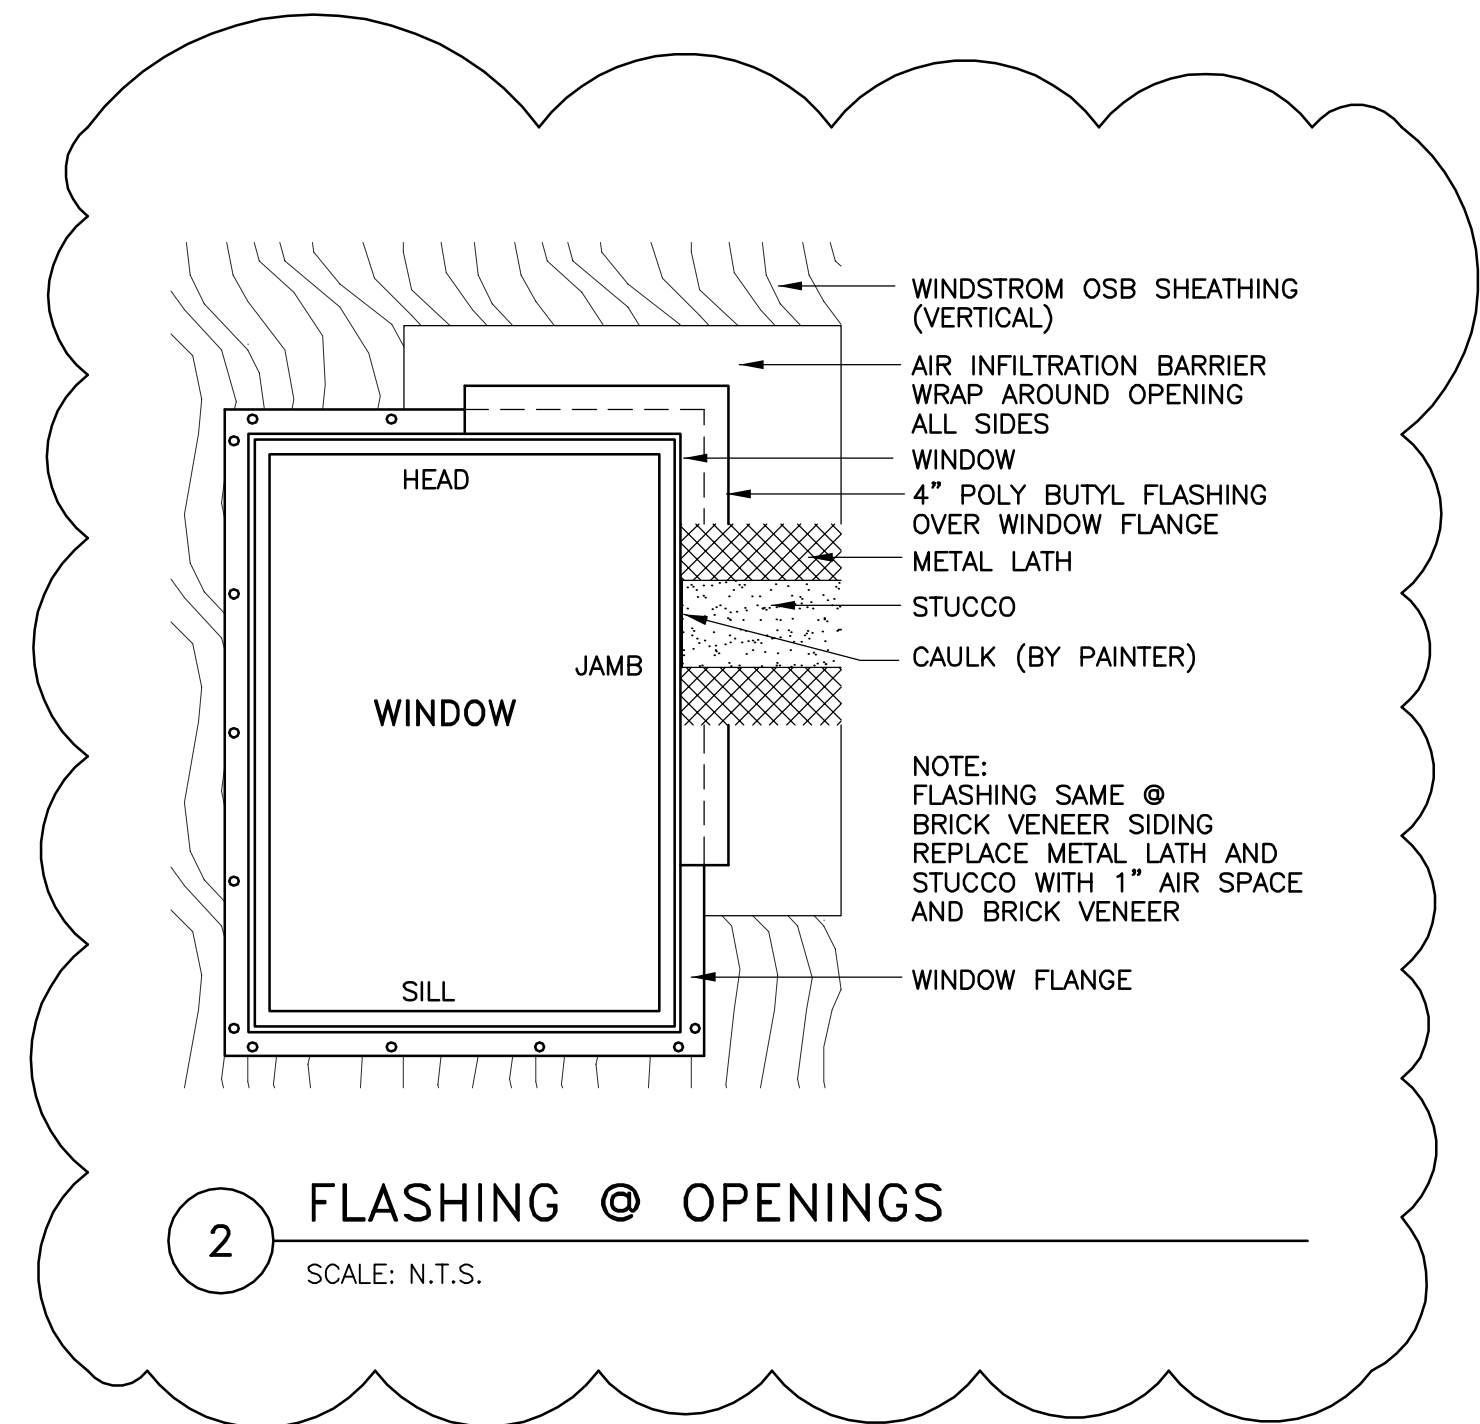

2 FLASHING @ OPENINGS
SCALE: N.T.S.