


EXISTING TWO  
STORY-WE ARE  
BUILDING BUT  
1ST FLOOR  
(CLOSEUP SEE  
DWG A1)

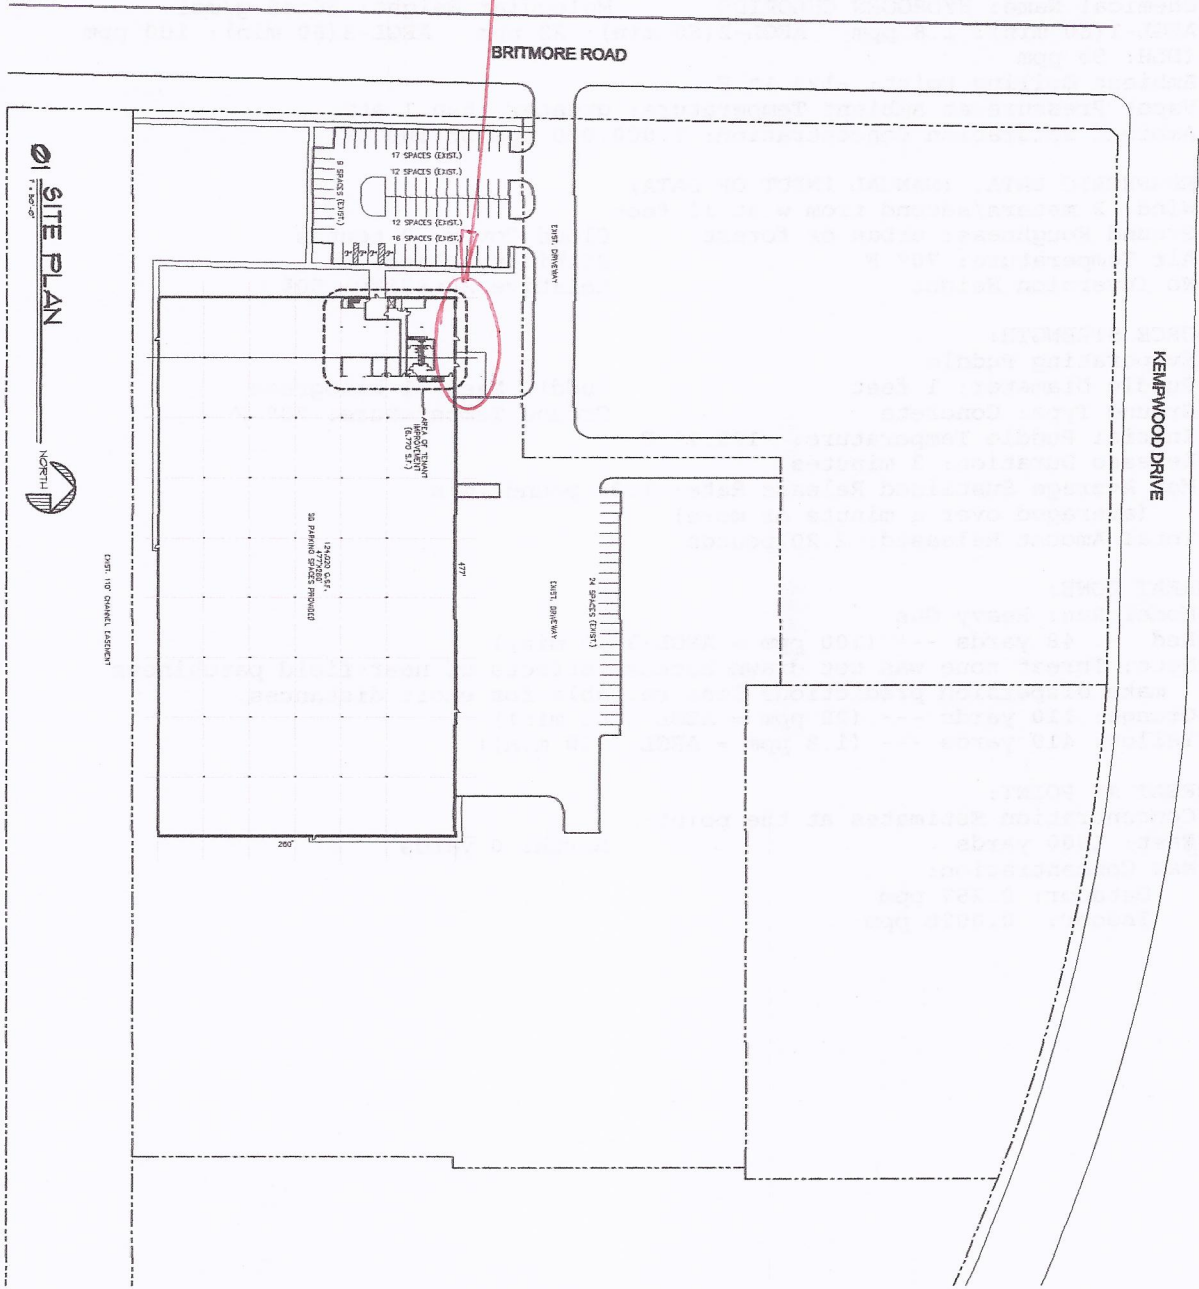

01 SITE PLAN  
NORTH


<b>SITE PLAN</b>  CONSTRUCTION DOCUMENTS  <b>A0</b> <small>PROJECT NO. 8011.02 REV. NO. 01 DATE 08.14.11 VARIOUS</small>	<b>OWENS &amp; MINOR</b> TENANT IMPROVEMENT  2700 BRITMORE RD. HOUSTON, TEXAS 77043  ISSUE FOR PERMIT	<table border="1"> <tr> <th>NO.</th> <th>DATE</th> <th>REVISION</th> </tr> <tr> <td>1</td> <td></td> <td></td> </tr> <tr> <td>2</td> <td></td> <td></td> </tr> <tr> <td>3</td> <td></td> <td></td> </tr> <tr> <td>4</td> <td></td> <td></td> </tr> <tr> <td>5</td> <td></td> <td></td> </tr> </table>	NO.	DATE	REVISION	1			2			3			4			5				
	NO.	DATE	REVISION																			
	1																					
2																						
3																						
4																						
5																						

CLOSEUP  
VIEW OF  
BUILDOUT  
SEE NEXT  
PAGE FOR  
PHOTOS +  
SECTIONS




**01 FLOOR PLAN**

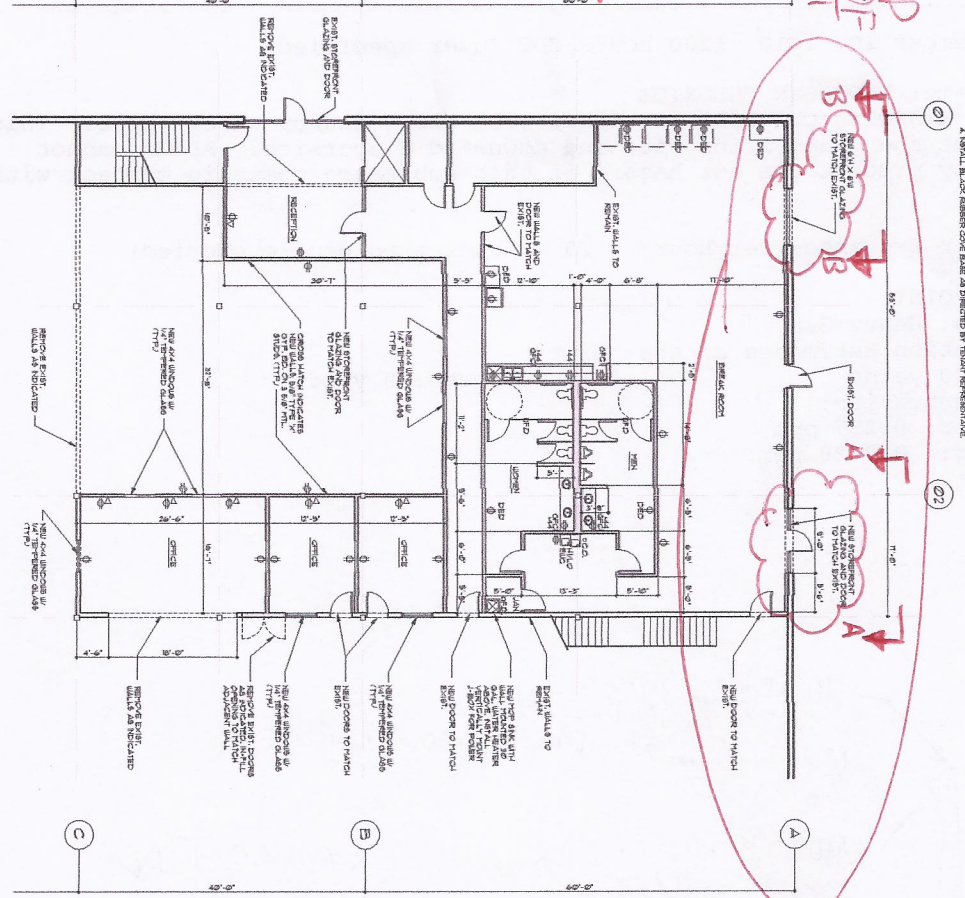

**02 REFLECTED CEILING PLAN**

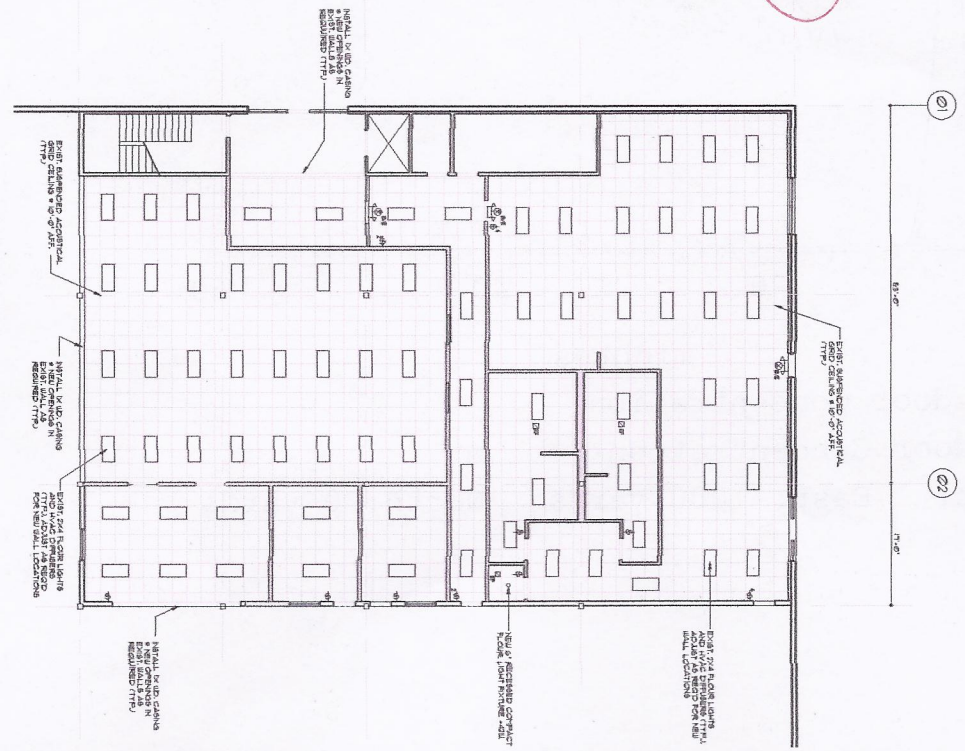

**FLOOR PLAN AND SCHEDULES**

**CONSTRUCTION DOCUMENTS**

**A1**

REVISION NO. 0011.02  
DATE 06.14.11  
BY [Signature]  
CHECKED [Signature]  
APPROVED [Signature]

**OWENS & MINOR**

**TENANT IMPROVEMENT**

2700 BRITMORE RD.  
HOUSTON, TEXAS 77043

**ISSUE FOR PERMIT**

NO.	REVISION
1	ISSUE FOR PERMIT

**SEAL**

Professional Engineer  
State of Texas  
[Signature]  
06/14/11


**OWENS & MINOR**

2700 BRITMORE RD.  
HOUSTON, TEXAS 77043



8/2/11  
11-106B O+M  
BUILDOUT

Page 1 of 2

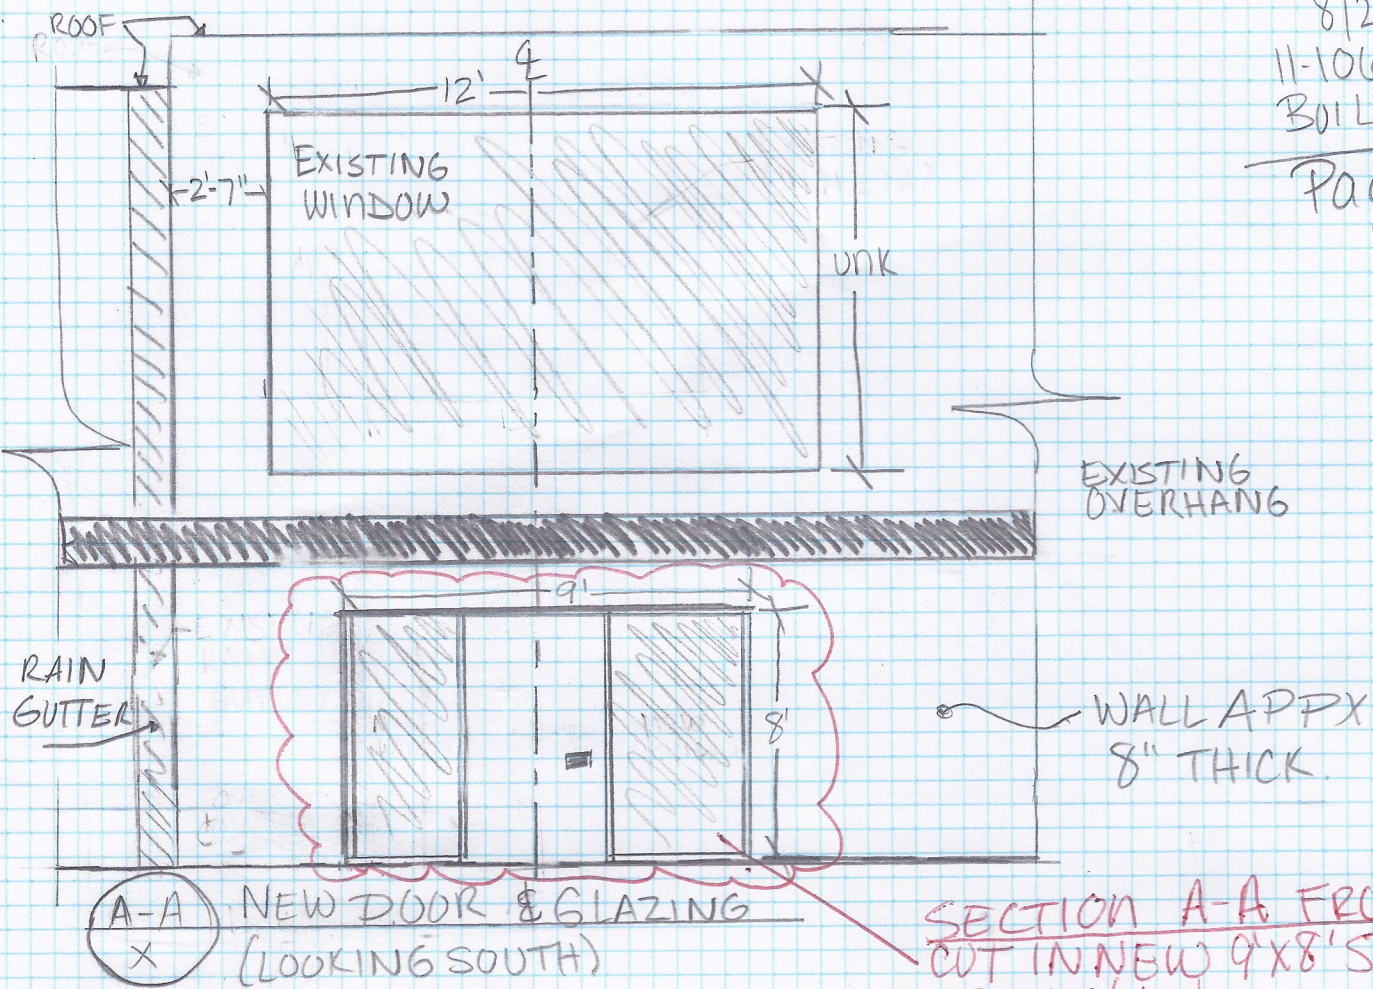


X ATTACHED PICTURES:  
• IMAG058 - IMAG064

QUESTION: Can you help us determine if wall is strong enough and/or how we should support it. If you can help can you give me a price and timing?

Address: 2700 Brittmoore Rd  
Houston, TX 77043  
(Beltway + I-10)



8/2/11  
11-1063 CH  
BUILDOUT  
PAGE 2 of 2

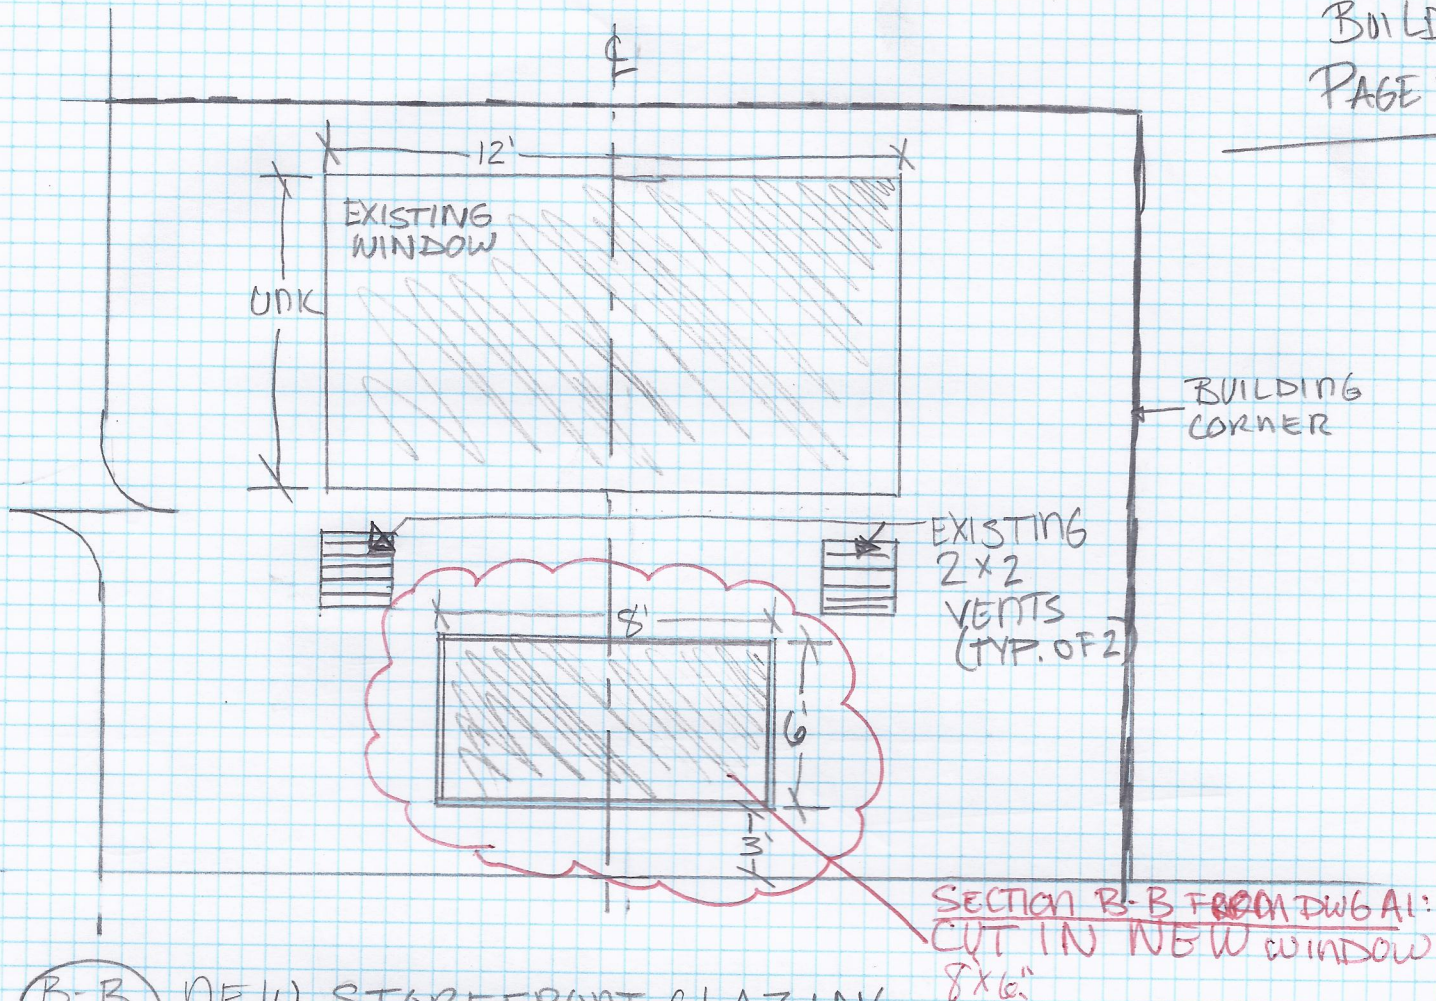

(B-B) NEW STOREFRONT GLAZING  
(LOOKING SOUTH)

\*Attached Pictures:

IMAG065, IMAG066