


Covering Schedule
Id Qty Type Start Length Gage OP Fin. Color Direction
#33 15 PR 22'-3 3/4" 26 1 K AG Left to Right
Oper. Code:1=SQ,SQ
Finish:K=KXL
Color:AG=Ash Gray

Trim Schedule
Id Parts
T1 (3)HT12,HT10
T2 (2)CT12

Color Details
Match Wall Color
Match Wall Color WC20A1

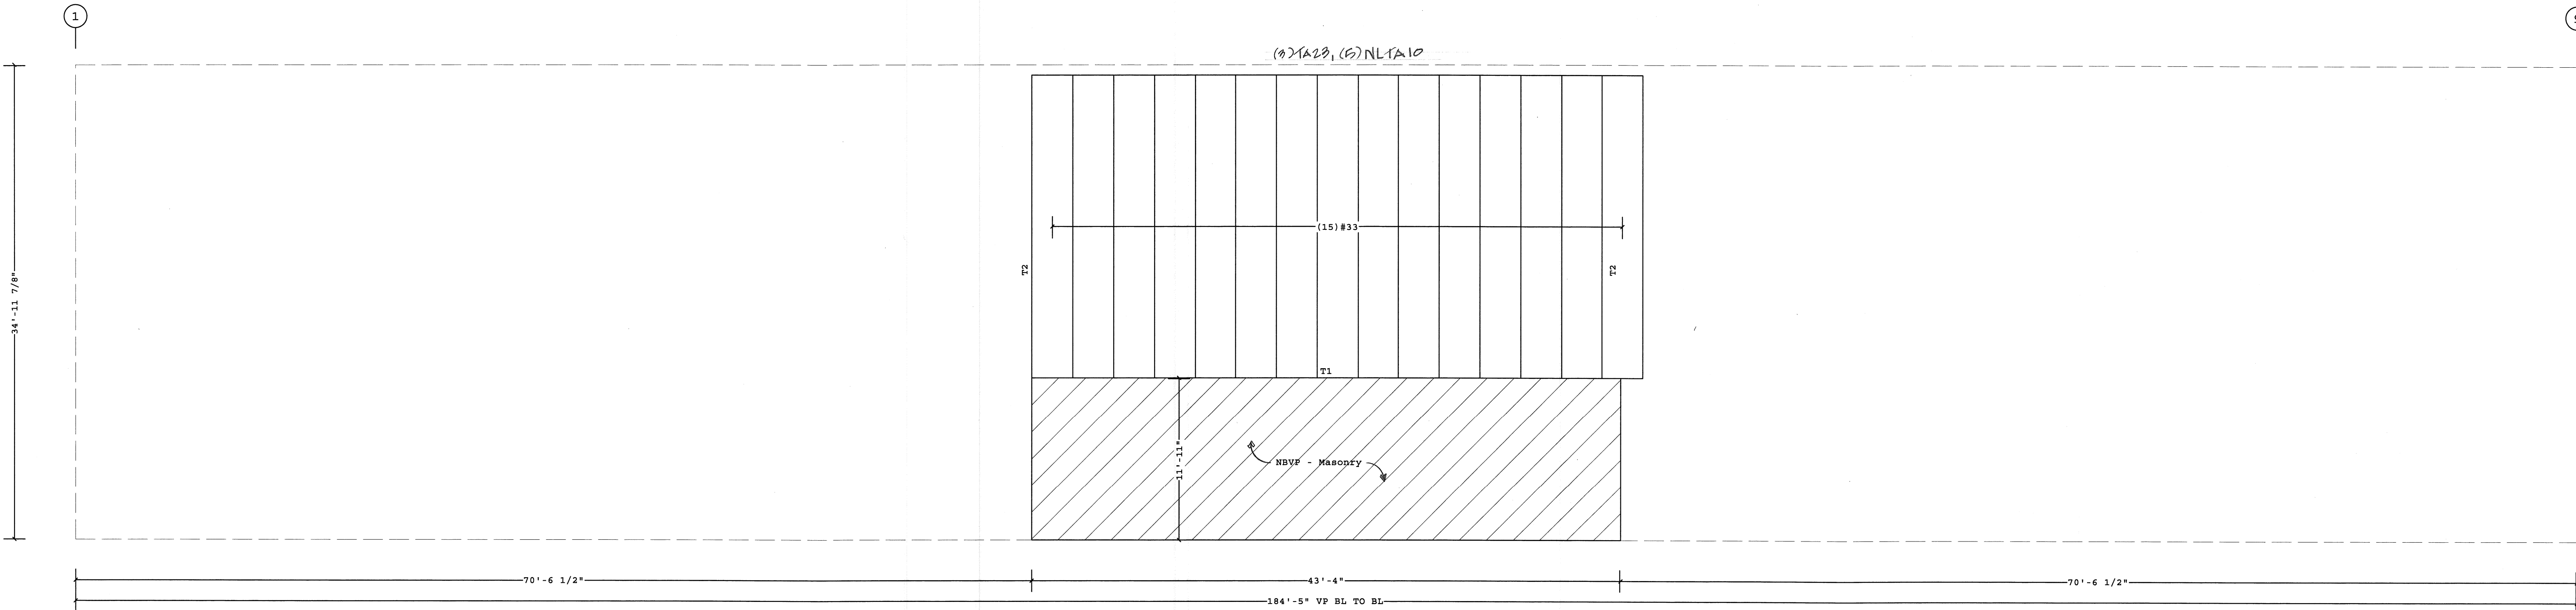


COVERING ELEVATION AT PARTITION OR MISC. 2

Shape Name = Shop & Parts Room, Wall = 2

FOR CONSTRUCTION

| | | | | | | | | | | | |
|---|---|---|---|--|--|------------------|----|-------------|-------------------------|----------------|--|
| 1. PRE-DRILLING 1/8 DIAMETER HOLES FOR WALL STRUCTURAL FASTENERS MAY BE REQUIRED AT 11 GAGE GIRTS, NESTED GIRTS, GIRT LAP LOCATIONS, AND/OR SECONDARY STRUCTURAL BEAMS 2. WALL SHEETS ARE AN INTEGRAL PART OF THE STRUCTURAL SYSTEM, REMOVAL OR ALTERATION WITHOUT PRIOR AUTHORIZATION IS PROHIBITED. 3. PANELS SHOWN WITH A LENGTH LESS THAN 1-0, 5-0 FOR SSR, MAY HAVE TO BE FIELD CUT. 4. SEE JOB DETAILS FOR SHEETING AND TRIM FASTENER SPECIFICATION. | THE VP ENGINEER'S SEAL APPLIES ONLY TO THE WORK PRODUCT OF VP AND DESIGN AND PERFORMANCE REQUIREMENTS SPECIFIED BY VP. THE VP ENGINEER'S SEAL DOES NOT APPLY TO THE PERFORMANCE OR DESIGN OF ANY OTHER PRODUCT OR COMPONENT FURNISHED BY VP EXCEPT TO ANY DESIGN OR PERFORMANCE REQUIREMENTS SPECIFIED BY VP. | THIS DRAWING, INCLUDING THE INFORMATION HEREON, REMAINS THE PROPERTY OF VP BUILDINGS. IT IS PROVIDED SOLELY FOR ERECTING THE BUILDING DESCRIBED IN THE APPLICABLE PURCHASE ORDER AND SHALL NOT BE MODIFIED, REPRODUCED OR USED FOR ANY OTHER PURPOSE WITHOUT PRIOR WRITTEN APPROVAL OF VP BUILDINGS. THE GENERAL CONTRACTOR AND/OR ERECTOR IS SOLELY RESPONSIBLE FOR ACCURATE, GOOD QUALITY WORKMANSHIP IN ERECTING THIS BUILDING IN CONFORMANCE WITH THIS DRAWING, DETAILS REFERENCED IN THIS DRAWING, ALL APPLICABLE VP ERECTION GUIDES, AND INDUSTRY STANDARDS PERTAINING TO PROPER ERECTION, INCLUDING THE CORRECT USE OF TEMPORARY BRACING. | VP Buildings | | COVERING ELEVATION AT PARTITION OR MISC. 2 | | | | | | |
| | | | 3200 Players Club Circle Memphis TN 38125 | | REV | DATE | BY | DESCRIPTION | BUILDER | Broadmoor, LLC | |
| | | | NTS | | | | | CUSTOMER | Naval Air Station JRB | | |
| | | | | | | | | LOCATION | Belle Chasse, Louisiana | | |
| | | | | | | | | PROJECT | F-15 CIRF Upgrade | | |
| | | | | | | | | | BUILDERS POW | | |
| | | | | | | | | | NTS | | |
| | | | | | | | | | 7:37:37 | | |
| | | | | | | 10/16/2009 | | | | | |
| | | | | | | 09-12315 EP1.VPC | | | | | |
| | | | | | | | | | | | |

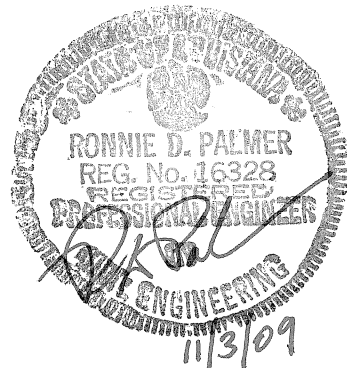

JOBNO
09-12315 EP1
DATE
15 OCT 09
DRAWN/CHECK
PCD
PAGE
35 of 50