



SECTION  
B  
SCALE: 1/8" = 1'-0"  
S5 S6

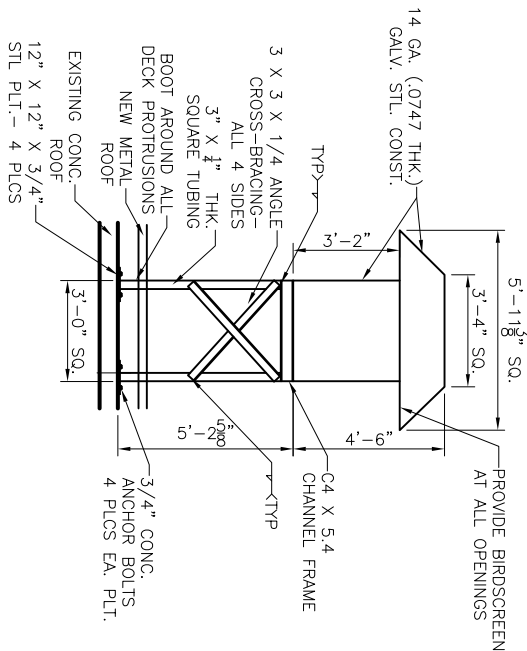

FRESH AIR INTAKE DUCT DETAIL  
SCALE: 3/8" = 1'-0"

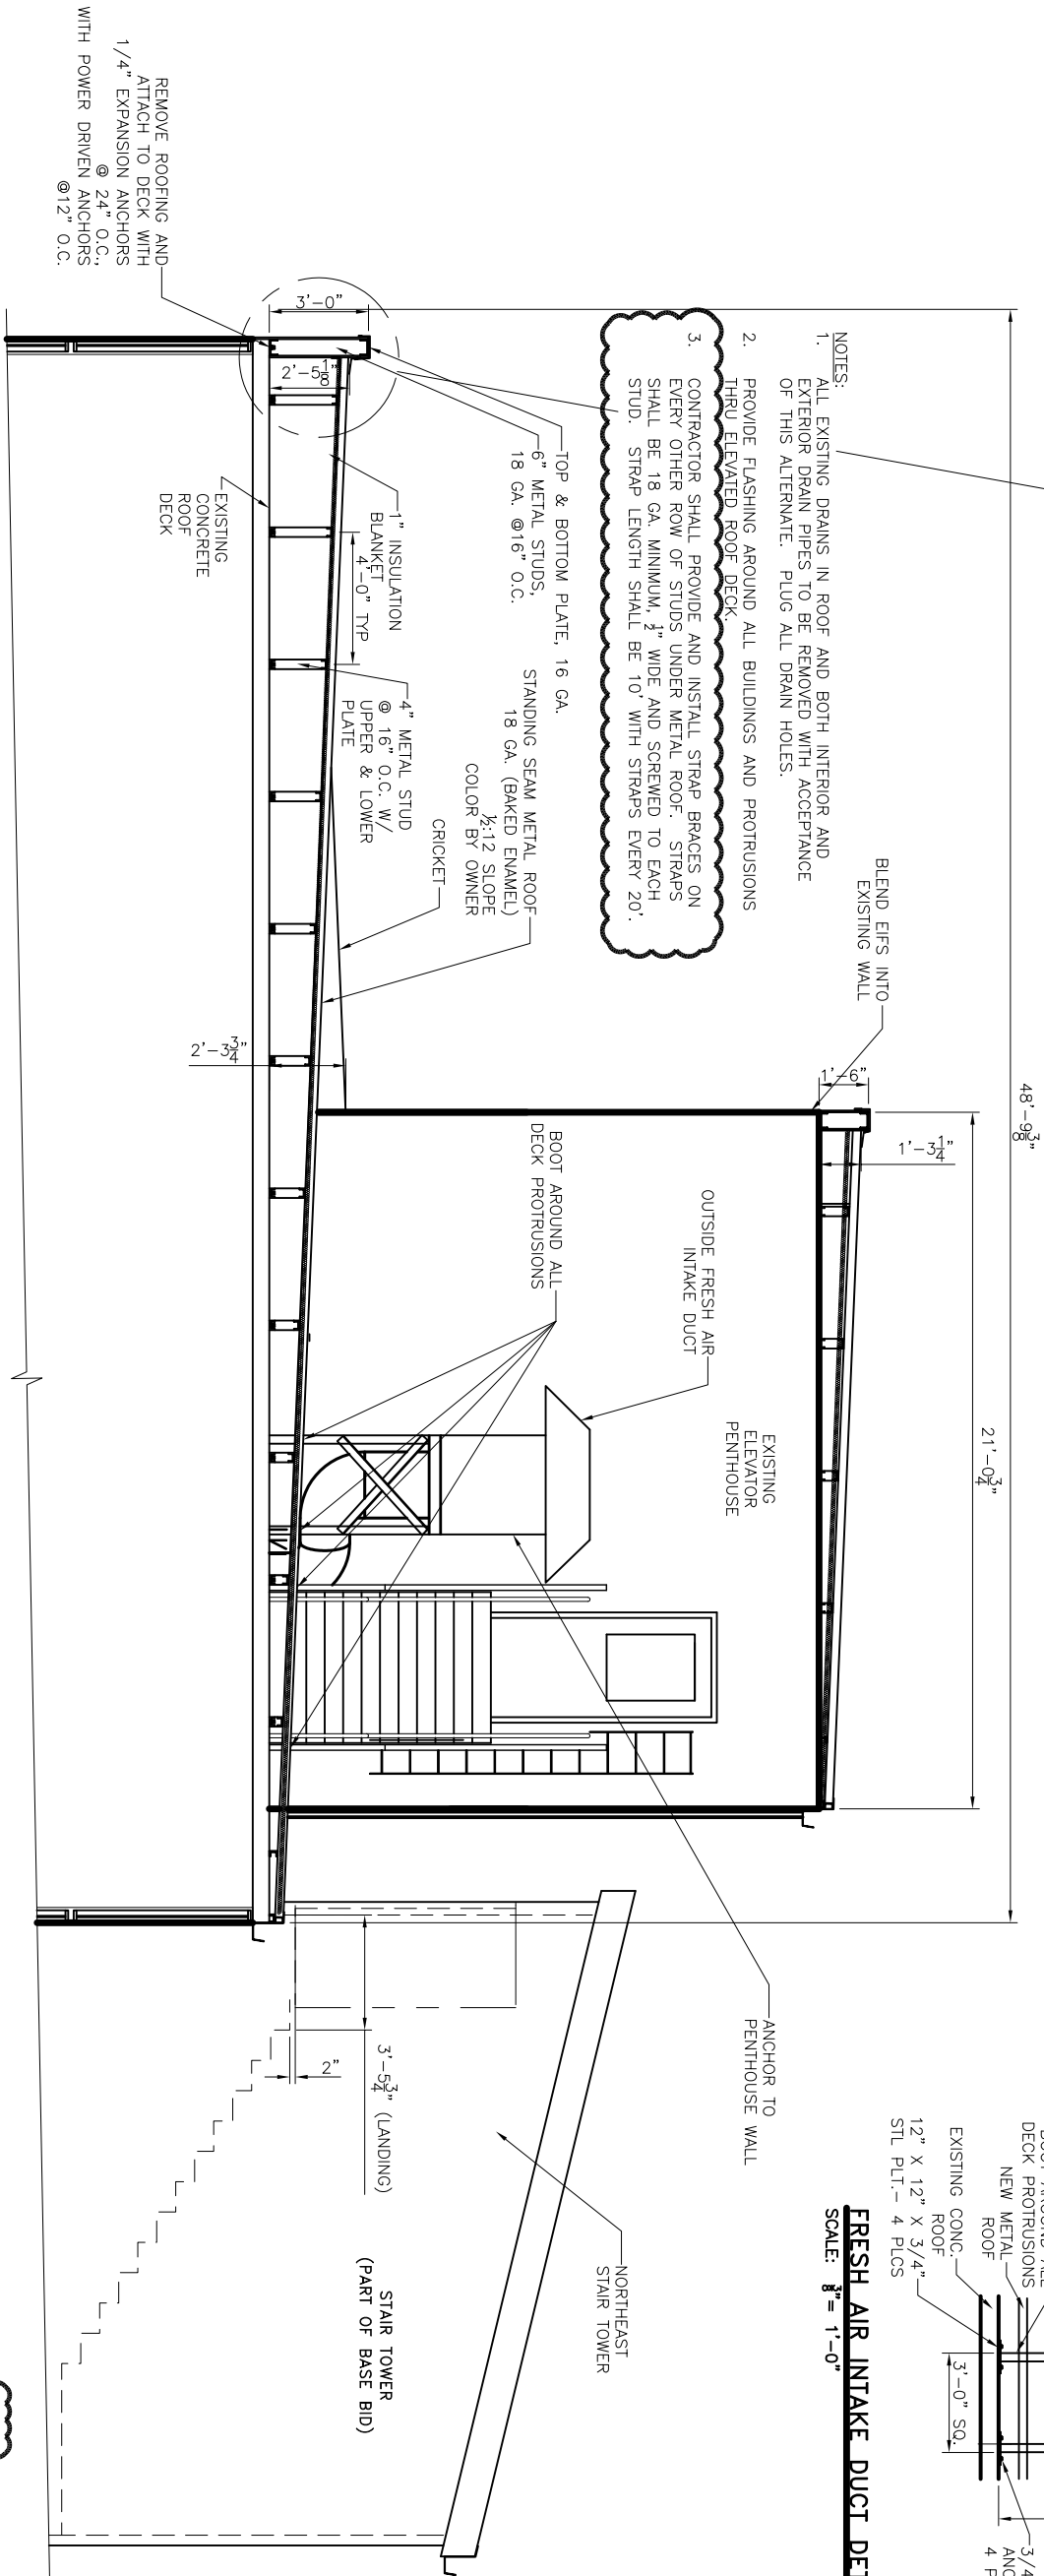

ROOF DETAIL  
A  
SCALE: 3/8" = 1'-0"  
S5 S6

CLOUD = ADDENDUM 7 CHANGE