

DAMMON
ENGINEERING, INC.
EMMETT
DAMMON

ARCHITECT
ROBERT
WILTSE

1095 FLORIDA AVENUE
SLIDELL, LA. 70458
985-649-5832

WEBSITE:
WWW.DAMMONENGINEERING.COM

EMAIL:
DAMMONENG@BELLSOUTH.NET

ARCHITECTURE

ENGINEERING

STUDIES

PLANNING

INVESTIGATION

EXPERT WITNESS

CENTURY PARK
UNIVERSITY OF
SOUTHERN
MISSISSIPPI

IDN-ACME INC.

1504 JUSTIN RD.

METAIRIE, LA 70001

CENTURY PARK
CAMERA SITE PLAN

REV: #1 10/30/09

SCALE: AS NOTED


JOB#: 2028

DATE: 6-29-2009

SHEET: 2

SEC-0-1

OF: 8

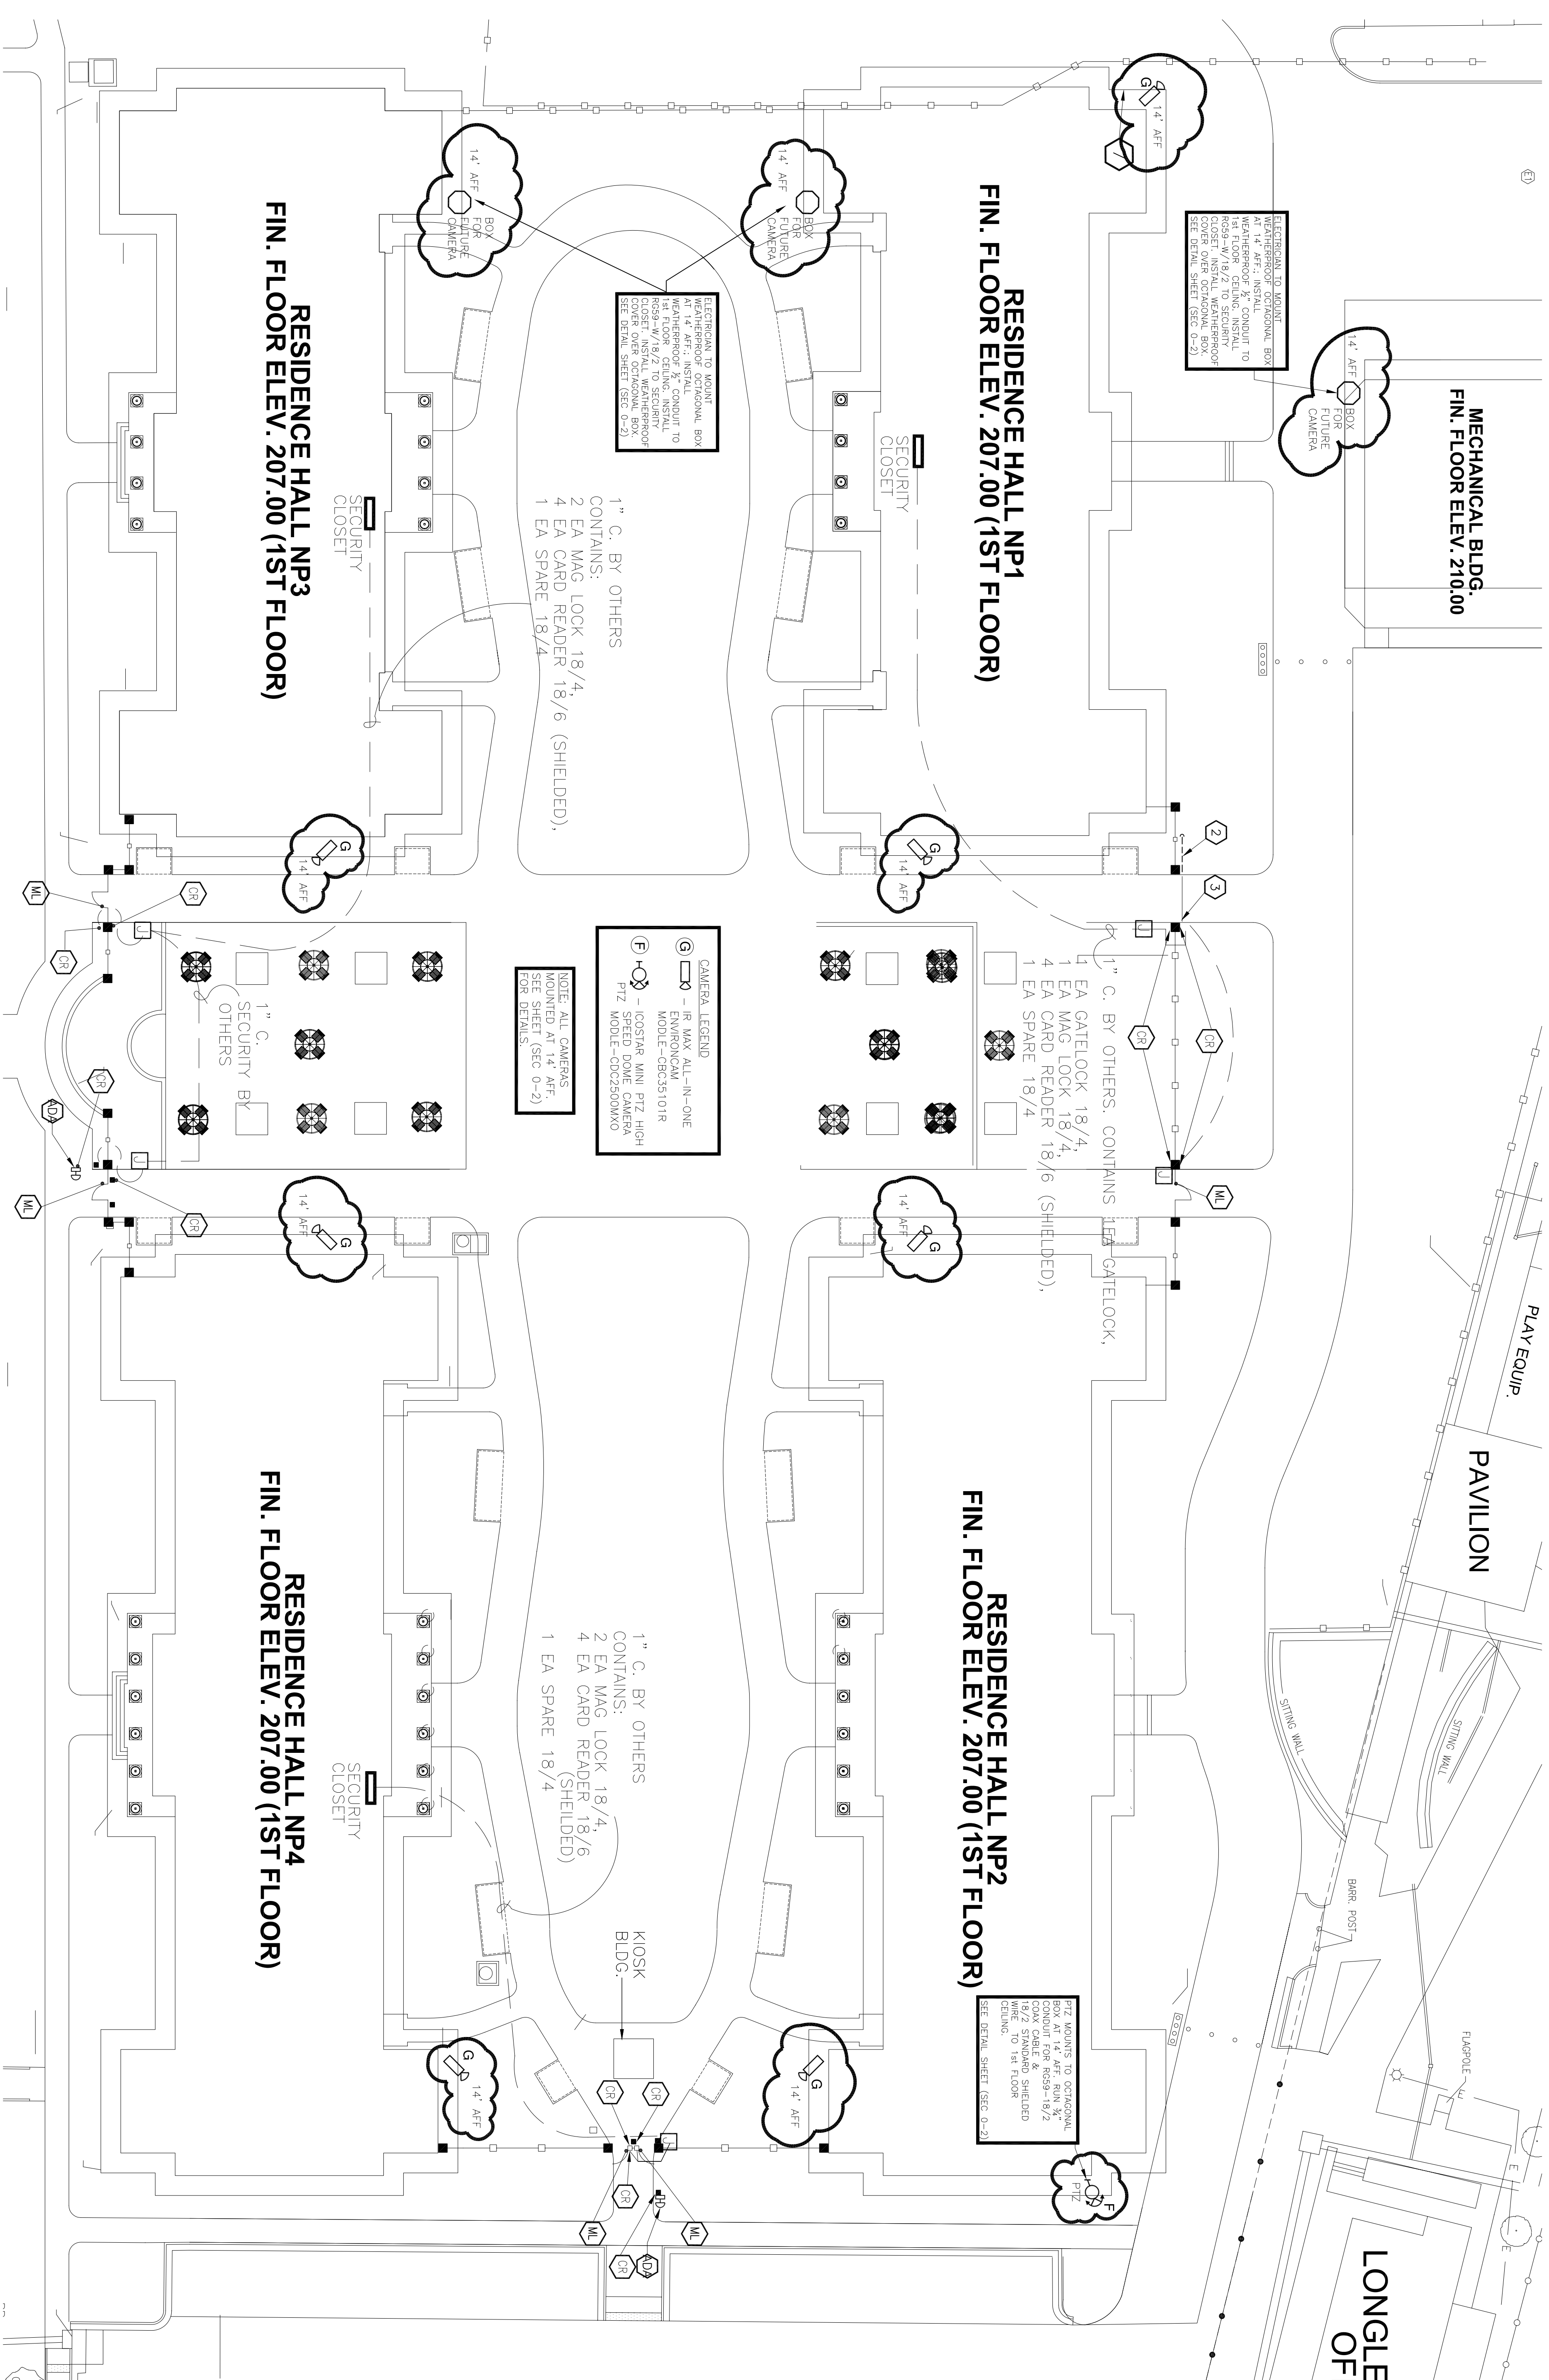

GENERAL NOTES

1. A 1" CONDUIT UNDERGROUND IS PROVIDED FROM EACH GATE LOCATION TO A SECURITY CLOSET BY OTHERS.
2. EACH GATE LOCATION IS TO BE SETUP READ-IN & READ-OUT.

SITE PLAN & CAMERA LAYOUT

SCALE: 1" = 20'-0"