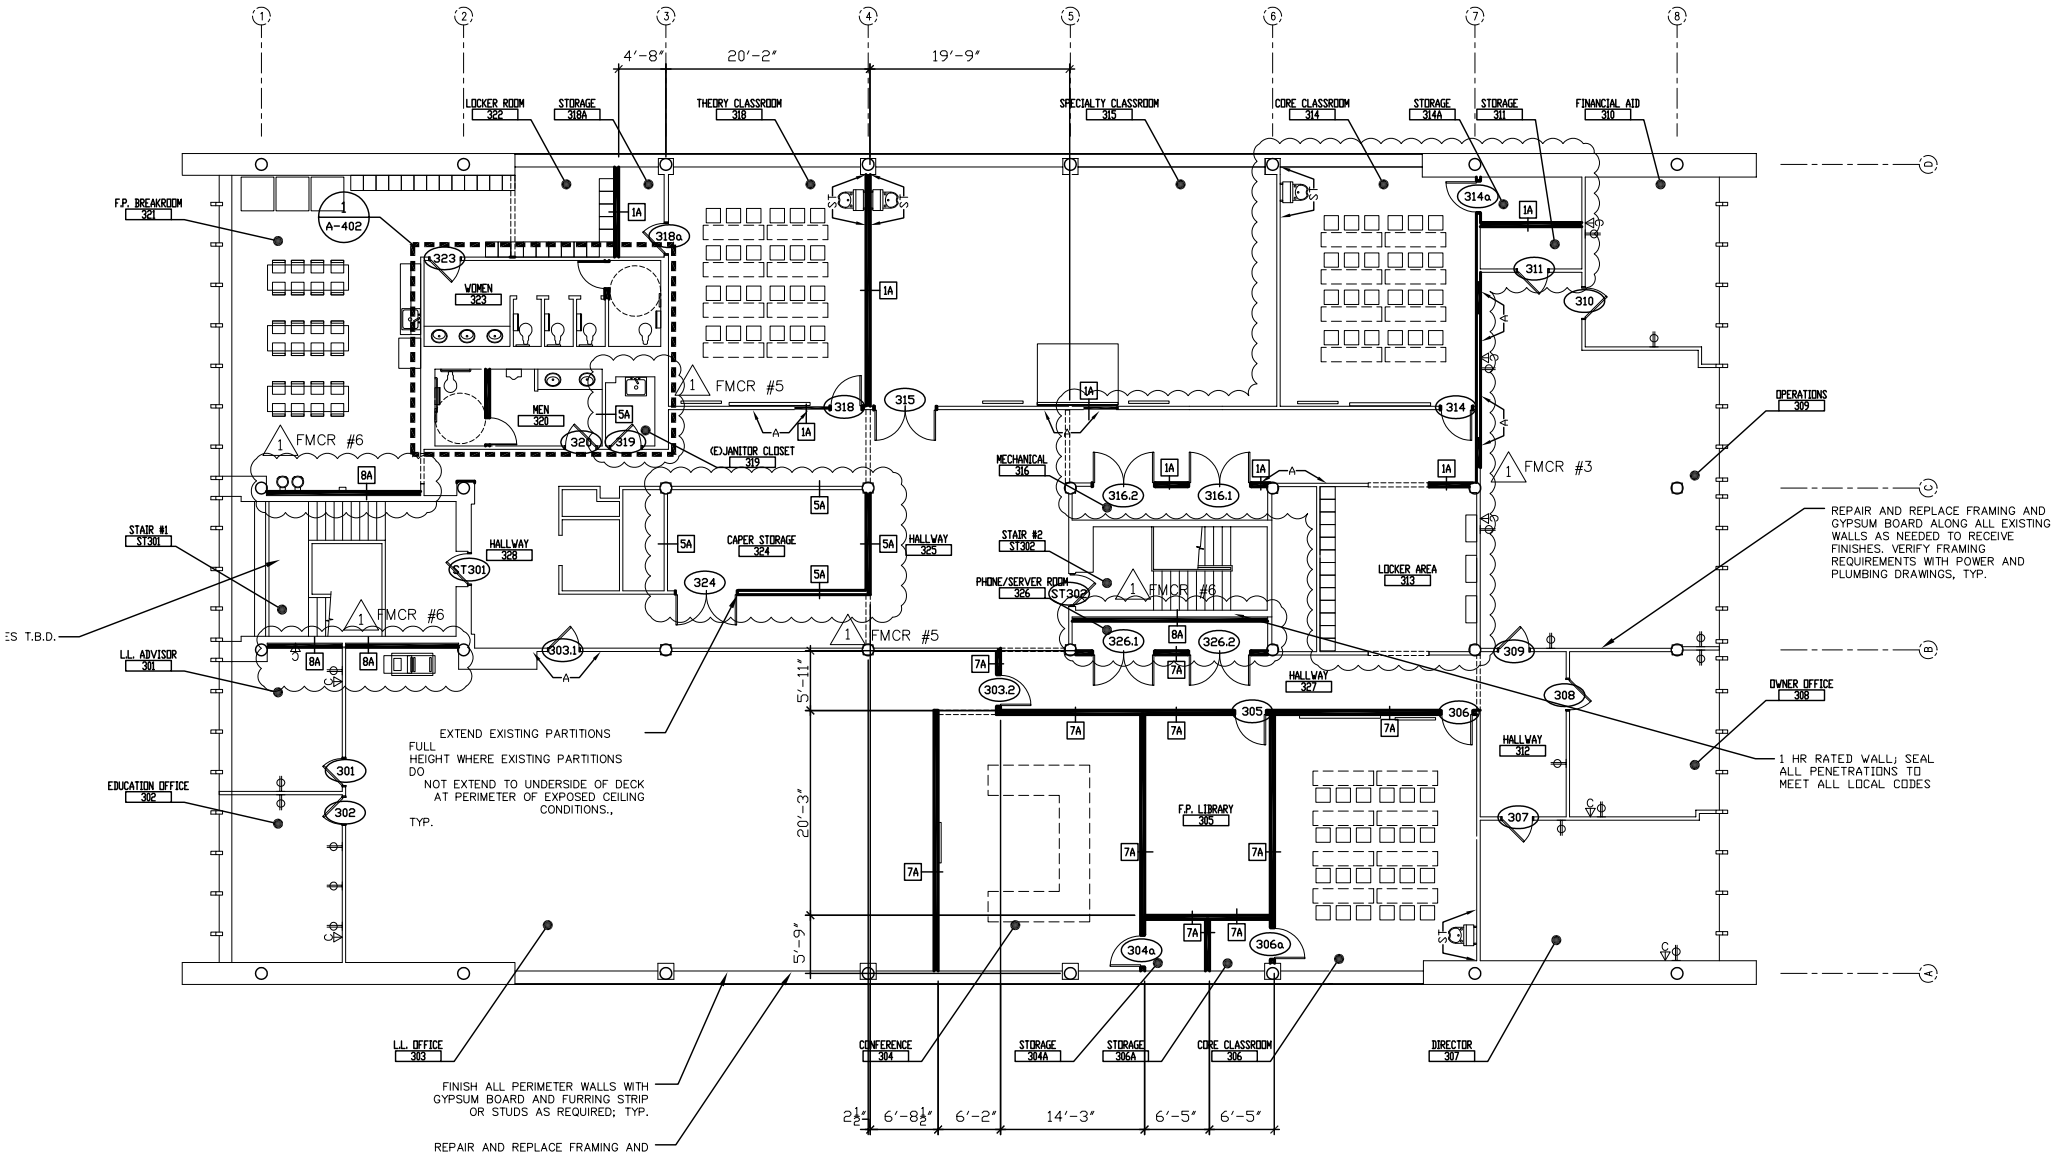

THIRD FLOOR PLAN

3 SCALE: 1/8"=1'-0"