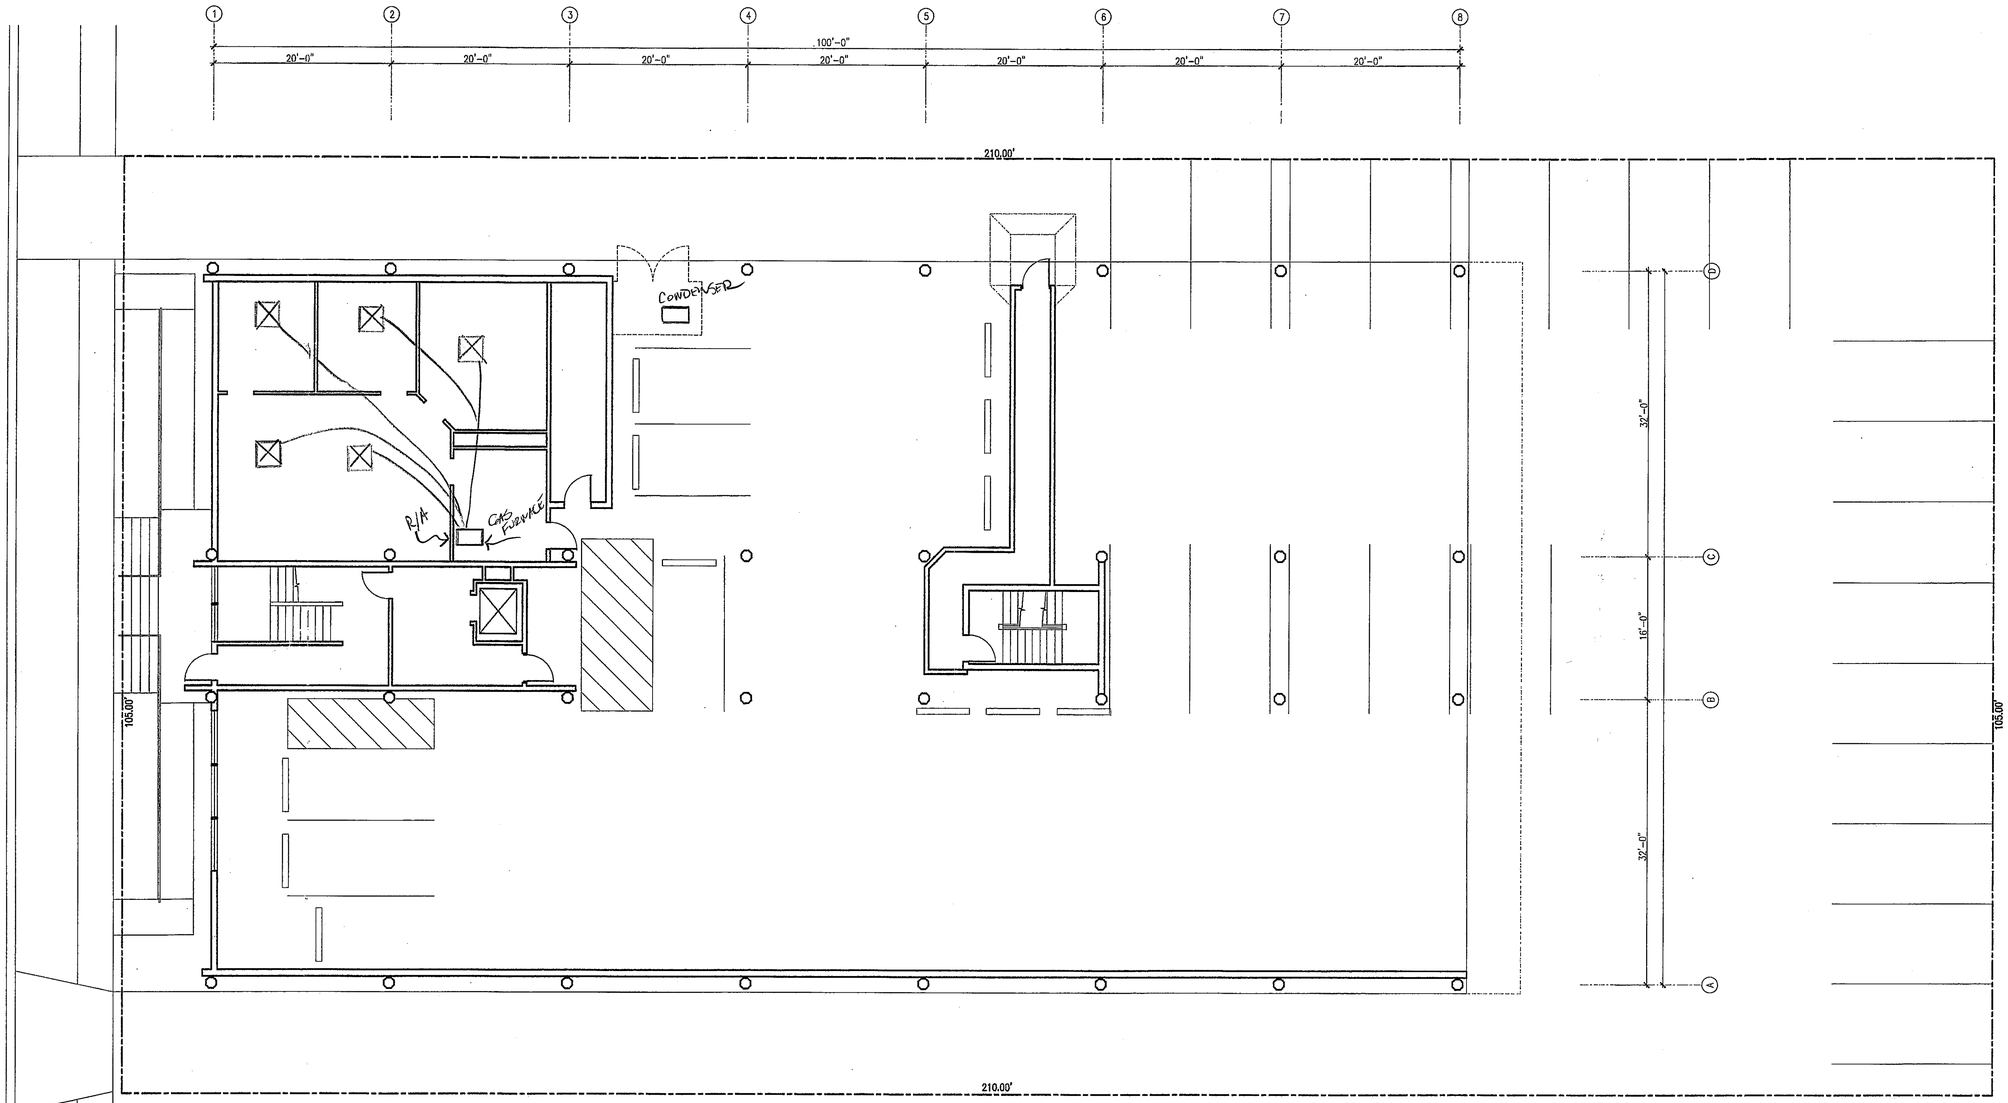

EXISTING FIRST FLOOR PLAN SQUARE FOOTAGE: 2288 S.F.

SCALE: 1/8" = 1'-0"

TERRELL FABACHER ARCHITECTS, L.L.C.
1525 ST. CHARLES AVE., Ste 300
NEW ORLEANS, LOUISIANA, 70125
504-568-1320 TEL
504-568-1350 FAX

These plans and specifications have been prepared by me or under my close supervision and they comply with all city requirements to the best of my knowledge and belief.

The project (will)(will not) be visited periodically to review job progress

EXISTING CONDITIONS
3321 HESSMER AVE.
METAIRIE, LOUISIANA

NO.	REVISIONS

CHECKED BY:

DRAWN BY: TIM T

DATE: 9-8-09

JOB NO.:

EX1

SHEET OF