


ATTN: MIKE R

From: MARIK
P

649-7679

001

EDUCATIONAL APP. SITE

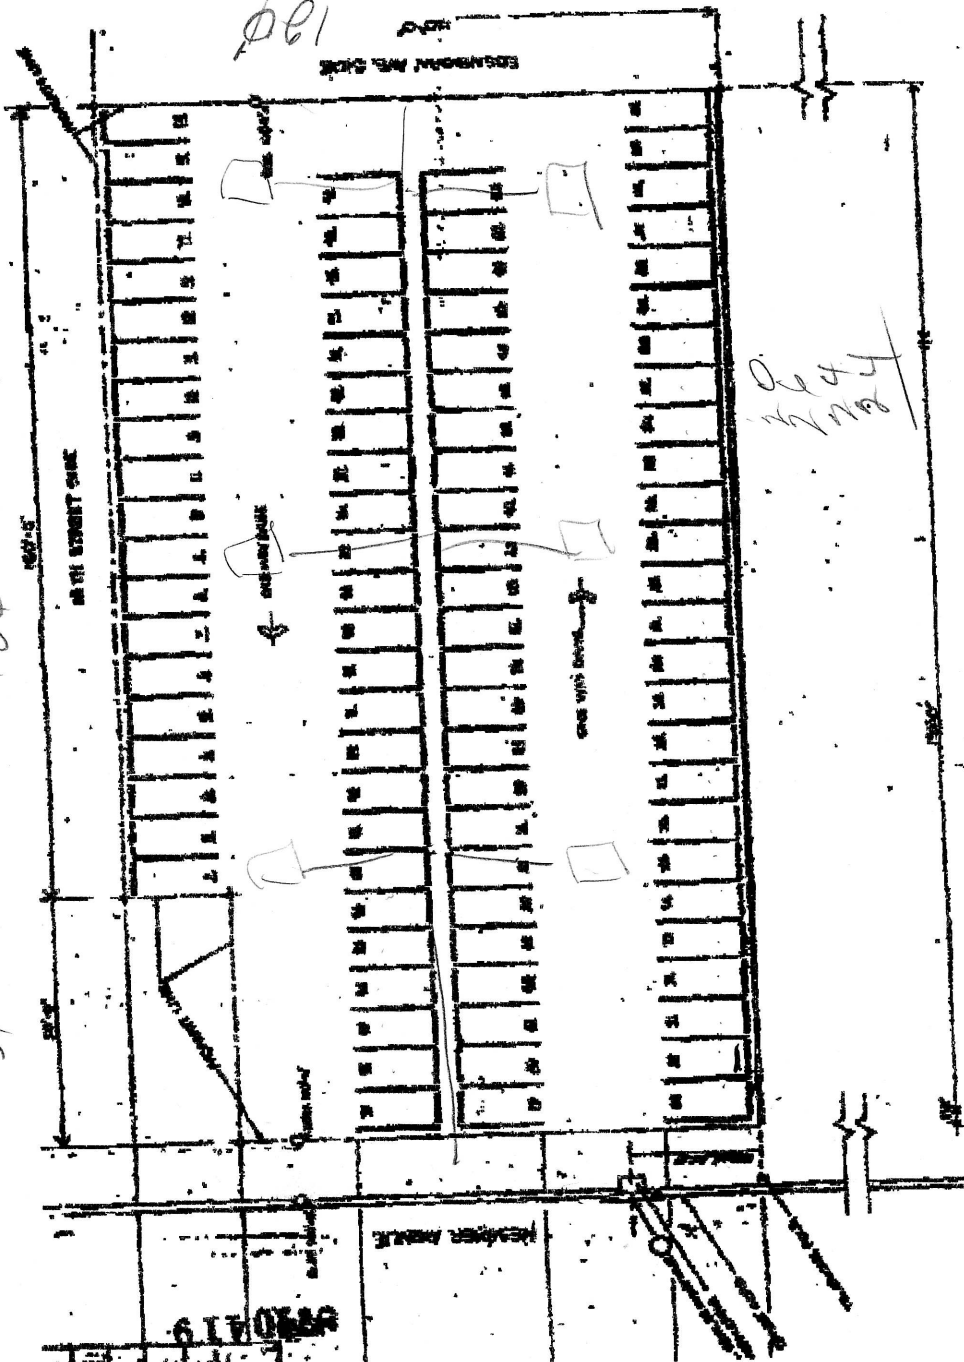

PLANNING - STUDY

THE UNIVERSITY OF

THE UNIVERSITY OF

91, 442

160

30

LOT ACROSS BUDG-
6750 S. 1st
LOT 1

94 340 LF Drainage
+ 27 0 catch basins
6/16/99 11' x 14' 0"