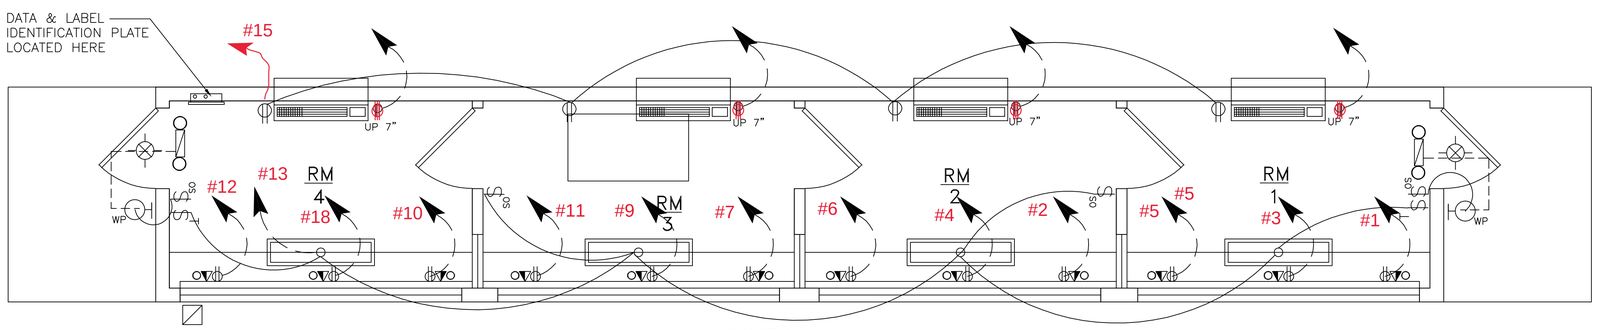

ELECTRICAL PLAN

DAMMON ENGINEERING, INC.
LOUISIANA & MISSISSIPPI
Chief Engineer: Brian Mistich, PE
554 Old Spanish Trail
Slidell, LA 70458
www.dammonengineering.com
info@dammonengineering.com
PH: 985.649.5832

#	DESCRIPTION	DATE

REVISIONS

SEAL:

NEW PRESS BOX
SALMEN HIGH SCHOOL
300 SPARTAN DRIVE
SLIDELL, LA. 70458

JOB No:	
DATE:	04-14-2022
DRAWN BY:	CKD
CHECKED BY:	CKD

The design, drawings and specifications, including but not limited to electronic media versions, which are and shall remain the property of Dammon Engineering, are prepared for the intended use by the client for the specific project for which the work was prepared and developed without written consent of Dammon Engineering. Any other use or reproduction without written consent of Dammon Engineering is prohibited.

SHEET TITLE:

POWER AND LIGHTING PLAN

DRAWING NUMBER:

E101

SHEET No: of 1