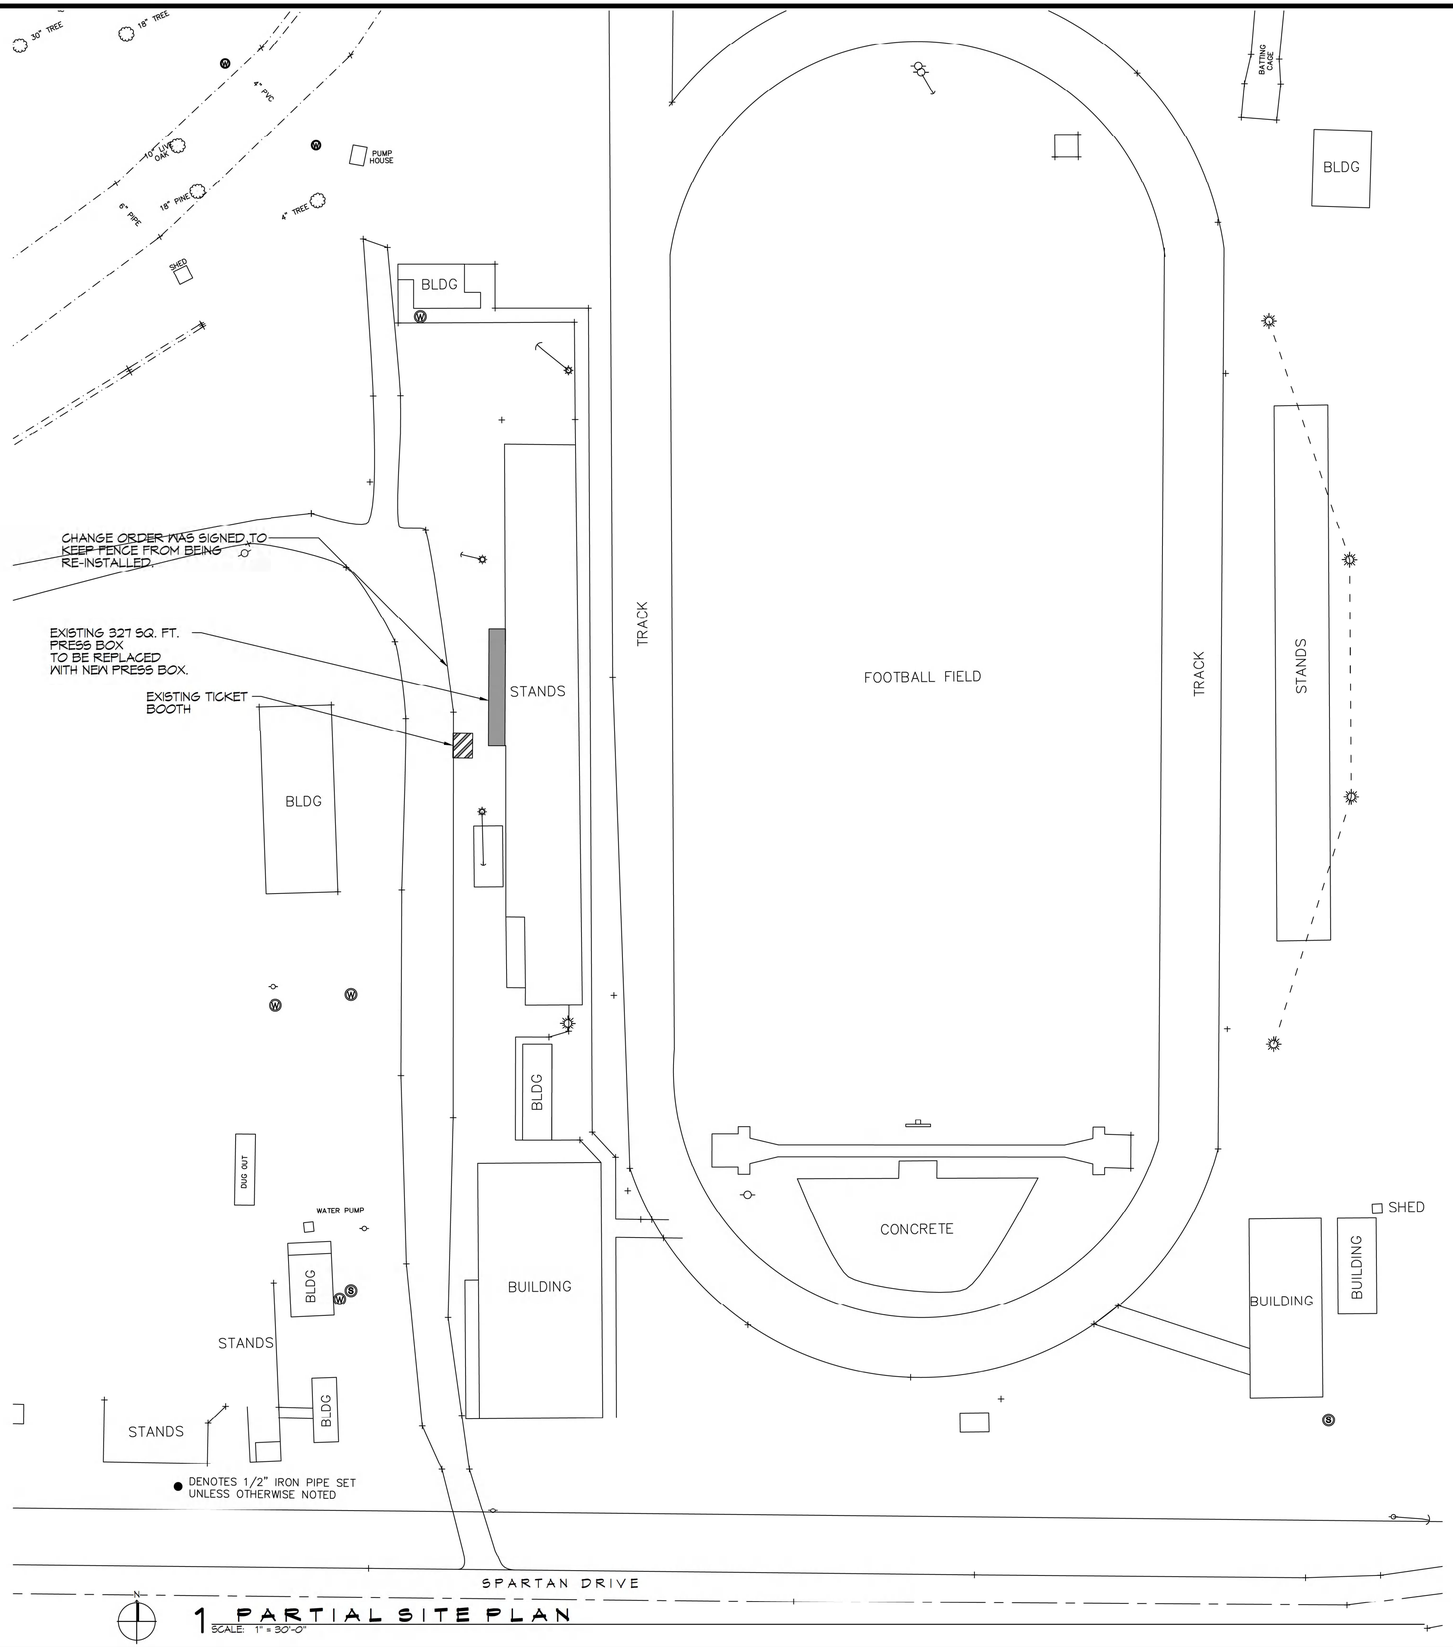

1 PARTIAL SITE PLAN
SCALE: 1" = 30'-0"

AS-BUILT

DAMMON ENGINEERING, INC.
LOUISIANA & MISSISSIPPI

Chief Engineer: Brian Mistich, PE
554 Old Spanish Trail
Slidell, LA 70458

www.dammonengineering.com
info@dammonengineering.com
PH: 985.649.5832

REVISIONS

#	DESCRIPTION	DATE
1		

SEAL:

STATE OF LOUISIANA
BRIAN A. MISTICH
License No. 30187
9/7/2023
PROFESSIONAL ENGINEER

NEW PRESS BOX
SALMEN HIGH SCHOOL
300 SPARTAN DRIVE
SLIDELL, LA. 70458

JOB No: 2458 DATE: 07-14-2022
DRAWN BY: CKD CHECKED BY: BAM

This drawing and specifications, design and arrangements represented herein as an and shall remain the property of Dammon Engineering, and no part thereof shall be used, copied or assigned to any other person or firm without written consent of Dammon Engineering. Prior to commencement of work, the contractor shall verify all dimensions and conditions of the job and report any discrepancies to Dammon Engineering. Failure to do so shall be at contractor's own risk and expense.

SHEET TITLE:
PARTIAL SITE PLAN

DRAWING NUMBER:
C101

SHEET No: 2 of 7