AS-BUILT

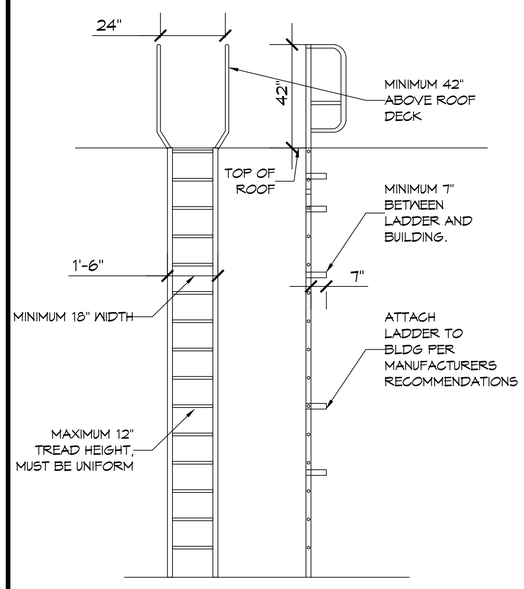


a LADDER
SCALE: 1/8"= 1'-0"

F PERSONNEL LADDER
SCALE: 1/8"= 1'-0"

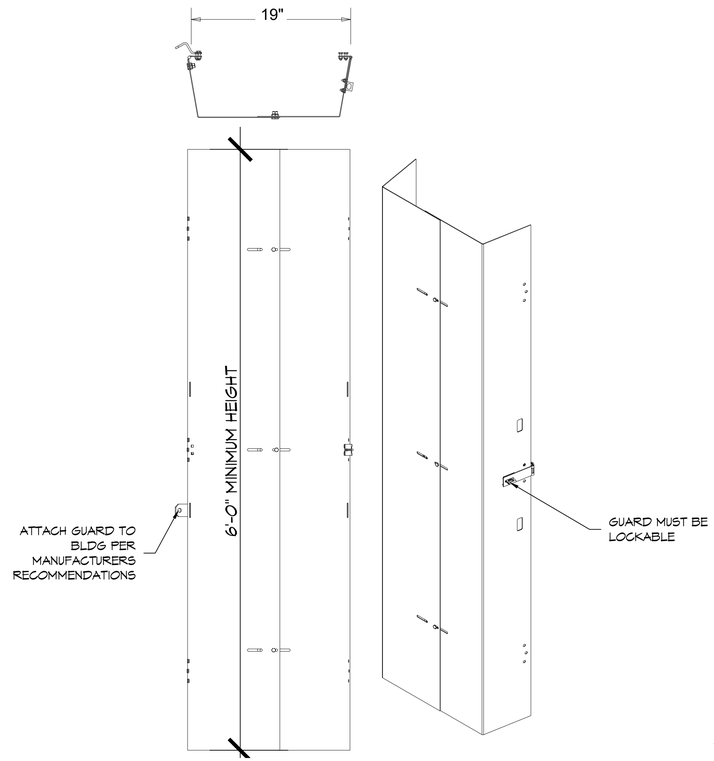


b SECURITY LADDER GUARD
SCALE: 1/8"= 1'-0"

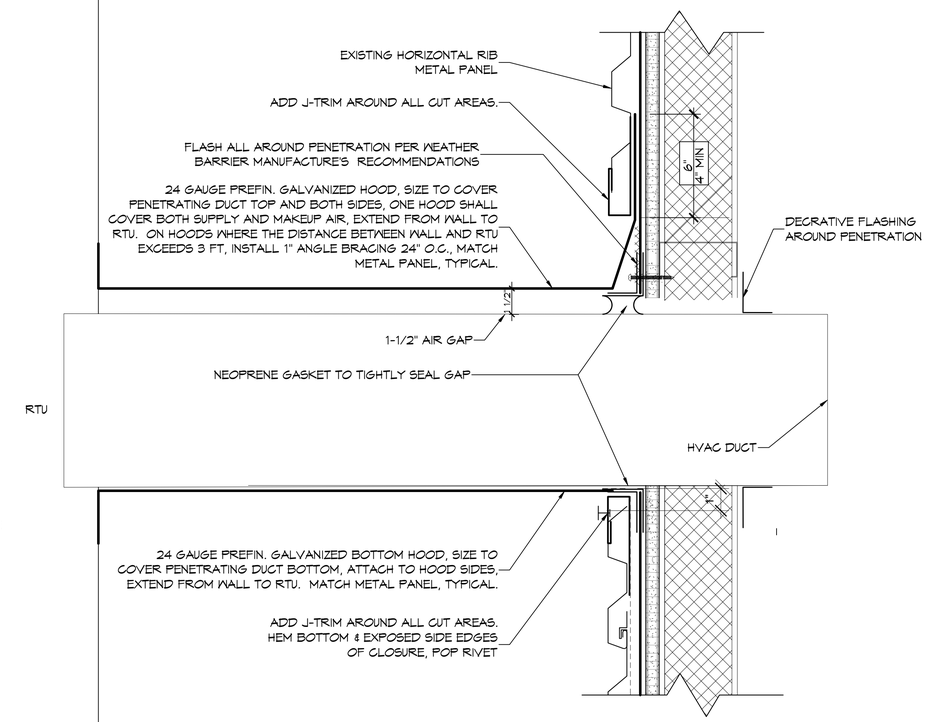


G METAL PANEL WALL PENETRATION, TYPICAL
SCALE: 1/8"= 1'-0"


DAMMON ENGINEERING, INC.
LOUISIANA & MISSISSIPPI
Chief Engineer: Brian Mistich, PE
554 Old Spanish Trail
Slidell, LA 70458
www.dammonengineering.com
info@dammonengineering.com
PH: 985.649.5832


REVISIONS

| # | DESCRIPTION | DATE |
|---|---|---|

SEAL:

STATE OF LOUISIANA
BRIAN A. MISTICH
License No. 30187
12/29/2023
PROFESSIONAL ENGINEER

MECHANICAL RENOVATIONS
BOYET JUNIOR HIGH SCHOOL
5429S Rebel Dr.
Slidell, LA 70461

| | | | |
|---|---|---|---|
| JOB No: | 2468 | DATE: | 12-29-2023 |
| DRAWN BY: | CKD | CHECKED BY: | BAM |

SHEET TITLE:
DETAILS

DRAWING NUMBER:
M102

SHEET No: 7 of 9