

Contact Tim (985) 966-3093 PPO


drop ceiling
 11'-0" dim
 Any obstructions above ceiling
 Bar Joist 12m to wall
 6" x 12" x 6"

10'-0" dim
 FIR to deck

33 1/2" Both
 154.5"

dim. 12'-8"

FIR to Deck
 154.5"

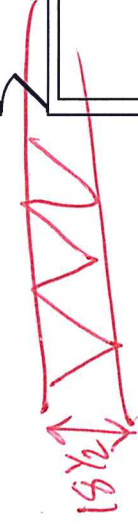


5'-12"

26'-8" dim

Is this a wet wall? (yes)
 Are blocks hollow? (yes)

Any obstructions above ceiling

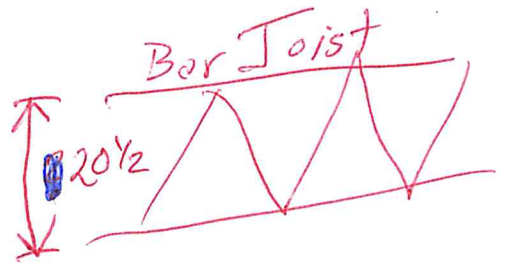

Dim Floor to Undergird + Roof deck

FIR to Roof
 154.5" Same both sides