LEGEND

(hatched box)	DEMO EQUIPMENT AND ELECTRICAL

DEMO NOTES

1. EXISTING CONDUIT AND WIRE IN FLOOR SLAB TO BE REUSED
2. TRACE OUT CONDUIT AND WIRE AND REMOVE BACK TO SOURCE. REMOVE WIRE FROM BREAKER AND LABEL AS SPARE.
3. EXISTING GYM PANEL SHALL BE REPLACED.
4. WHEN DEMO-ING THE AHU'S IN GYM, REMOVE ALL SUPPORTS, FREON TUBING, CONDUITS, AND WIRING.

DEMO GENERAL NOTES

CUT, PATCH, REPAIR AND TOUCH-UP PAINT IN AREAS WHERE DEMO'D EQUIPMENT HAS BEEN REMOVED. PAINT SHALL MATCH EXISTING SURFACES SURROUNDING THE REMOVED EQUIPMENT.

Addendum #1 - Change note #2 to read : "Trace out Conduit and Wire, remove wire back to source. Remove wire from breaker and label breaker as spare. If conduit cannot be re-used, install Junction Box at end of run. Seal any penetrations through exterior walls"

Addendum #1 - Change note #3 to read : "Existing GYM Panel shall be repaired per the Electrical plans."

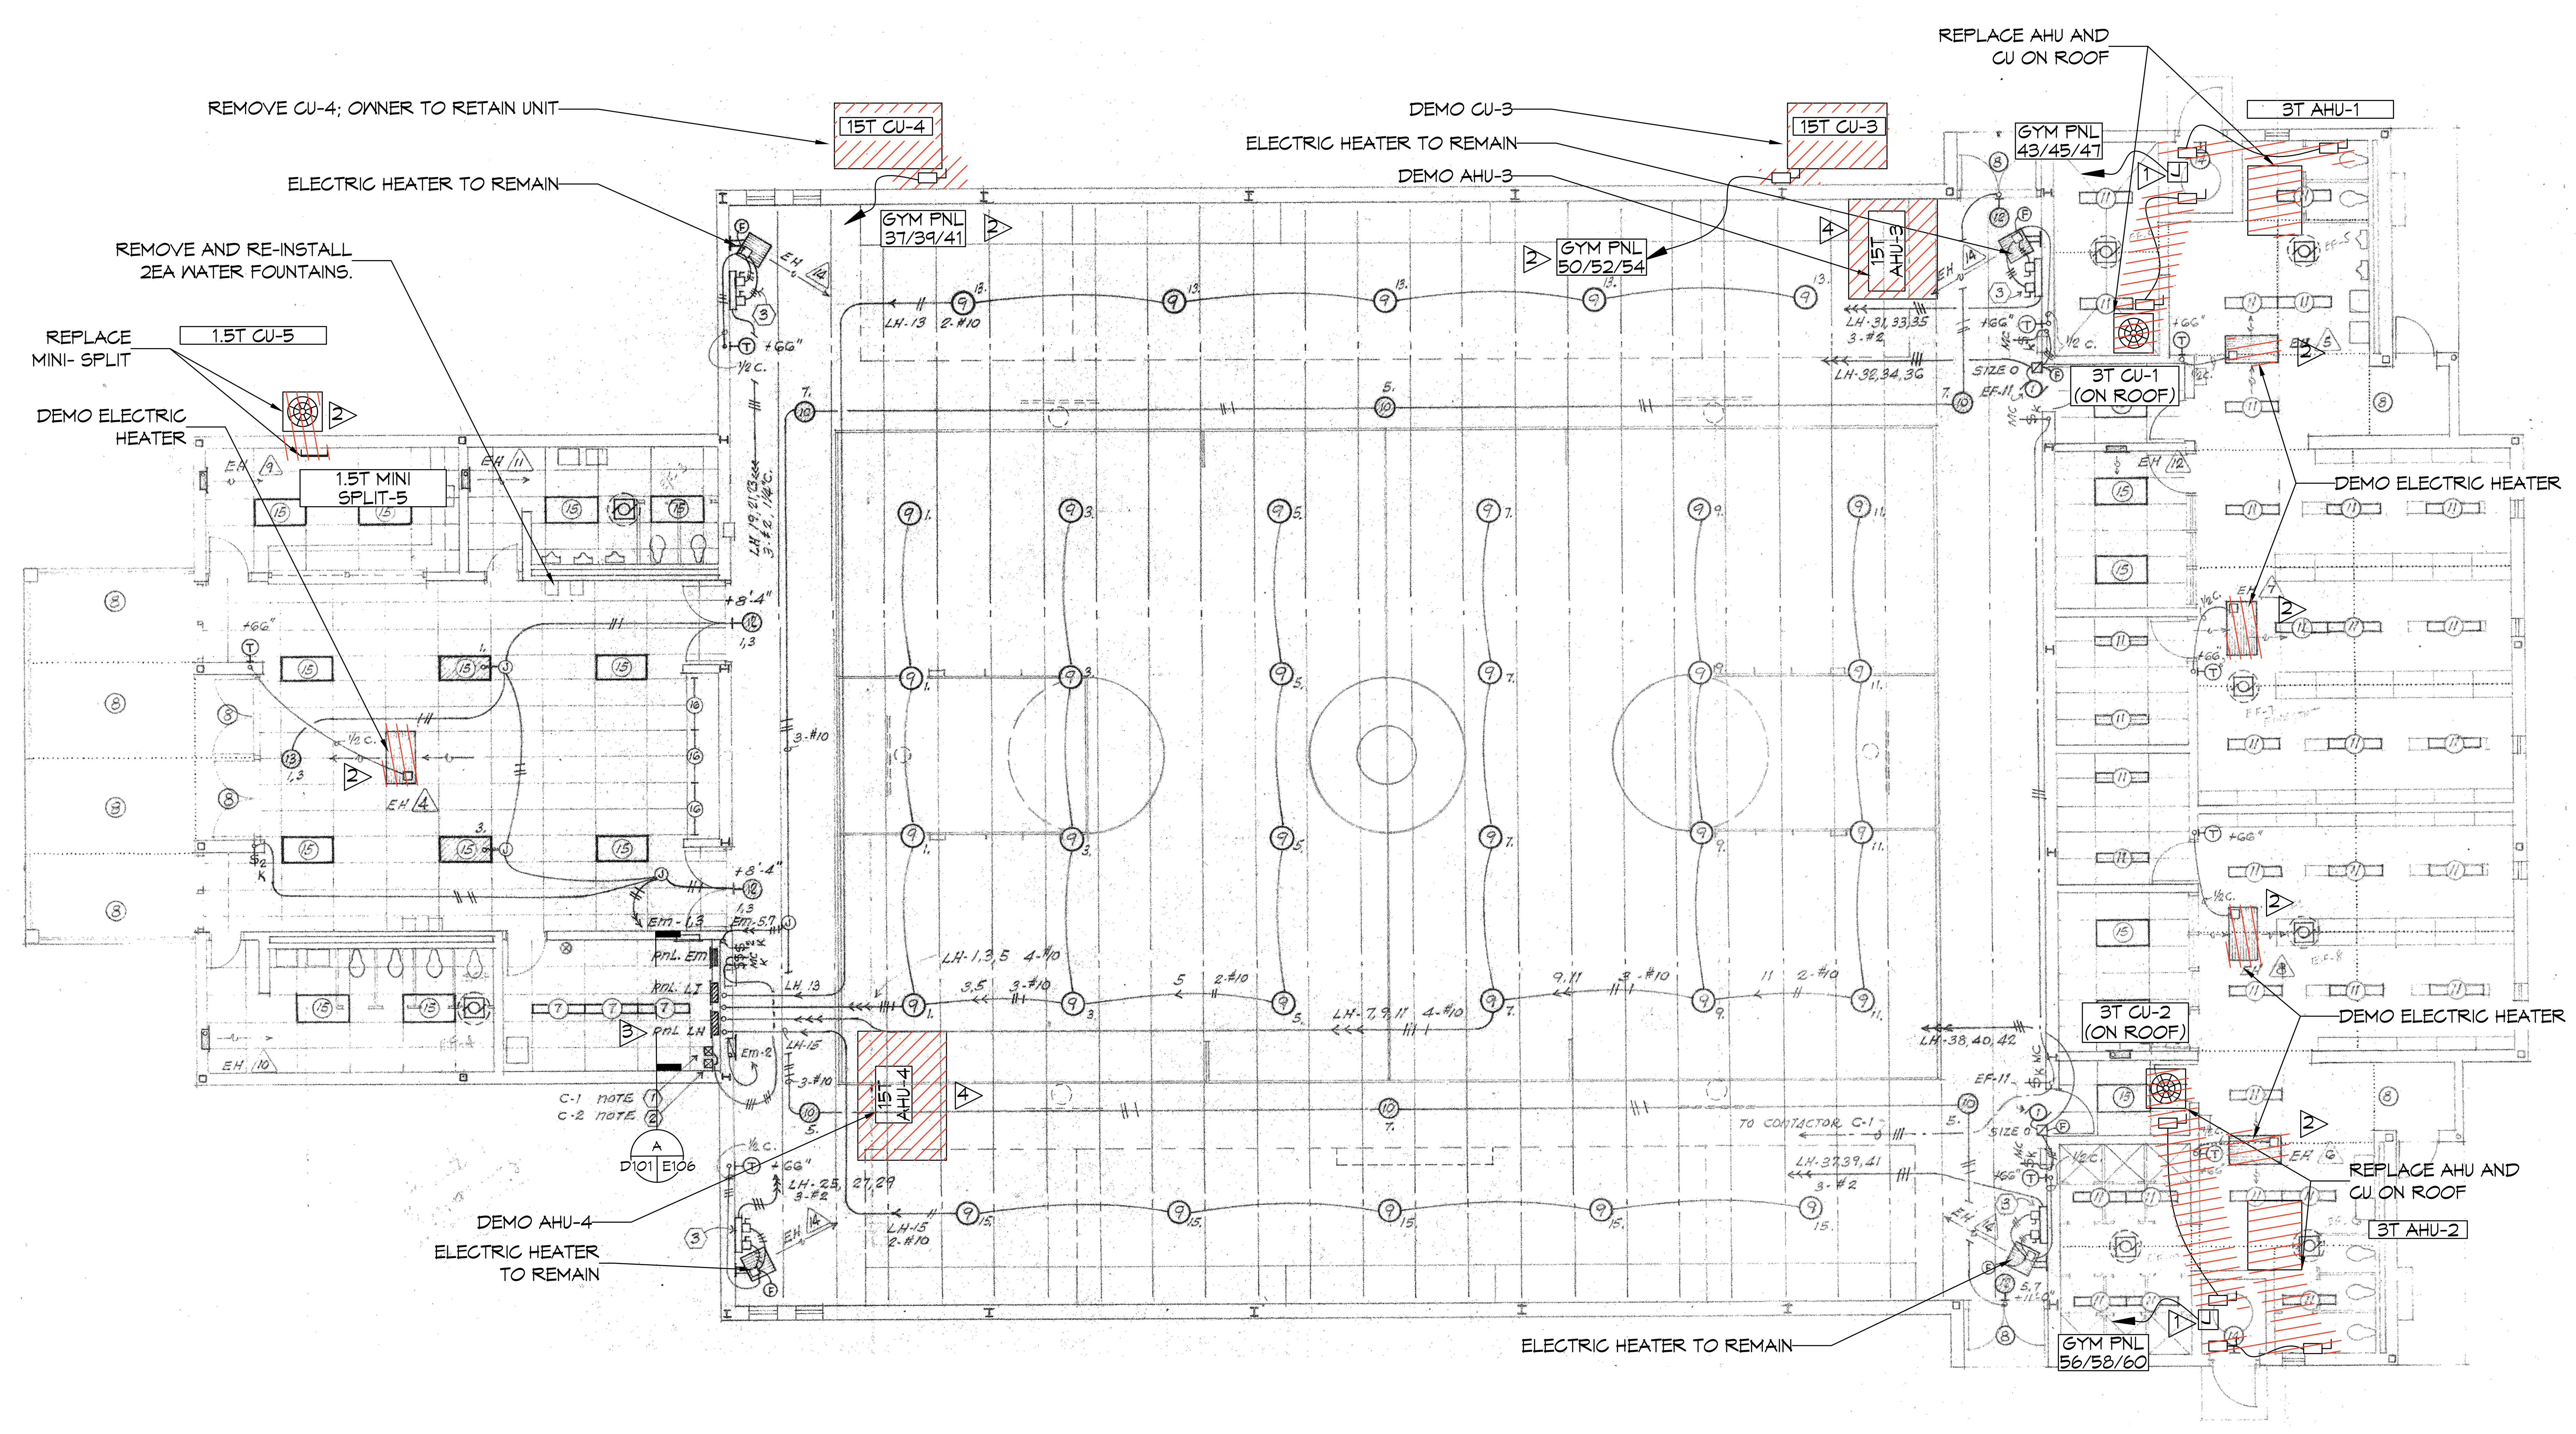

1 DEMO PLAN
SCALE: 1/8"= 1'-0"

DAMMON ENGINEERING, INC.
LOUISIANA & MISSISSIPPI
Chief Engineer: Brian Mistich, PE
554 Old Spanish Trail
Slidell, LA 70458
www.dammonengineering.com
info@dammonengineering.com
PH: 985.649.5832

#	DESCRIPTION	DATE
	REVISIONS	

SEAL: STATE OF LOUISIANA — BRIAN A. MISTICH — License No. 30187 — PROFESSIONAL ENGINEER — 12/29/2023

MECHANICAL RENOVATIONS
BOYET JUNIOR HIGH SCHOOL
59295 Rebel Dr.
Slidell, LA 70461

JOB No:	2468	DATE:	12-29-2023
DRAWN BY:	CAD	CHECKED BY:	BAM

SHEET TITLE: DEMO PLAN

DRAWING NUMBER: D101

SHEET No: 2 of 9