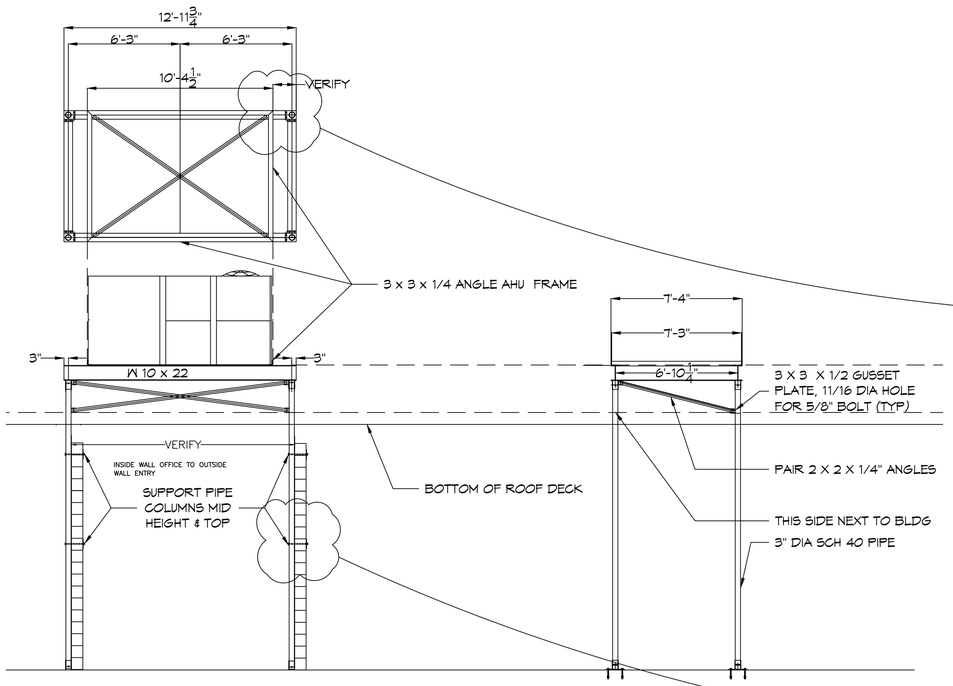

3 RTU-2
SCALE: 1/4"= 1'-0"

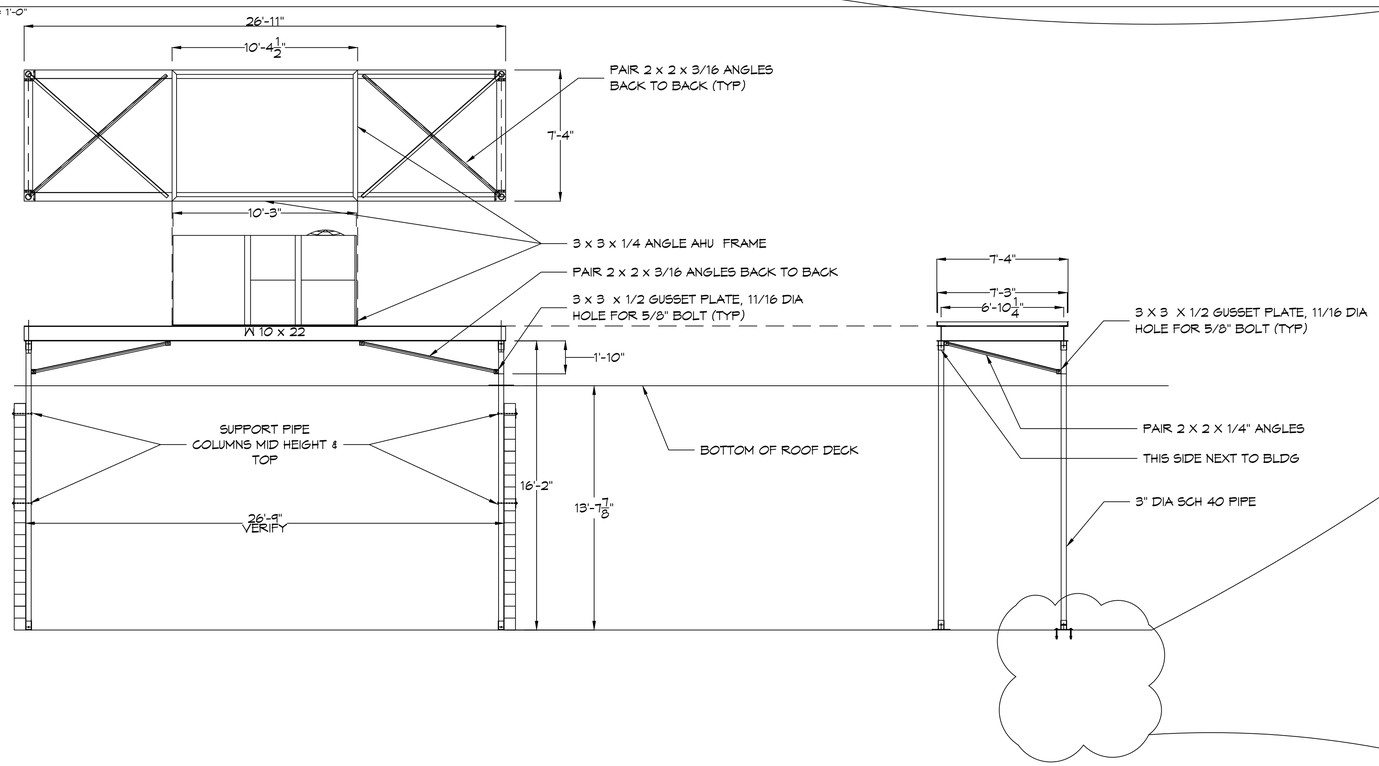

3 RTU-1
SCALE: 1/4"= 1'-0"

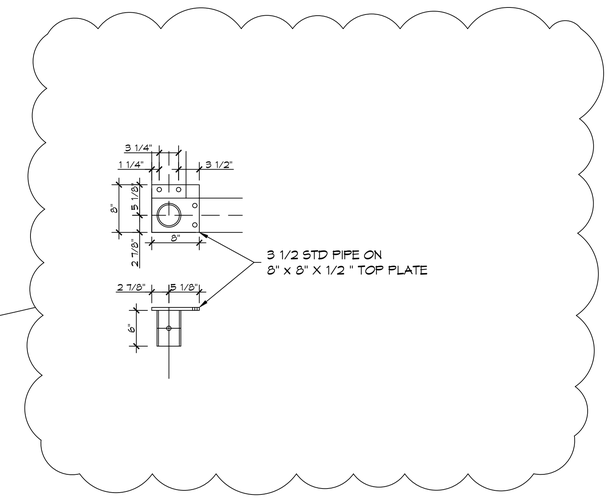

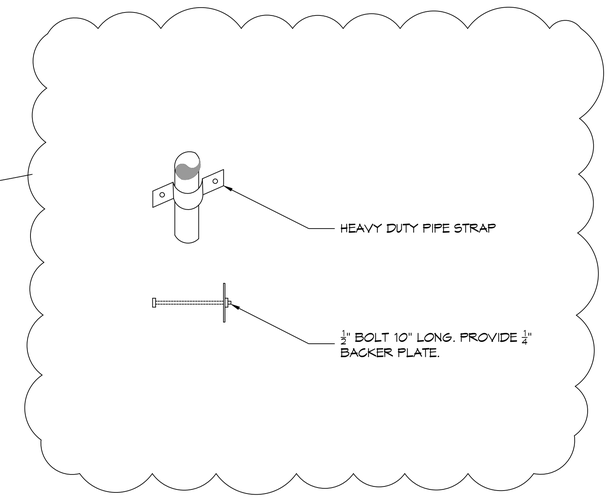

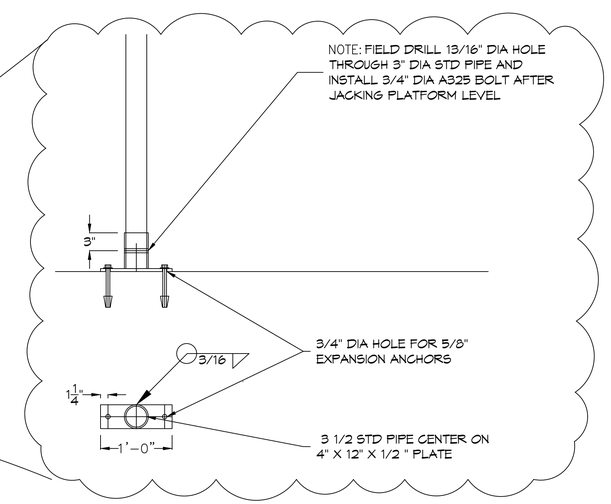

DAMMON ENGINEERING, INC.
LOUISIANA & MISSISSIPPI
www.dammonengineering.com
info@dammonengineering.com
PH: 985.649.5832
Chief Engineer: Brian Mistich, PE
5540 Crosswalk Trail
Slidell, LA 70458

#	DESCRIPTION	DATE

REVISIONS

SEAL:

MECHANICAL RENOVATIONS
BOYET JUNIOR HIGH SCHOOL
9425 Rebel Dr.
Slidell, LA 70461

JOB No:	2469	DATE:	12-1-2022
DRAWN BY:	CKD	CHECKED BY:	BAM

THIS DRAWING IS THE PROPERTY OF DAMMON ENGINEERING, INC. REPRODUCTION OR USE FOR OTHER THAN THE PROJECT SHOWN HEREON IS PROHIBITED WITHOUT WRITTEN CONSENT. THIS DRAWING IS THE PROPERTY OF DAMMON ENGINEERING, INC. AND MUST BE RETURNED ON REQUEST. THIS DRAWING WAS PREPARED FOR THE PROJECT SHOWN HEREON AND MAY NOT BE USED ON OTHER PROJECTS. THE RECEIPT OF THIS DRAWING BY ANOTHER PERSON OR ORGANIZATION DOES NOT CONSTITUTE A GRANT OF PATENT, LICENSE OR OTHER RIGHT.

SHEET TITLE:
STRUCTURAL DETAILS

DRAWING NUMBER:
S102

SHEET No: 2 of 7