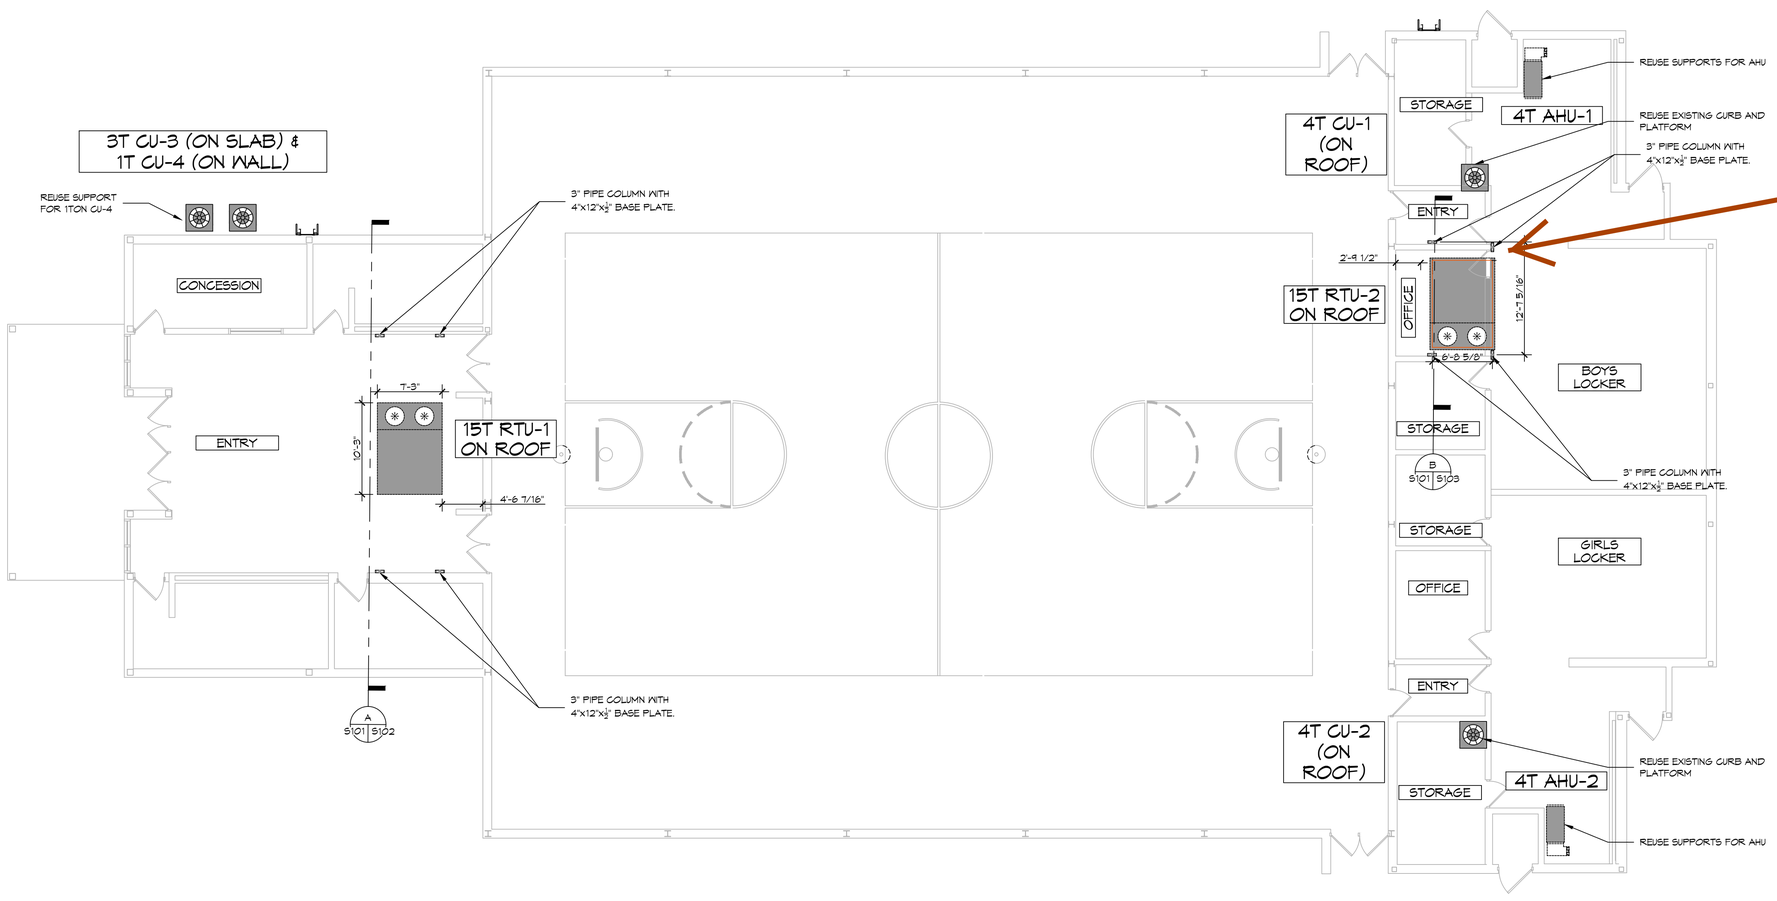

Had to change location.
The door would hit the column

1 STRUCTURAL PLAN
SCALE: 1/8" = 1'-0"

DAMMON ENGINEERING, INC.
LOUISIANA & MISSISSIPPI

Chief Engineer: Brian Mistich, PE
5540 Oak Lawn Trail
Slidell, LA 70458
www.dammonengineering.com
info@dammonengineering.com
PH: 985.649.5832

REVISIONS

#	DESCRIPTION	DATE

SEAL:

MECHANICAL RENOVATIONS
BOYET JUNIOR HIGH SCHOOL
54295 Rebel Dr.
Slidell, LA 70461

JOB No:	2463
DATE:	3-7-2023
DRAWN BY:	CKD
CHECKED BY:	BAM

The drawings and specifications contained herein are the property of Dammon Engineering, and shall not be reproduced or used for any purpose other than that for which they are specifically prepared and delivered, and shall remain the property of Dammon Engineering, and no property right shall be created or conveyed by the delivery of the drawings and specifications. Reproduction of these drawings and specifications, in whole or in part, is prohibited without written consent of Dammon Engineering. Dammon Engineering shall not be responsible for any modifications made to these drawings and specifications by others.

SHEET TITLE:
STRUCTURAL PLAN

DRAWING NUMBER:
S101

SHEET No: 3 of 9