


Contact Tim
 (985) 966-3093
 Todd



HOME VISITOR
POINTS PERIOD POINTS
POWERADE Diet Coke

BOYET JUNIOR HIGH

16'-8 1/2"

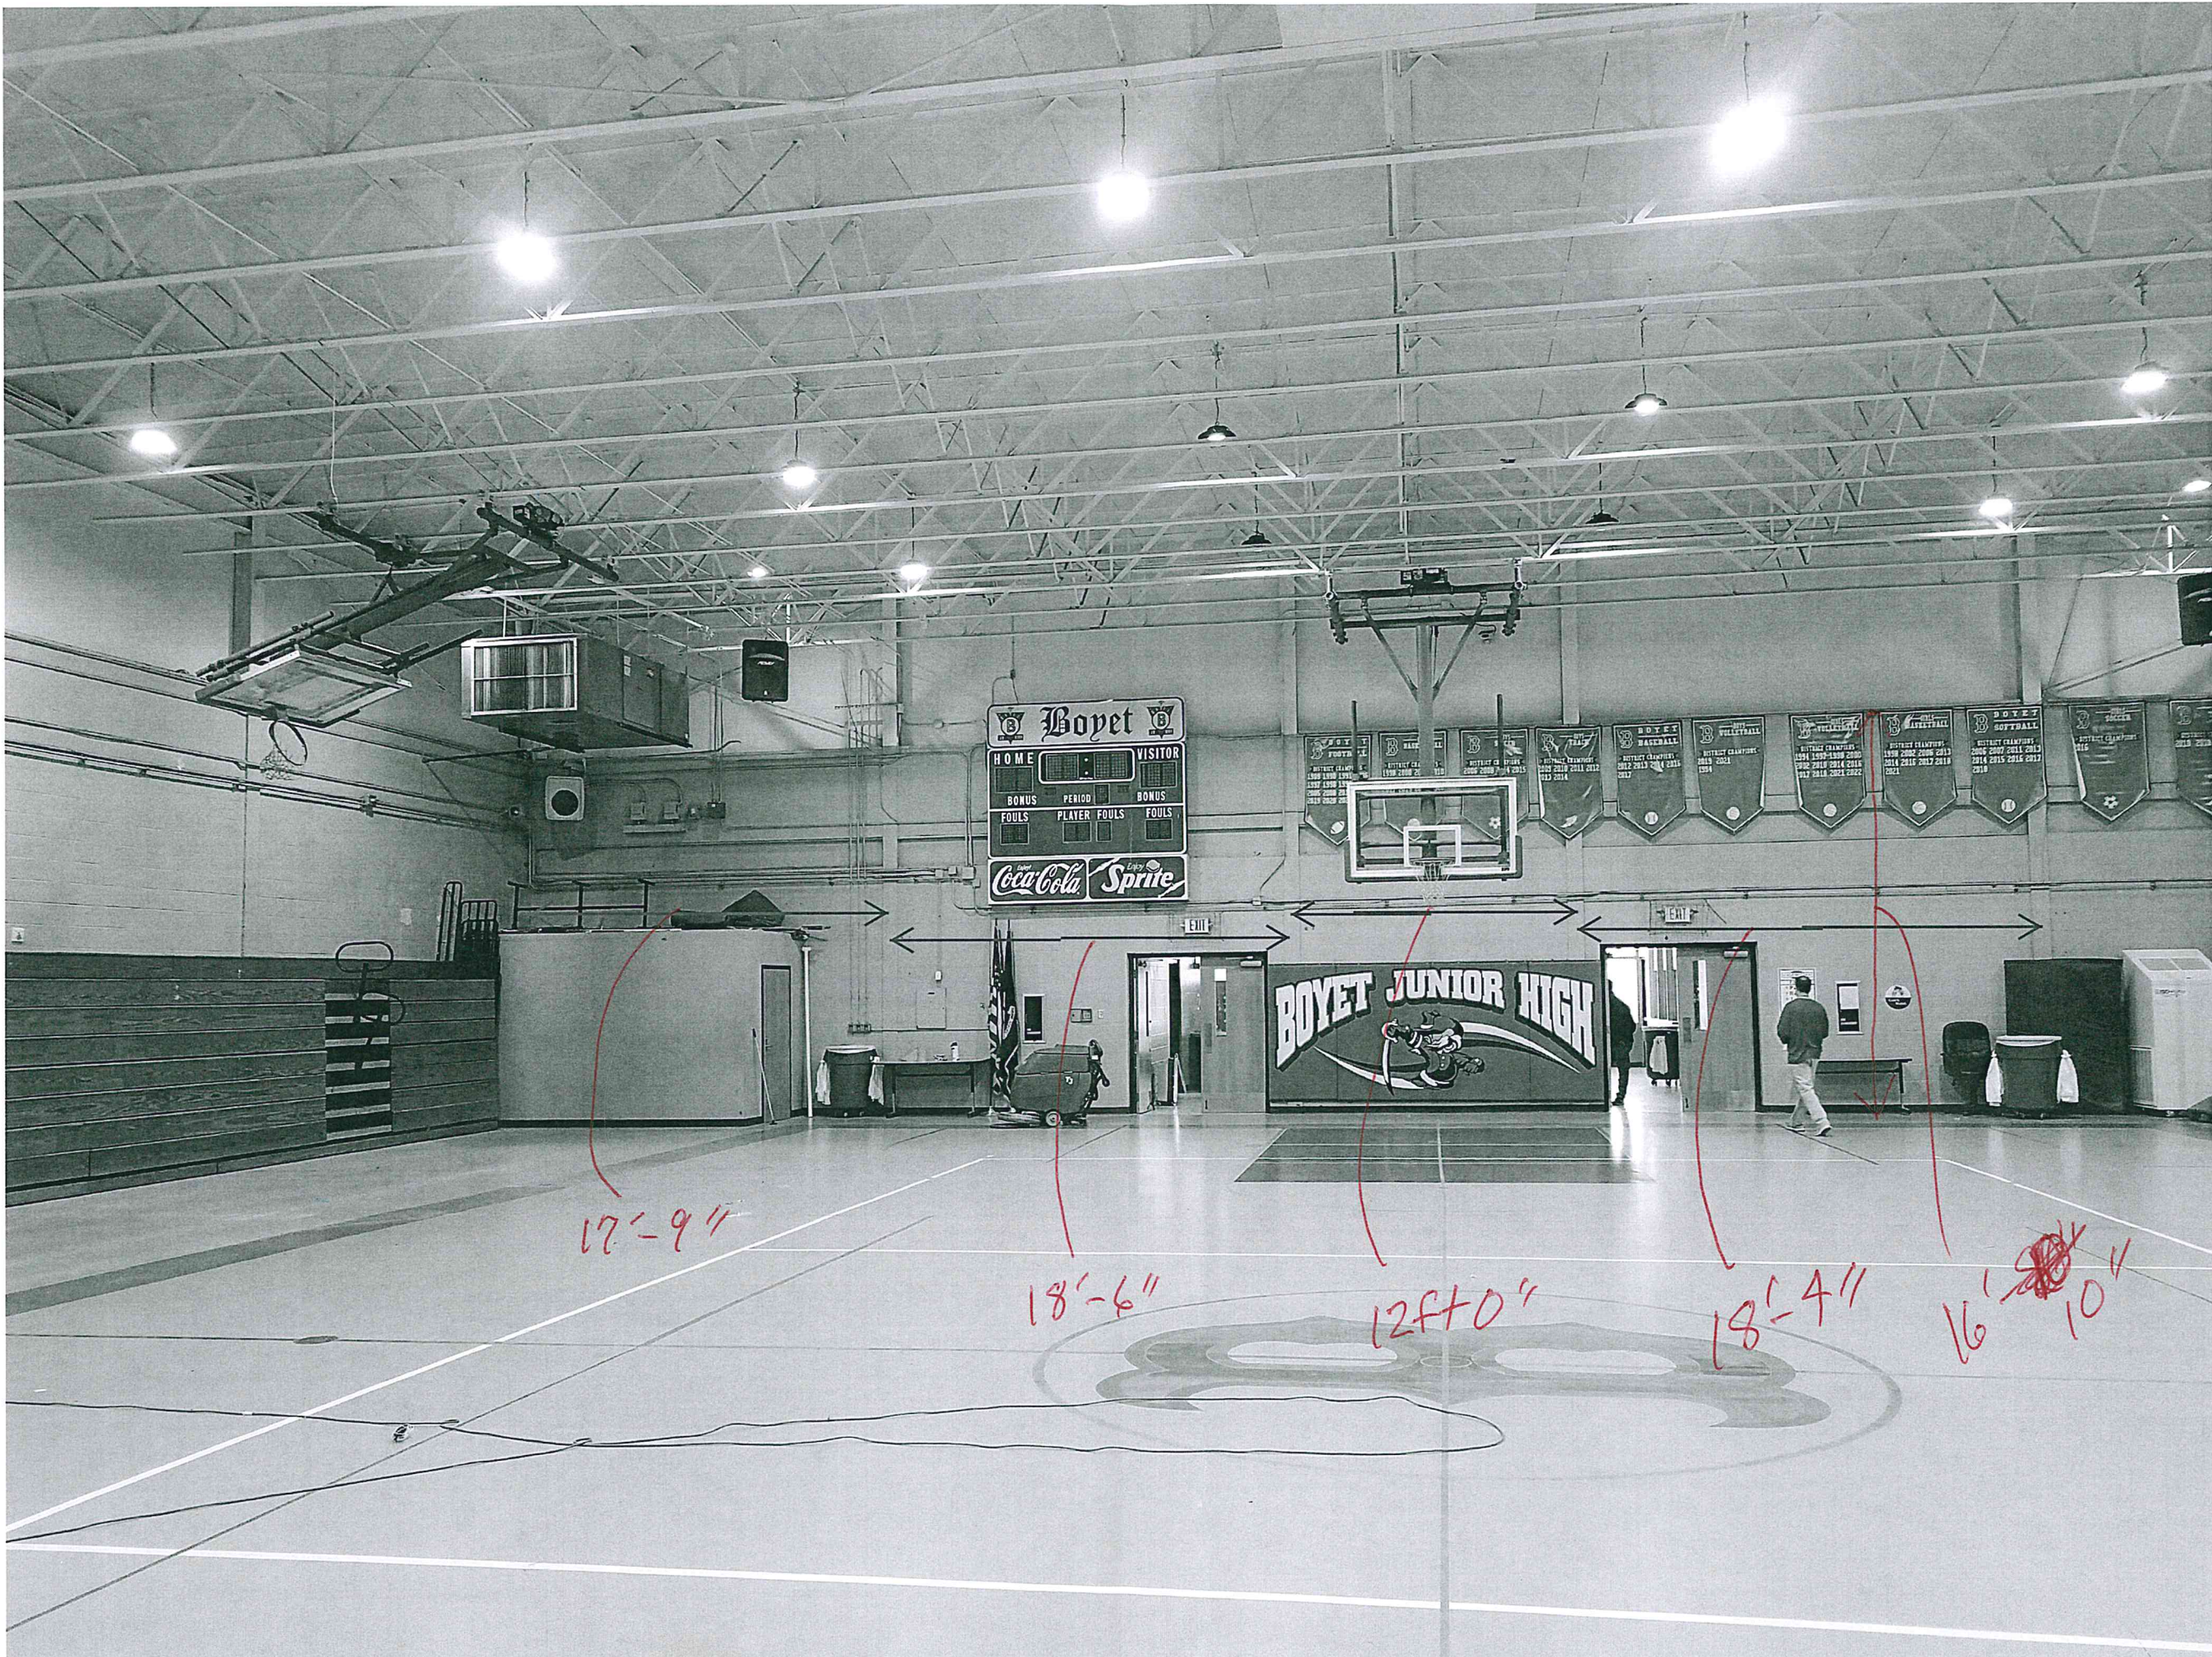

Boyet

HOME	VISITOR	
BONUS	PERIOD	BONUS
FOULS	PLAYER FOULS	FOULS

Coca-Cola Sprite

BOYET JUNIOR HIGH

17'-9"

18'-6"

12ft 0"

18'-4"

16' ~~10~~ 10"