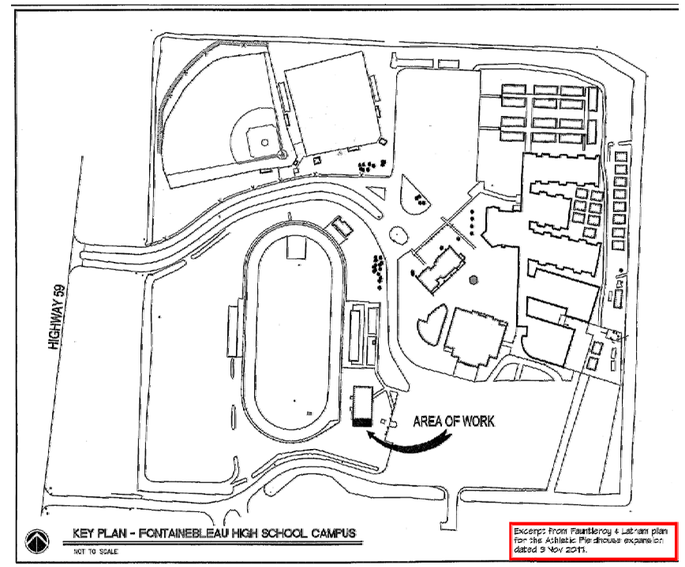

KEY PLAN - FONTAINEBLEAU HIGH SCHOOL CAMPUS
NOT TO SCALE

Excerpt from Fauntleroy & Latham plan for the Athletic Fieldhouse expansion dated 9 Nov 2011.

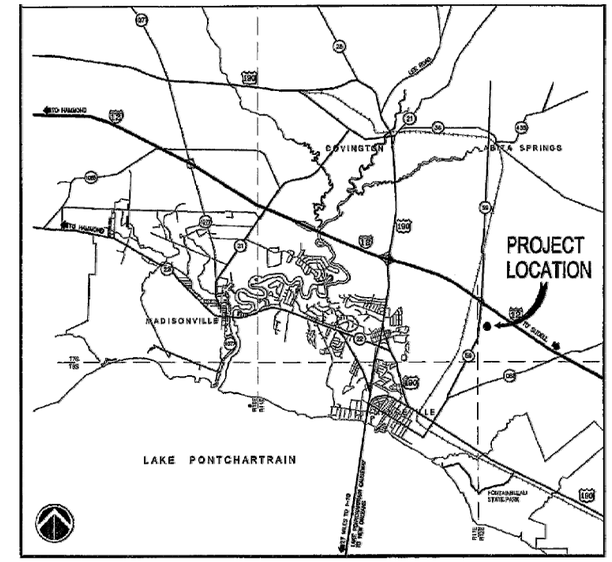

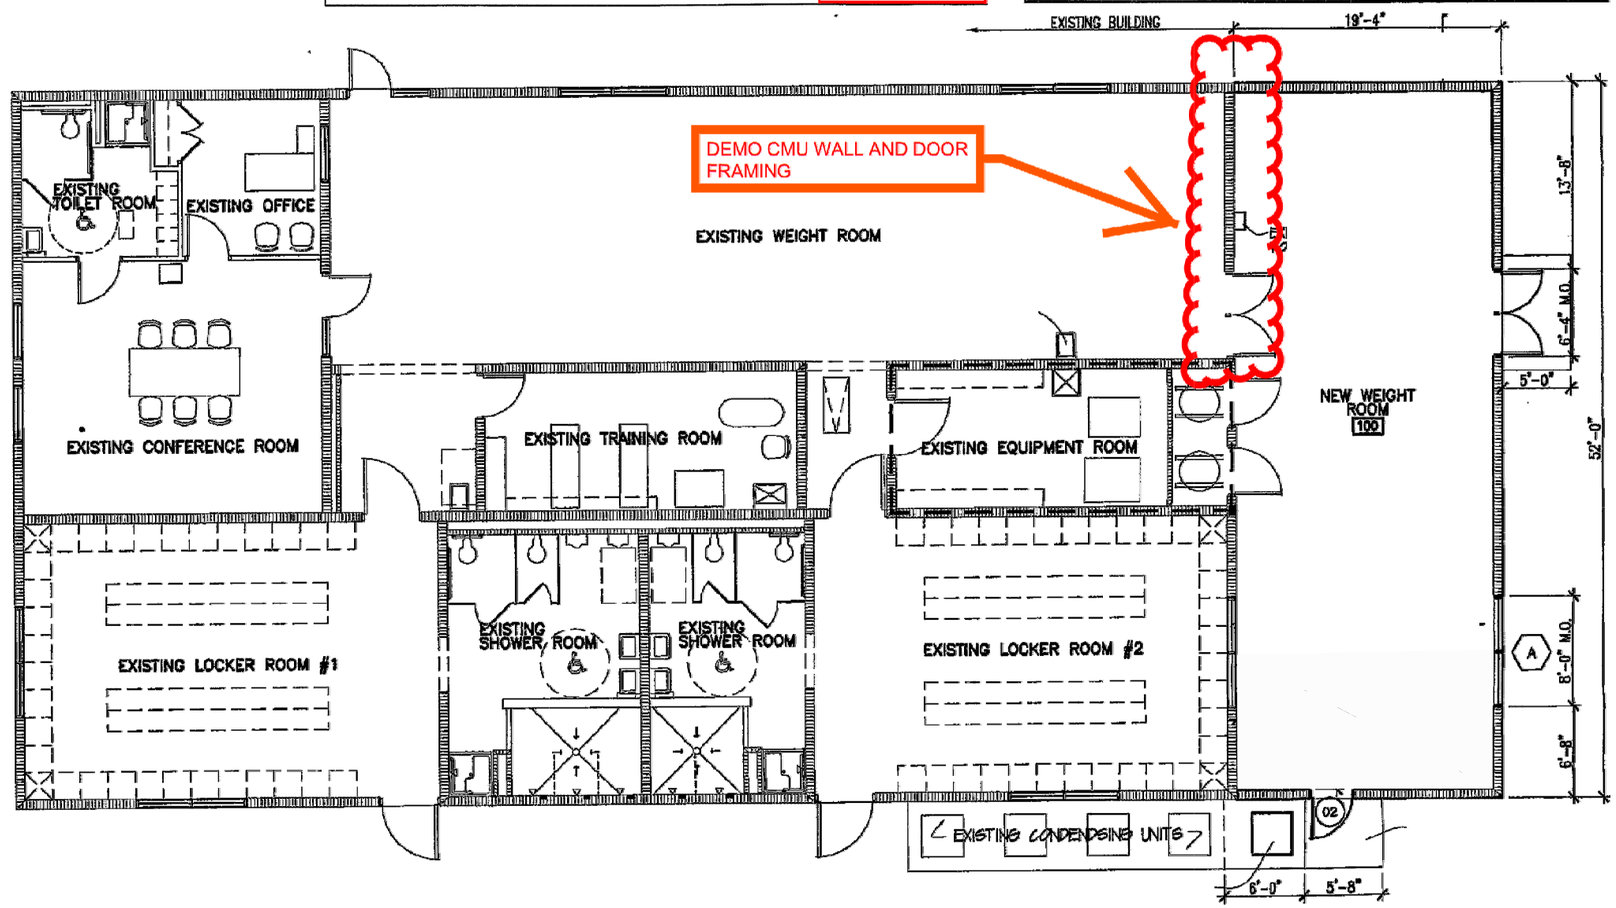

1 A2.1 FLOOR PLAN

SCALE: 1/8" = 1'-0"

Excerpt from Fauntleroy & Latham plan for the Athletic Fieldhouse expansion dated 9 Nov 2011.

DAMMON ENGINEERING, INC.
LOUISIANA & MISSISSIPPI

www.dammonengineering.com
info@dammonengineering.com
PH: 985-649-3832

Chief Engineer: Brian Alstich, PE
150 Oakridge Trail
Slidell, LA 70458

#	DESCRIPTION	DATE

REVISIONS

SEAL:

CMU WALL DEMO & NEW BEAM

Fontainebleau High Field House Locker Room

100 Bulldog Dr.
Mandeville, LA 70471

STPSB PO:	P0248	DATE:	10.29.2018
DRAWN BY:	CPD	CHECKED BY:	BAM

SHEET TITLE:

DRAWING NUMBER:

CS-1

SHEET No: #1 of #1